

PREPARED FOR
ANDY SCHMIDT
KEEFE REAL ESTATE
751 GENEVA PARKWAY
LAKE GENEVA WI. 53147



PLAT OF SURVEY

- OF -

PATHFINDER SURVEYING INC.
(formerly)
J.K. SURVEYING INC.
P.O BOX 322
LAKE GENEVA, WI. 53147
WWW.PATHFINDERSURVEYING.NET
262-248-8303

LOTS 12 AND 13 BLOCK 3, SUNSET HILLS, A SUBDIVISION LOCATED
IN SECTION 4, TOWN 1 NORTH, RANGE 17 EAST, TOWN OF LINN,
COUNTY OF WALWORTH AND STATE OF WISCONSIN.

EAST ROAD

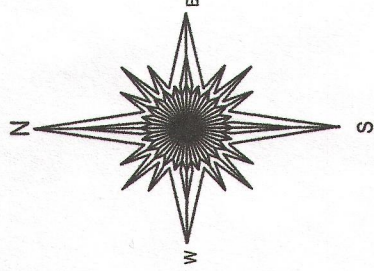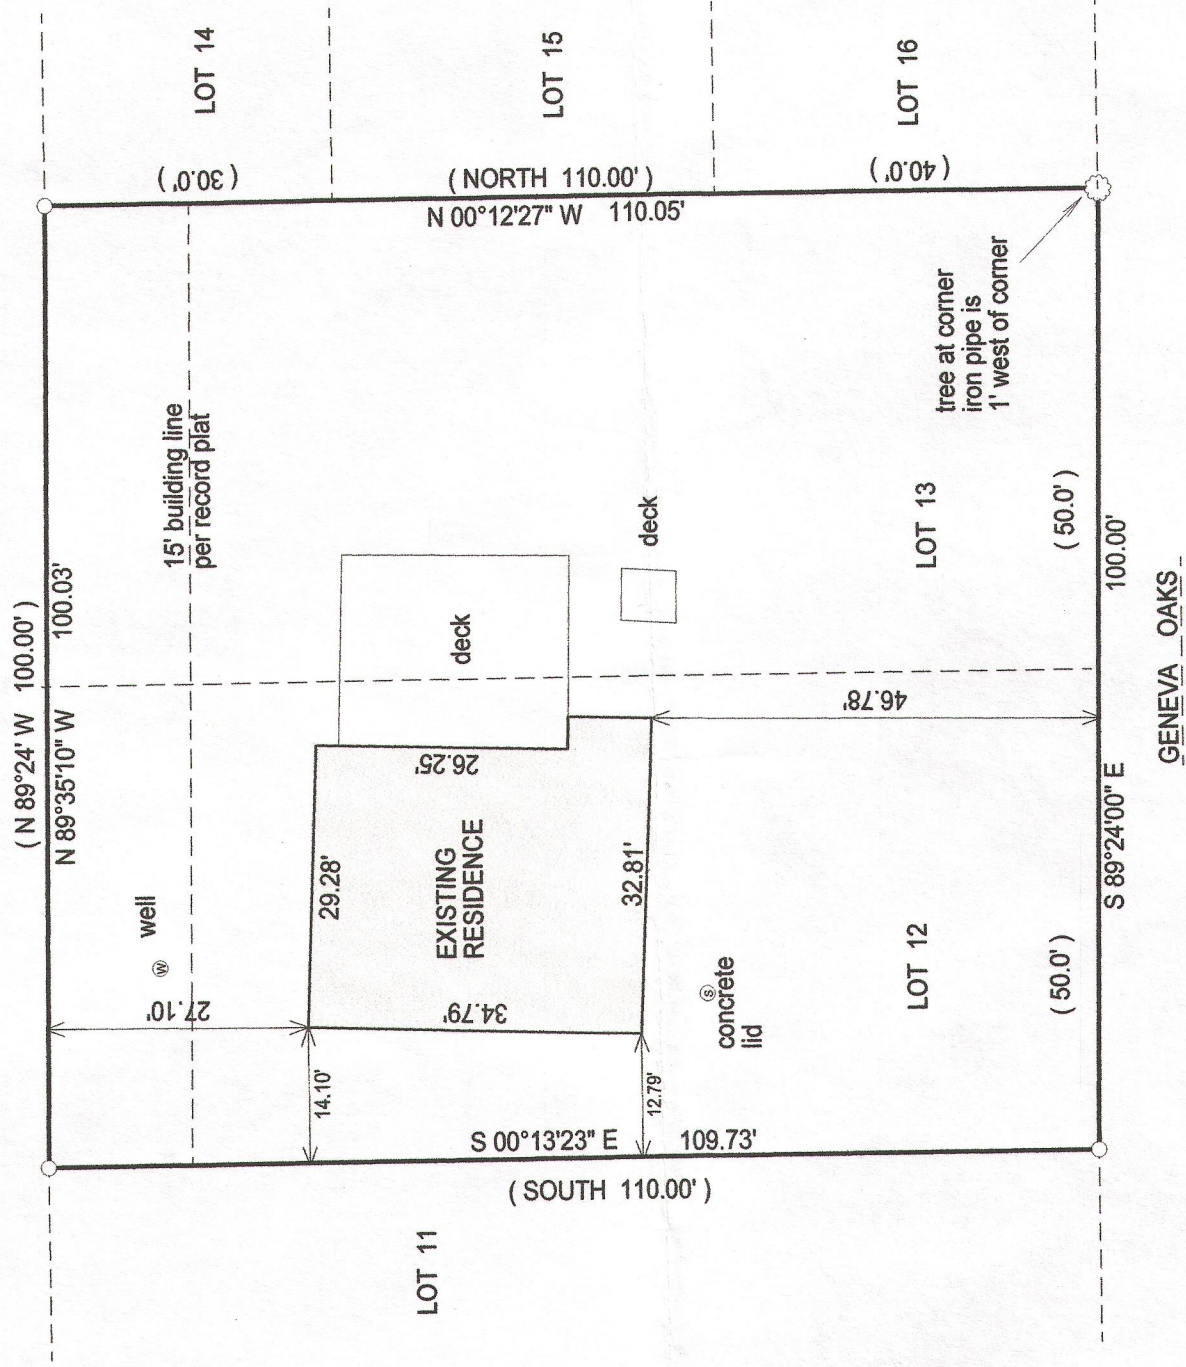

- () = recorded as
- = found iron bar
- = found iron pipe
- = set iron pipe
- = set iron bar

SCALE 1" = 20'

JOB # 13-101

TAX ID # ISH 00034

BASIS OF BEARING OF THIS PLAT: THE SOUTH LINE OF
BLOCK 3 SUNSET HILLS WAS ASSUMED TO BEAR S89°24'E AS
SHOWN ON THE RECORD PLAT.

I hereby certify that I have surveyed the above- described property and the
above map is a true representation thereof and shows the size and
location of the property, its exterior boundaries, the location and
dimensions of all structures thereon, fences, apparent easements and
roadways and visible encroachments if any.

This survey is made for the present owners of the property, and those who
purchase, mortgage, or guarantee the title thereto, within one year from
the date hereof.

DATED THIS 2ND DAY OF JUNE, 2013.



JEFFREY L. KIMPS S - 2436
Wisconsin Registered Land Surveyor
(original if signed in red)

117-3583