


PREPARED FOR:
MATUSTIK BUILDERS
2413 W. ALGONQUIN RD.
SUITE 515
ALGONQUIN, IL 60102

PLAT OF SURVEY

KROTT SURVEYING INC.
N3705 WILLOW BEND LANE
LAKE GENEVA WI. 53147
PHONE # (262)248-3697
FAX # (262)249-0639

-OF-
LOTS 2 AND 4, LAKE GENEVA CLUB, LOCATED IN THE NORTH 1/2 OF SECTION 18,
TOWN 1 NORTH, RANGE 17 EAST, TOWN OF LINN, WALWORTH COUNTY, WISCONSIN.

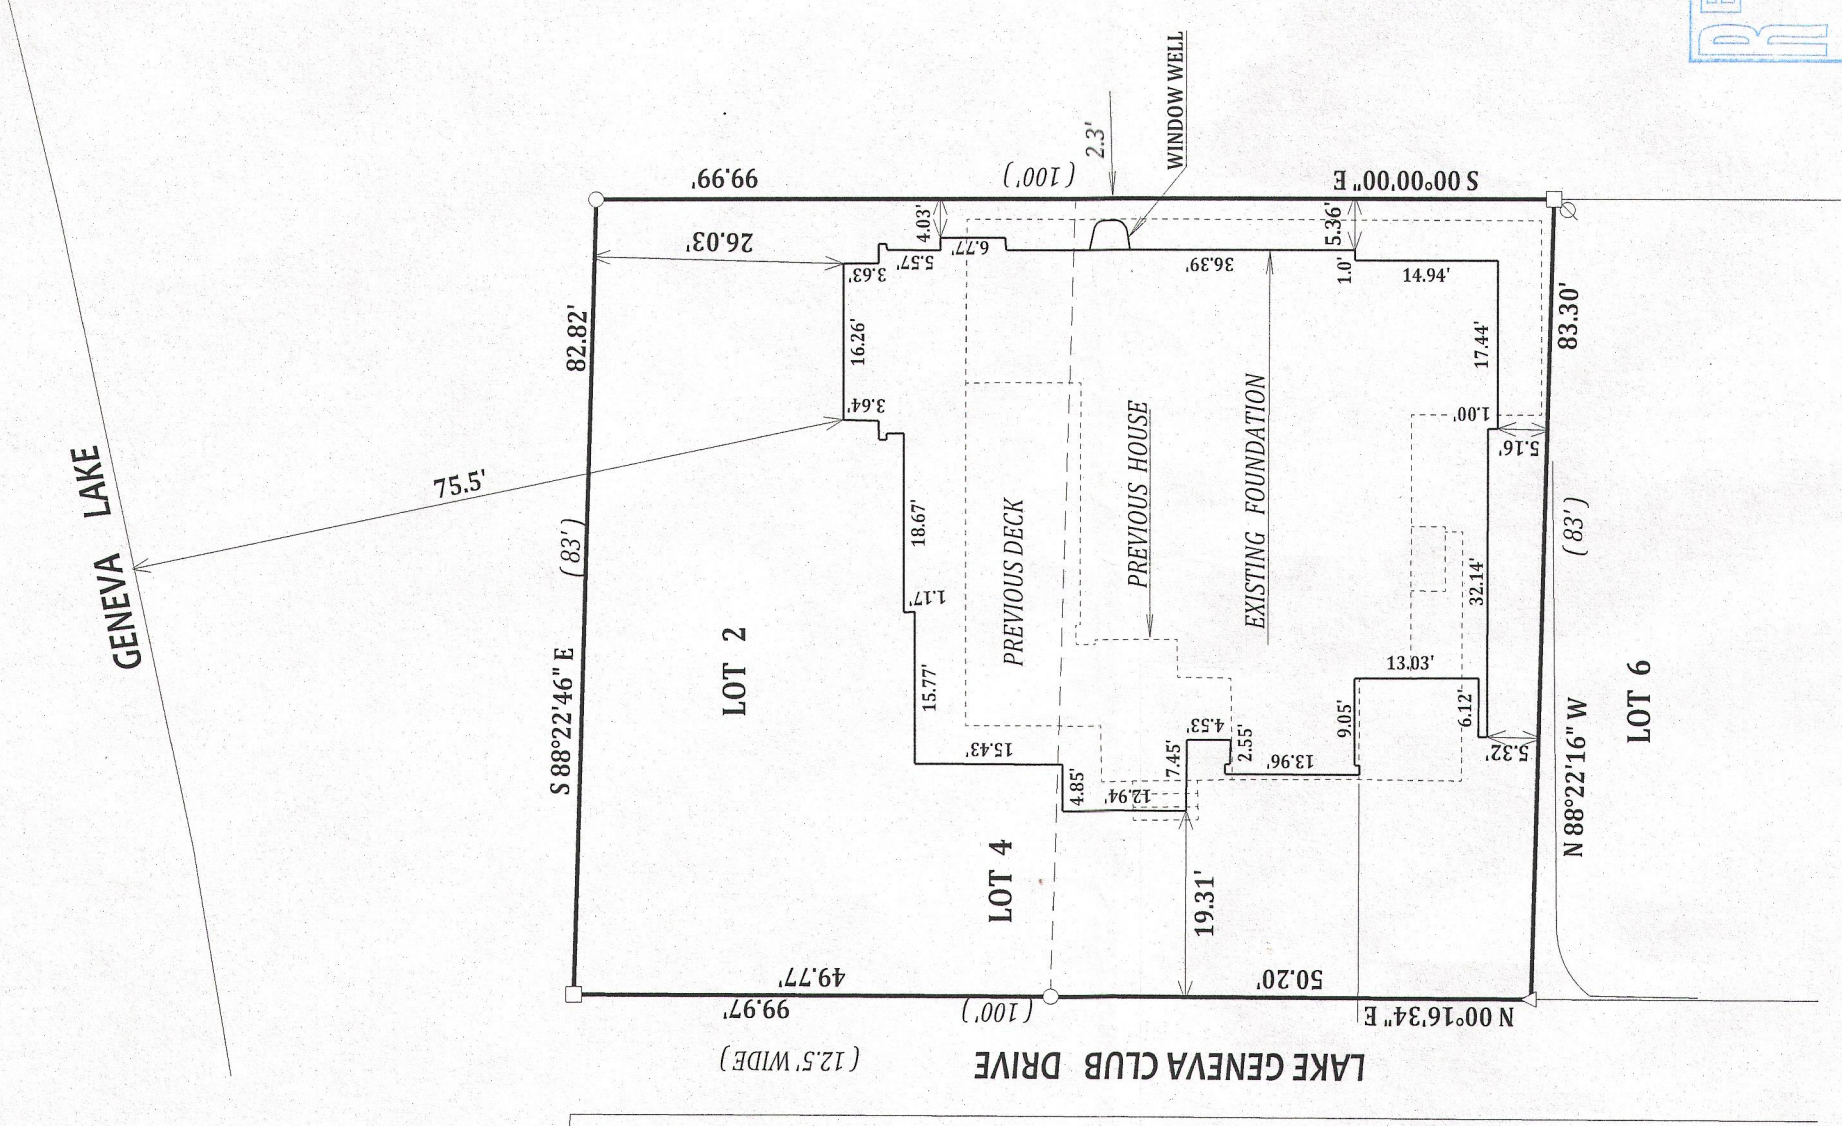


LEGEND

- FOUND IRON PIPE
- FOUND IRON BAR
- △ FOUND MAG NAIL
- Ø UTILITY POLE

(XX) RECORDED AS

TAX ID # ILGC00002

JOB # 13-089

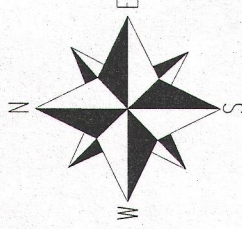


SCALE 1" = 20'



NOTE: BEARINGS ARE REFERENCED TO PREVIOUS SURVEY RECORDS

I have surveyed the above-described property and the above map is a true representation thereof and shows the size and location of the property, its exterior boundaries, the location and dimensions of all structures thereon, fences apparent easements and roadways and visible encroachments, if any.

This survey is made for the exclusive use of the present owners of the property, and also those who purchase, mortgage or insure the title thereto within one (1) year from date hereof; and as to them I warrant the accuracy of said survey map.

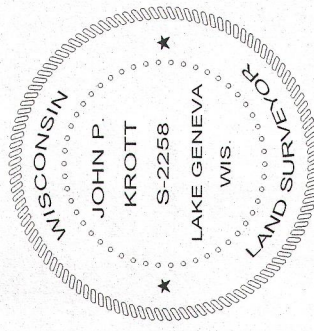

DATE OF LAST REVISION: 9 / 26 / 2013

DATED THIS 24th DAY OF JUNE 2013

John P. Krott

JOHN KROTT S-2258
Wisconsin Registered Land Surveyor
(original if signed in red)

117-3585