


GEORGE T. DUNHAM
SURVEYOR
DELAWARE, WISCONSIN

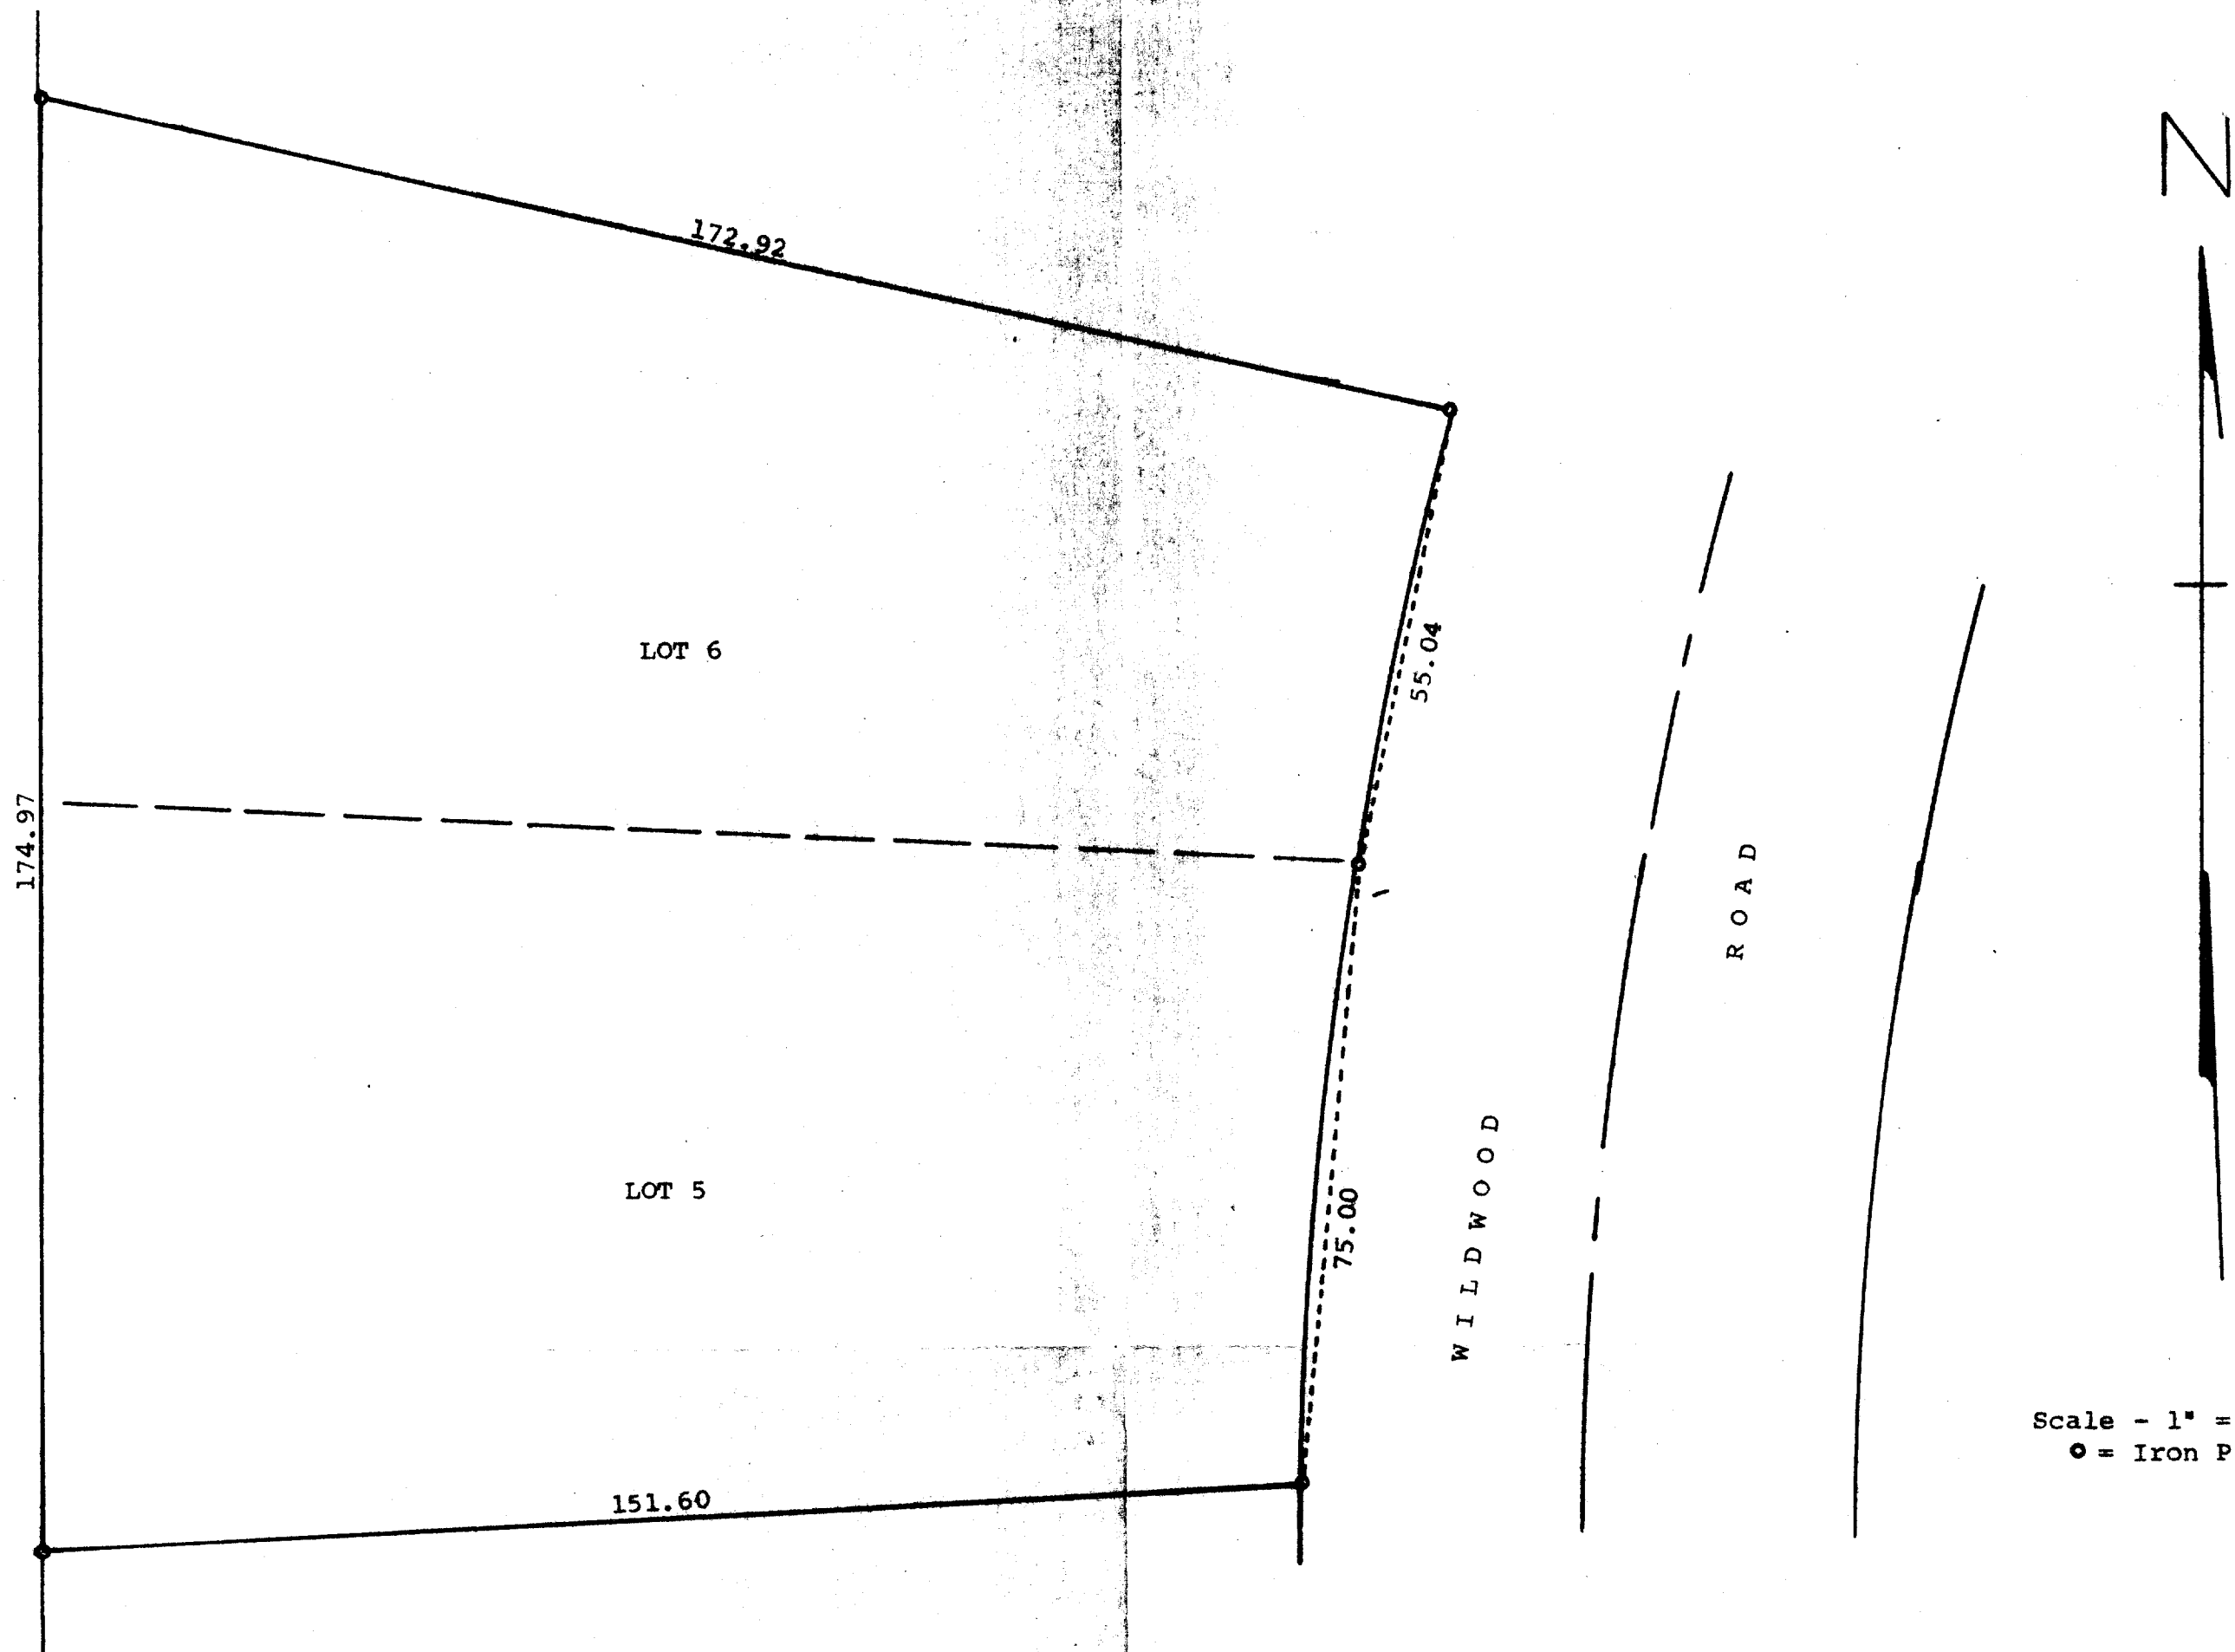

Plat of survey of Lots 5 and 6 in Block 15 of
Wooddale Addition, located in Section 16,
T 1 N, R 17 E, Walworth County, Wisconsin.
November 21, 1972

George T. Dunham
George T. Dunham, Surveyor

