

LAND-MARK SURVEYING

Mark L. Miritz

Wisconsin Registered Land Surveyor S-2582

N9330 Knuteson Drive
Whitewater, WI 53190
Phone: (262) 495-3284
FAX : (262) 495-8421
LAND-MARKSURVEYING.COM

PLAT OF SURVEY


LOT 1 AND LOT 2 OF BLOCK 8 OF SUNSET HILLS SUBDIVISION,
LOCATED IN PART OF THE NORTHWEST 1/4 OF SECTION 4,
TOWN 1 NORTH, RANGE 17 EAST, LINN TOWNSHIP,
WALWORTH COUNTY, WISCONSIN.

ORDERED BY:

MIKE PFAMMATTER
KEEFE REAL ESTATE
751 GENEVA PARKWAY
LAKE GENEVA, WI 53147

OWNER:

ROBERT ARCUS

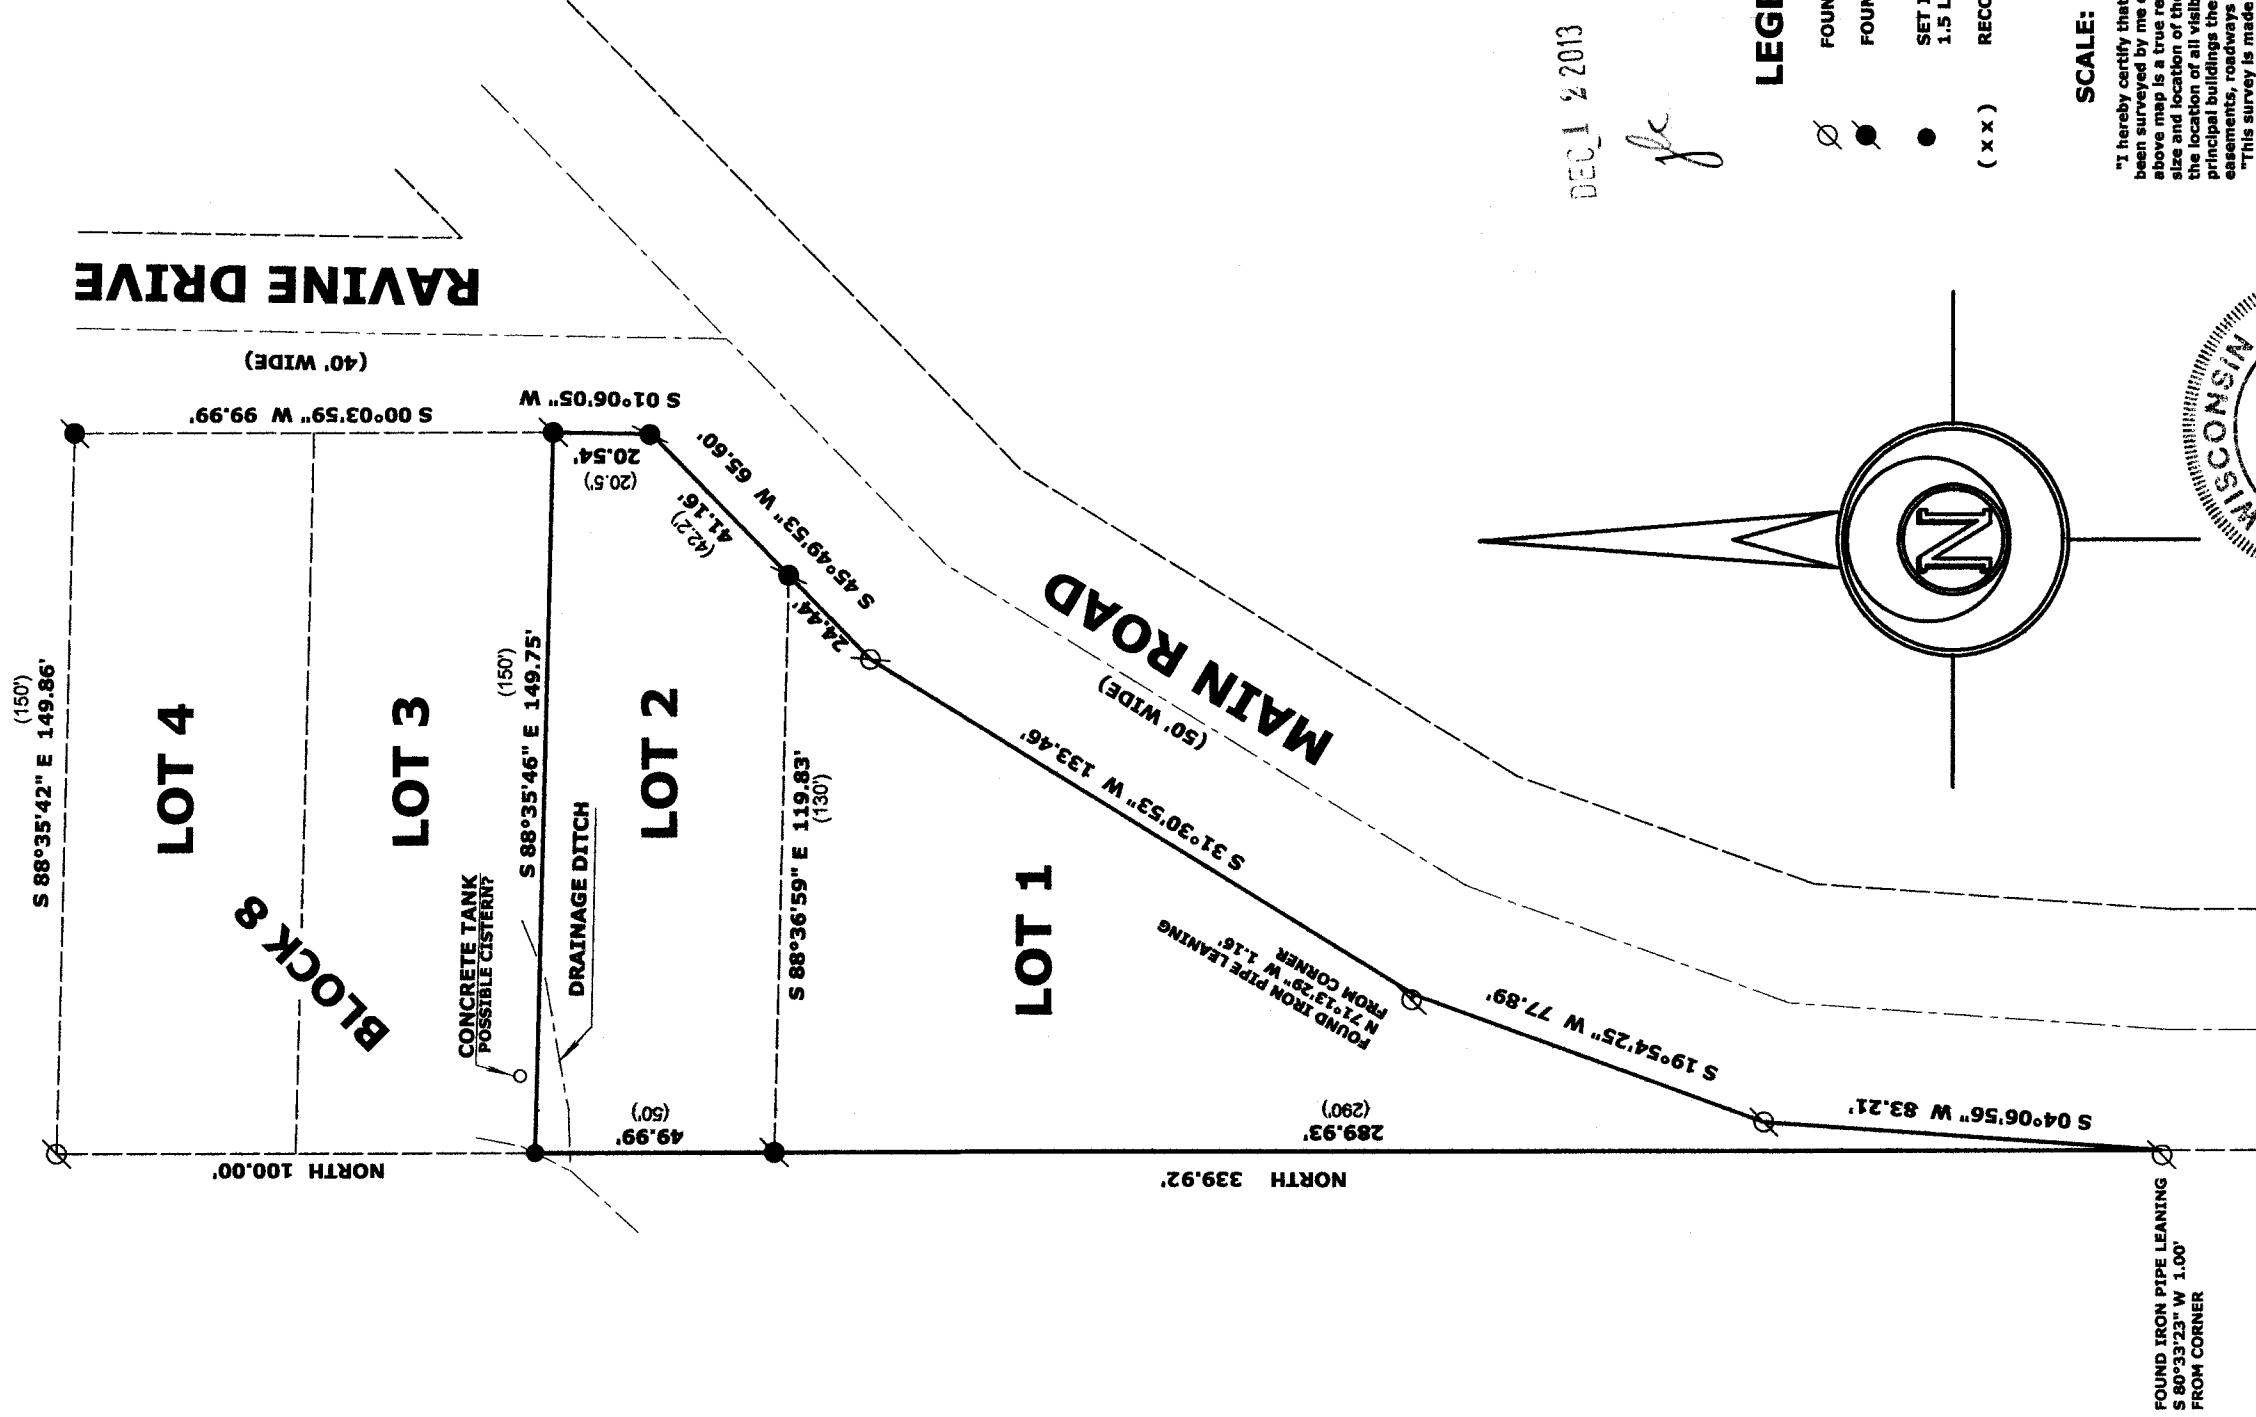

DEC 1 2 2013

LEGEND

FOUND IRON PIPE

FOUND IRON ROD

SET IRON PIPE, 30" LONG, WEIGHING 1.5 LBS./LINEAL FT., 1 1/4" DIA.


RECORDED AS DIMENSION

(x x)

SCALE: 1 INCH = 40 FEET

"I hereby certify that the above described property has been surveyed by me or under my direction and that the above map is a true representation thereof and shows the size and location of the property, its exterior boundaries, the location of all visible structures and dimensions of all principal buildings thereon, boundary fences, apparent easements, roadways and visible encroachments, if any."

"This survey is made for the use of the present owners of the property, and also those who purchase, mortgage, or guarantee the title thereto within one year from date hereof."

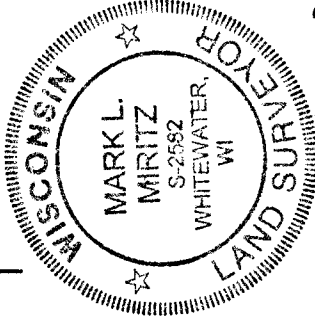

NOTE:

THIS SURVEY RETRACES A SURVEY BY
ROBERT M. BAERENWALD DATED
NOVEMBER 4, 2003

MARK L. MIRITZ
WISCONSIN REGISTERED
LAND SURVEYOR S-2582

DATE: JUNE 22, 2013 JOB NO. 13.611

ISH-103