

PLAT OF SURVEY

-OF-


LOT 1 OF CERTIFIED SURVEY MAP NO. 4420, A PARCEL OF LAND LOCATED IN THE SOUTHWEST 1/4 OF THE NORTHWEST 1/4 OF SECTION 3, TOWN 1 NORTH, RANGE 17 EAST, WALWORTH COUNTY, WISCONSIN.

PLAT OF SURVEY

KROTT SURVEYING INC.
N3705 WILLOW BEND LANE
LAKE GENEVA WI. 53147
PHONE # (262)248-3697
FAX # (262)249-0639

C.L. SNAKE ROAD

(66' WIDE)

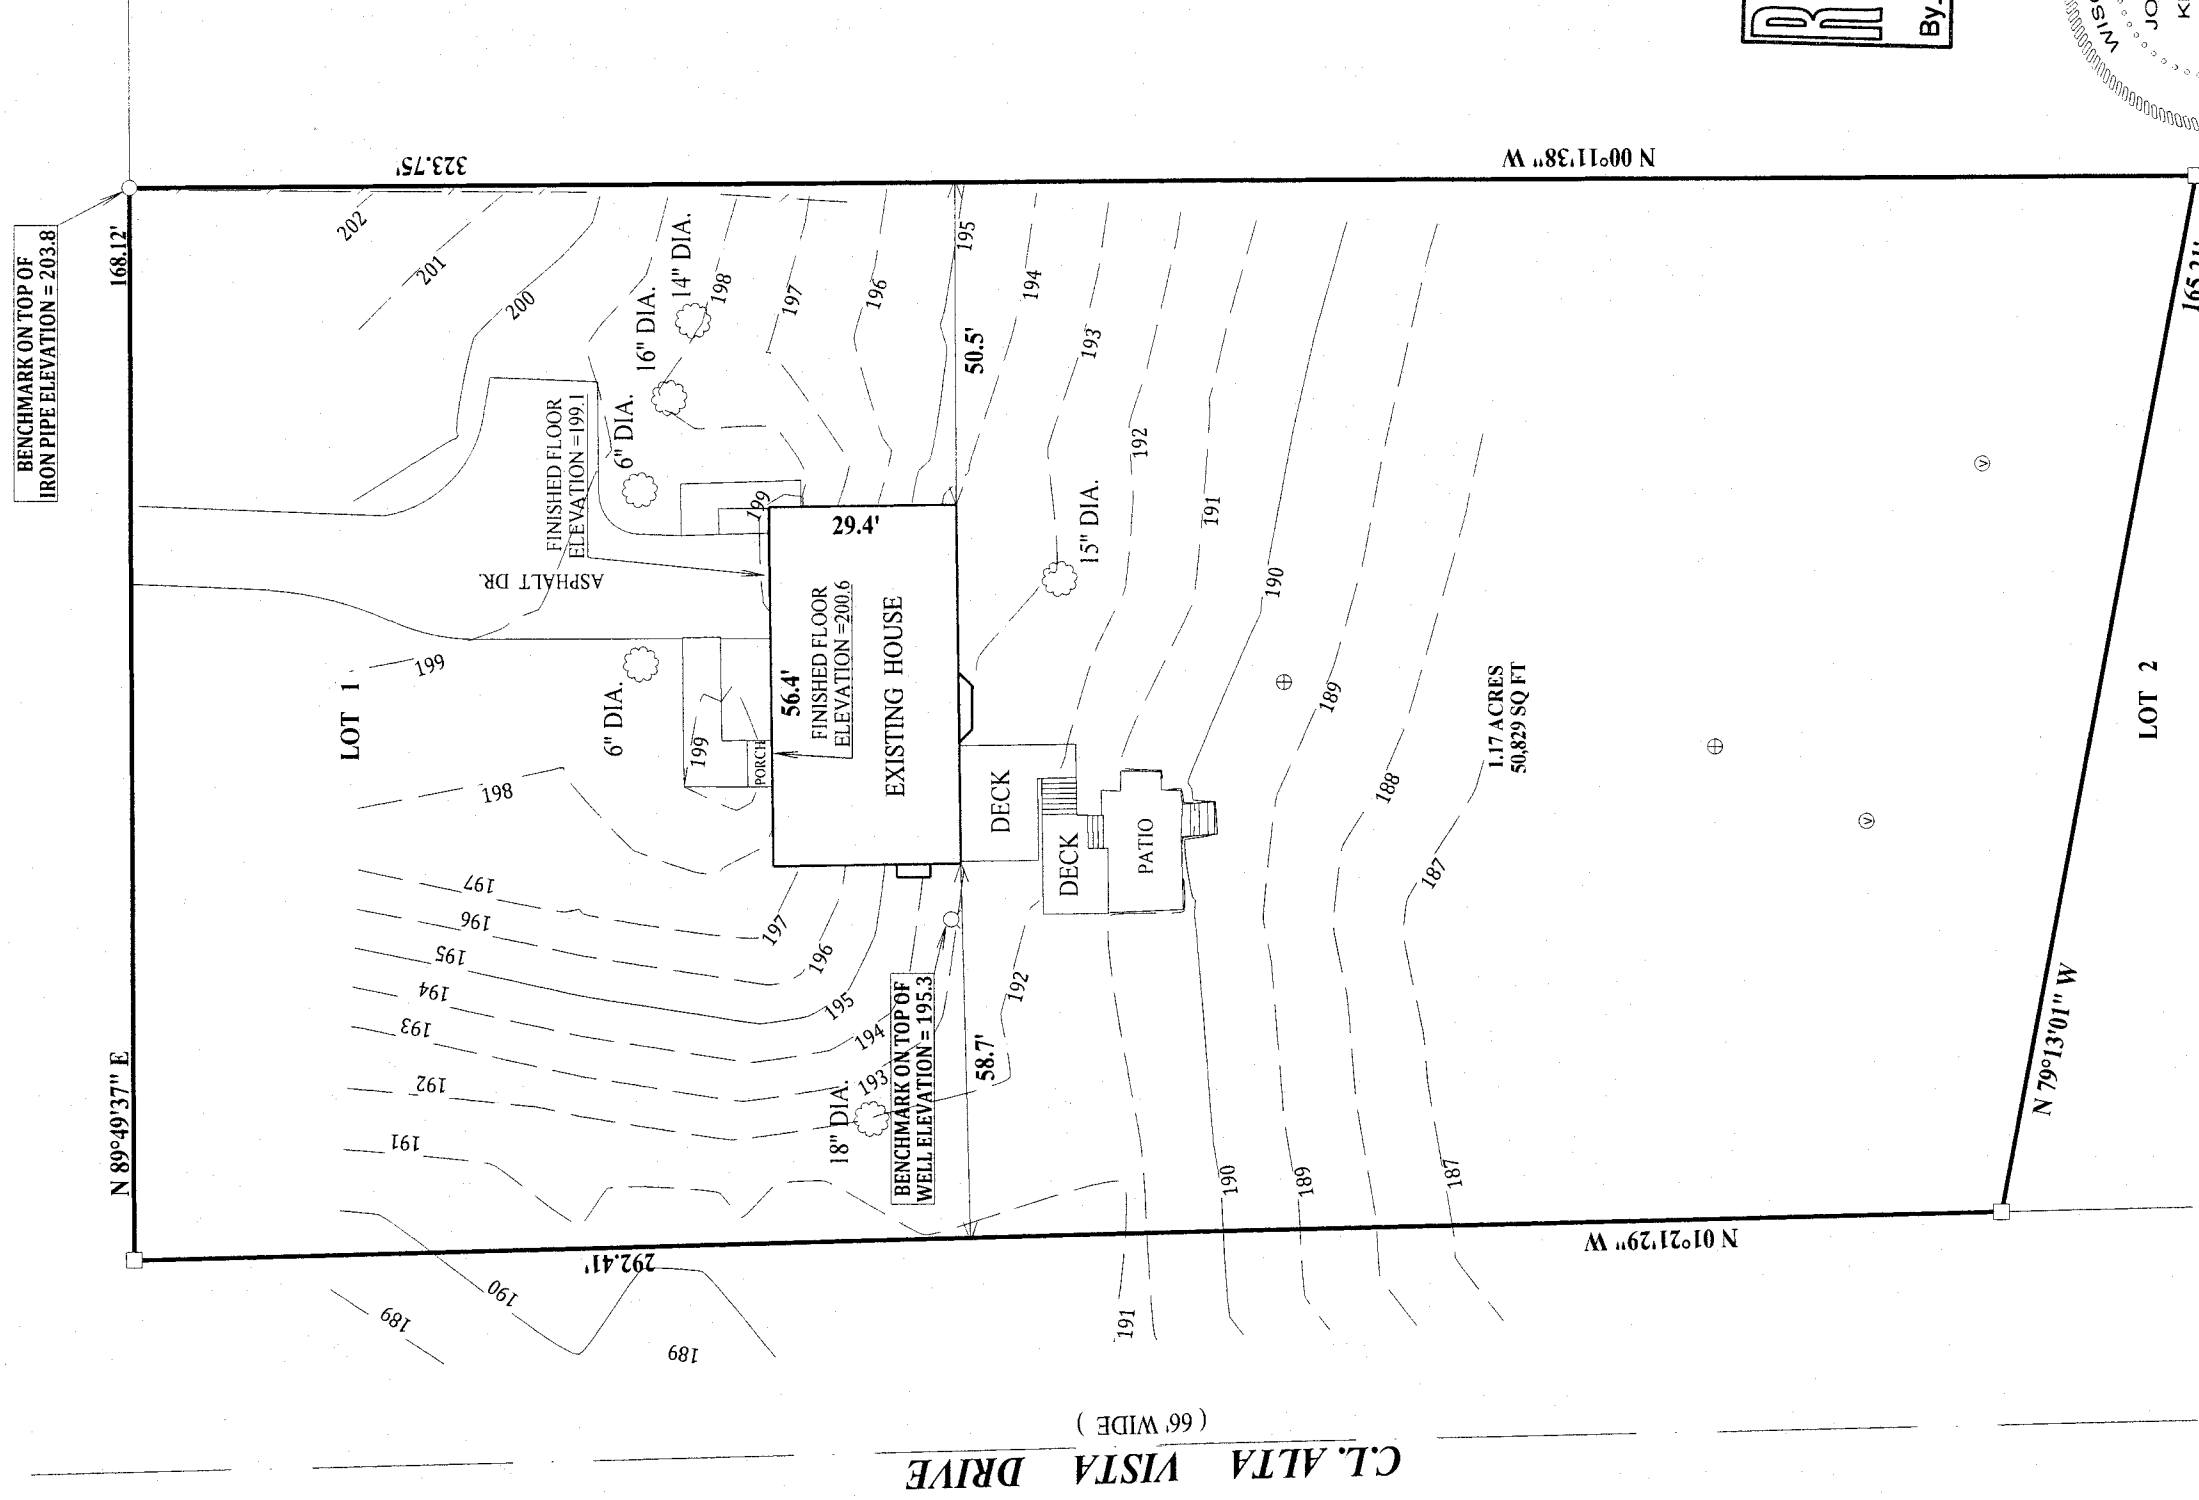

LEGEND

- FOUND IRON PIPE
□ FOUND IRON BAR
⊙ WELL
⊕ CONCRETE ACCESS COVER
⓪ VENT

NOTE: BEARINGS ARE REFERENCED TO THE RECORD C.S.M.



I have surveyed the above-described property and the above map is a true representation thereof and shows the size and location of the property, its exterior boundaries, the location and dimensions of all structures thereon, fences apparent easements and roadways and visible encroachments, if any.


This survey is made for the exclusive use of the present owners of the property, and also those who purchase, mortgage, or insure the title thereto within one (1) year from date hereof; and as to them I warrant the accuracy of said survey map.

DATED THIS 7th DAY OF OCTOBER 2013

JOHN KROTT S - 2258
Wisconsin Registered Land Surveyor
(original if signed in red)

RECEIVED
JAN 21 2014

By lc

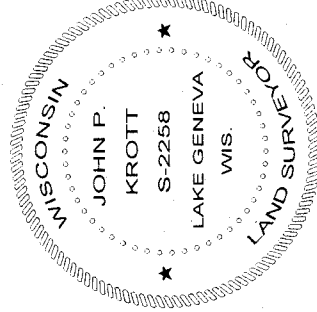

JOB # 12-003LOT1

TAX ID # IA4420 0000I

IA 4420-1

117-3621