

LAND-MARK SURVEYING

Mark L. Miritz

Wisconsin Registered Land Surveyor S-2582

N9330 Knuteson Drive

Whitewater, WI 53190



Phone: (262) 495-3284

MARKMIRITZ@

LAND-MARKSURVEYING.COM


PLAT OF SURVEY

LOTS 5 AND 6 AND 23 AND 24, BLOCK 13, WOODDALE ADDITION,
LOCATED IN TOWN 1 NORTH, RANGE 17 EAST, LINN TOWNSHIP,
WALWORTH COUNTY, WISCONSIN.

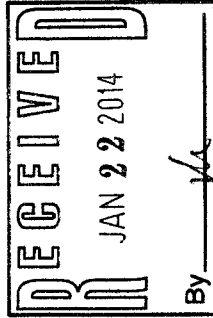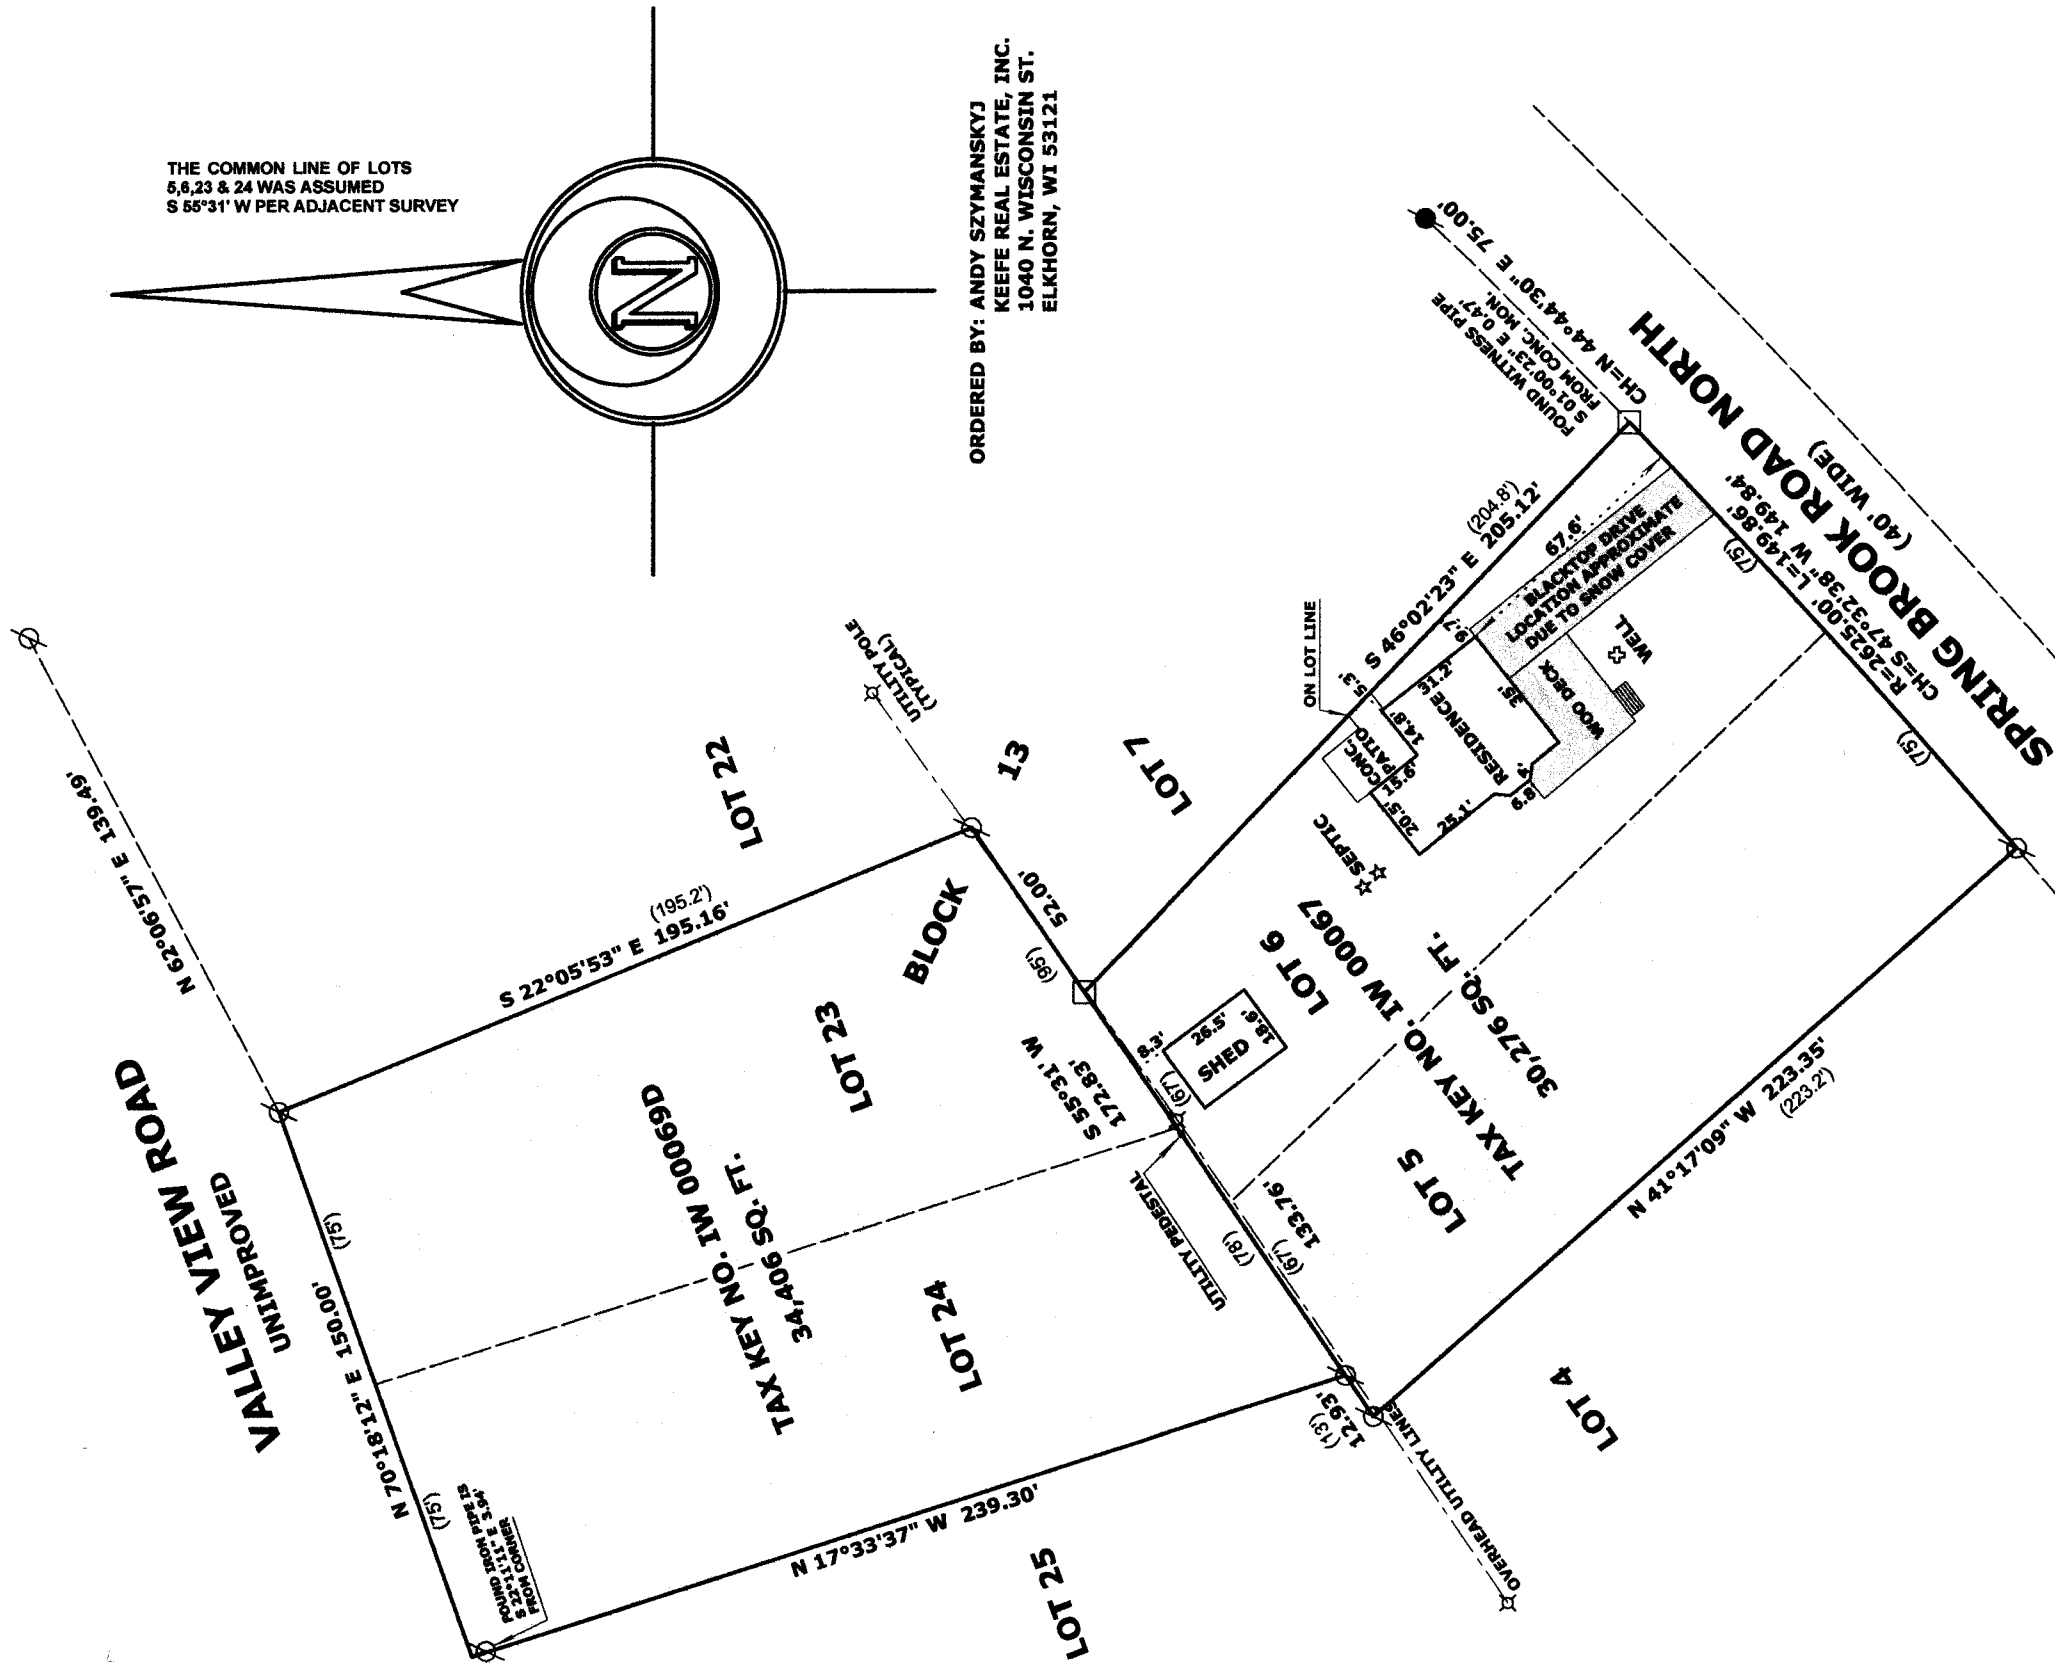

LEGEND

- FOUND IRON PIPE 1"
- FOUND IRON ROD 3/4"
- FOUND CONCRETE MONUMENT
- RECORDED AS DIMENSION

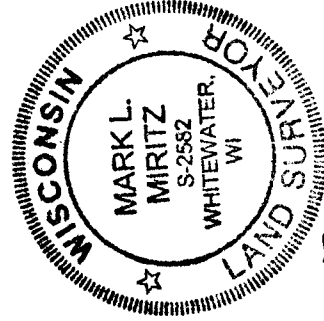

SCALE: 1 INCH = 50 FEET

"I hereby certify that the above described property has been surveyed by me or under my direction and that the above map is a true representation thereof and shows the size and location of the property, its exterior boundaries, the location of all visible structures and dimensions of all principal buildings thereon, boundary fences, apparent easements, roadways and visible encroachments, if any. This survey is made for the use of the present owners of the property, and also those who purchase, mortgage, or guarantee the title thereto within one year from date hereof."

Mark L. Miritz
MARK L. MIRITZ
WISCONSIN REGISTERED
LAND SURVEYOR S-2582

DATE: JAN. 12, 2014 JOB NO. 14.102
IW-67 117-3625
IW-69d