


GRID NORTH
WISCONSIN COORDINATE SYSTEM
SOUTH ZONE
ASSIGNED SOUTH LINE NE 1/4
18-1-17
S 89°30'42" W

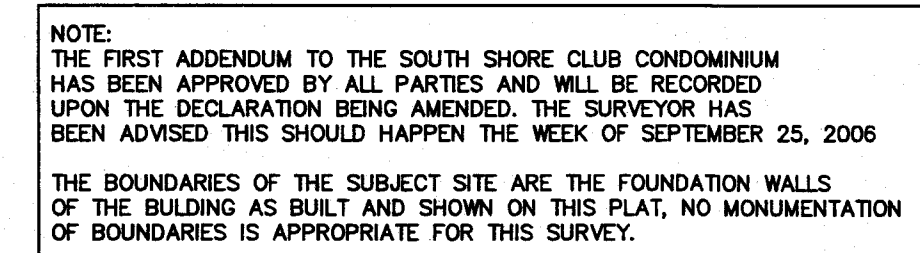

RECEIVED
MAY 1 2014
By _____

PROJECT NO. 4161.12
DATE 08-27-02
SHEET NO. 1 OF 1