


PREPARED FOR
DAVID CURRY
GENEVA LAKEFRONT REALTY, LLC
49 WEST GENEVA ST.
WILLIAMS BAY, WI 53191

PLAT OF SURVEY

-OF-

PATHFINDER SURVEYING INC.
(formerly)
J.K. SURVEYING INC.
PO BOX 372
LAKE GENEVA, WI 53147
WWW.PATHFINDERSURVEYING.NET
262-248-8363

LOT 8 LORAMOOR, A SUBDIVISION LOCATED IN THE SW 1/4 OF THE NE 1/4, IN THE NW 1/4
OF THE SE 1/4 AND IN THE SW 1/4 OF THE SE 1/4 OF SECTION 11, TOWN 1 NORTH, RANGE
17 EAST, TOWN OF LINN, WALWORTH COUNTY, WISCONSIN.

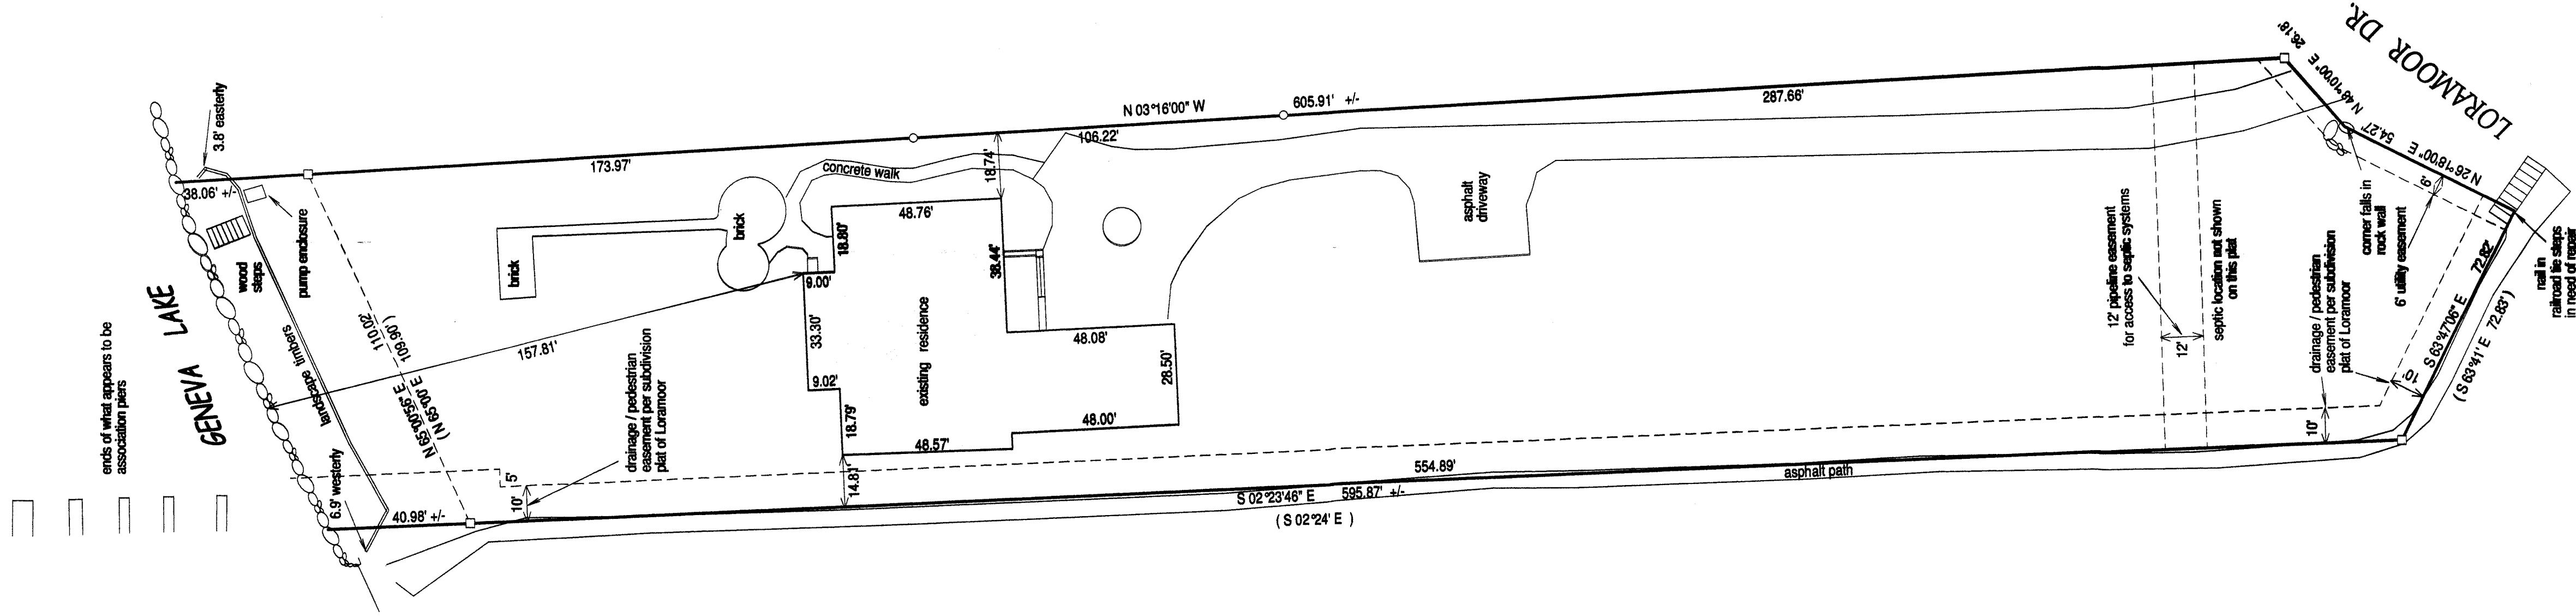


- () = recorded as
■ = set iron bar
□ = found iron bar
○ = found iron pipe
● = set iron pipe

SCALE * = 1" = 30'

JOB # 14-78

TAX KEY # ILWI.00008

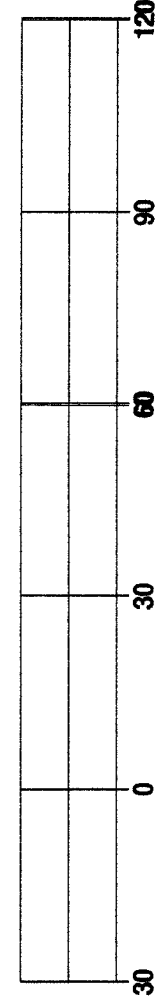

BASES OF BEARING OF THIS PLAT: THE EASTLY LINE OF LOT 8 WAS ASSUMED
TO BEAR N8°16' W AS SHOWN ON THE RECORD PLAT OF LORAMOOR.

"I hereby certify that I have surveyed the above described property and that the above
map is a true representation of its exterior boundary and shows the size and location of
all visible structures, apparent easements and encroachments if any."

This survey is made for the present owners of the property, and those who
purchase, mortgage, or guarantee the title thereto, within one year from
the date hereof.

DATED THIS 10TH DAY OF MAY, 2014.



Jeffrey L. Kline
JEFFREY L. KLINE, S-2436
Wisconsin Registered Land Surveyor
(original if signed in red)