

LAND-MARK SURVEYING
Mark L. Miritz

Wisconsin Registered Land Surveyor S-2582

N9330 Knuteson Drive
Whitewater, WI 53190
Phone: (262) 495-3284
FAX : (262) 495-8421
LAND-MARKSURVEYING.COM



OWNER: MICHAEL KLUMB
W257 S7715 PRAIRIESIDE DR.
WAUKESHA, WI 53189

PLAT OF SURVEY

LOCATION OF BOAT HOUSE SLAB "AS BUILT" ON
LOT 1 OF THE PLAT OF THE BIRCHES FIRST ADD-
ITION, LOCATED IN THE NORTHEAST 1/4 OF
SECTION 9, TOWN 1 NORTH, RANGE 17 EAST,
LINN TOWNSHIP, WALWORTH COUNTY, WISCONSIN

GENEVA LAKE

LAKE ELEV=864.97'
100 YEAR FLOOD ELEV=865.00'

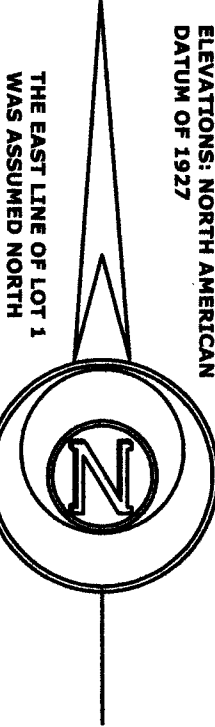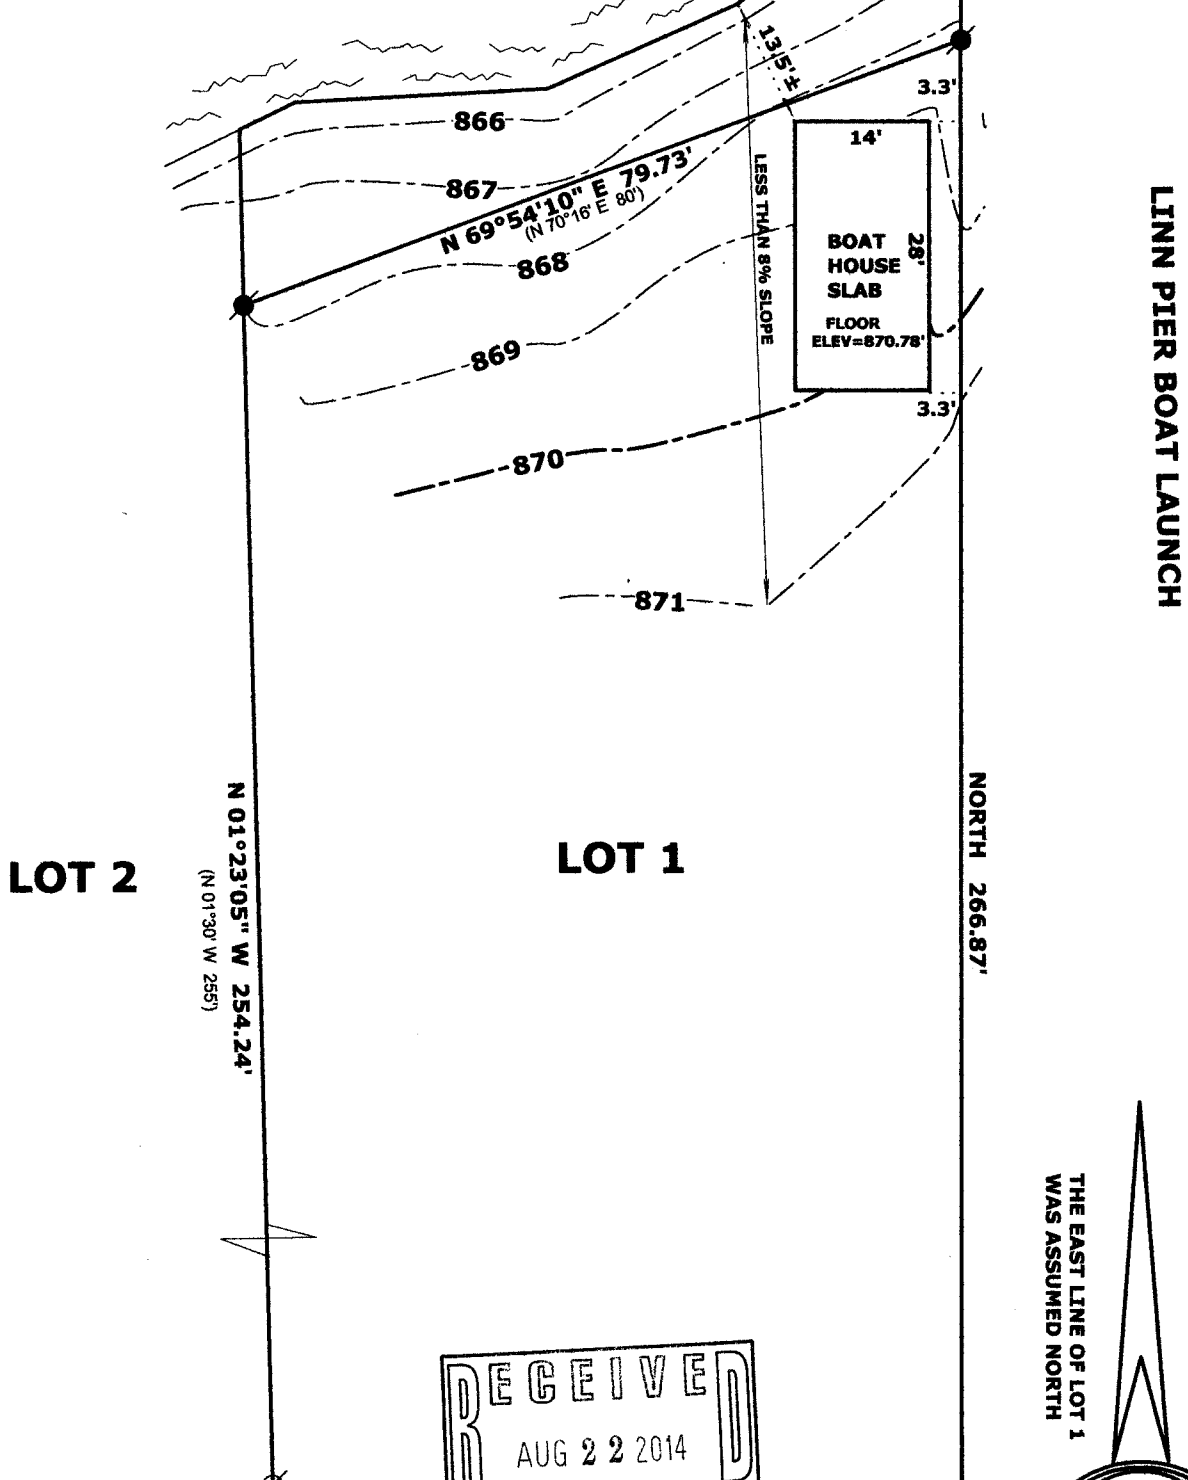

SCALE: 1 INCH = 20 FEET

"I hereby certify that the above described property has been surveyed by me or under my direction and that the above map is a true representation thereof and shows the size and location of the property, its exterior boundaries, the location of all visible structures and dimensions of all principal buildings thereon, boundary fences, apparent easements, roadways and visible encroachments, if any."
"This survey is made for the use of the present owners of the property, and also those who purchase, mortgage, or guarantee the title thereto within one year from date hereof."

Mark L. Miritz
MARK L. MIRITZ
WISCONSIN REGISTERED
LAND SURVEYOR S-2582

DATE: JULY 2, 2014 JOB NO. 14.611



LEGEND

- Ø FOUND IRON PIPE
- FOUND AXEL ROD
- (x x) RECORDED AS DIMENSION