


HAROLD H. KOLS
REGISTERED PROFESSIONAL LAND SURVEYOR
LAKE GENEVA, WISCONSIN

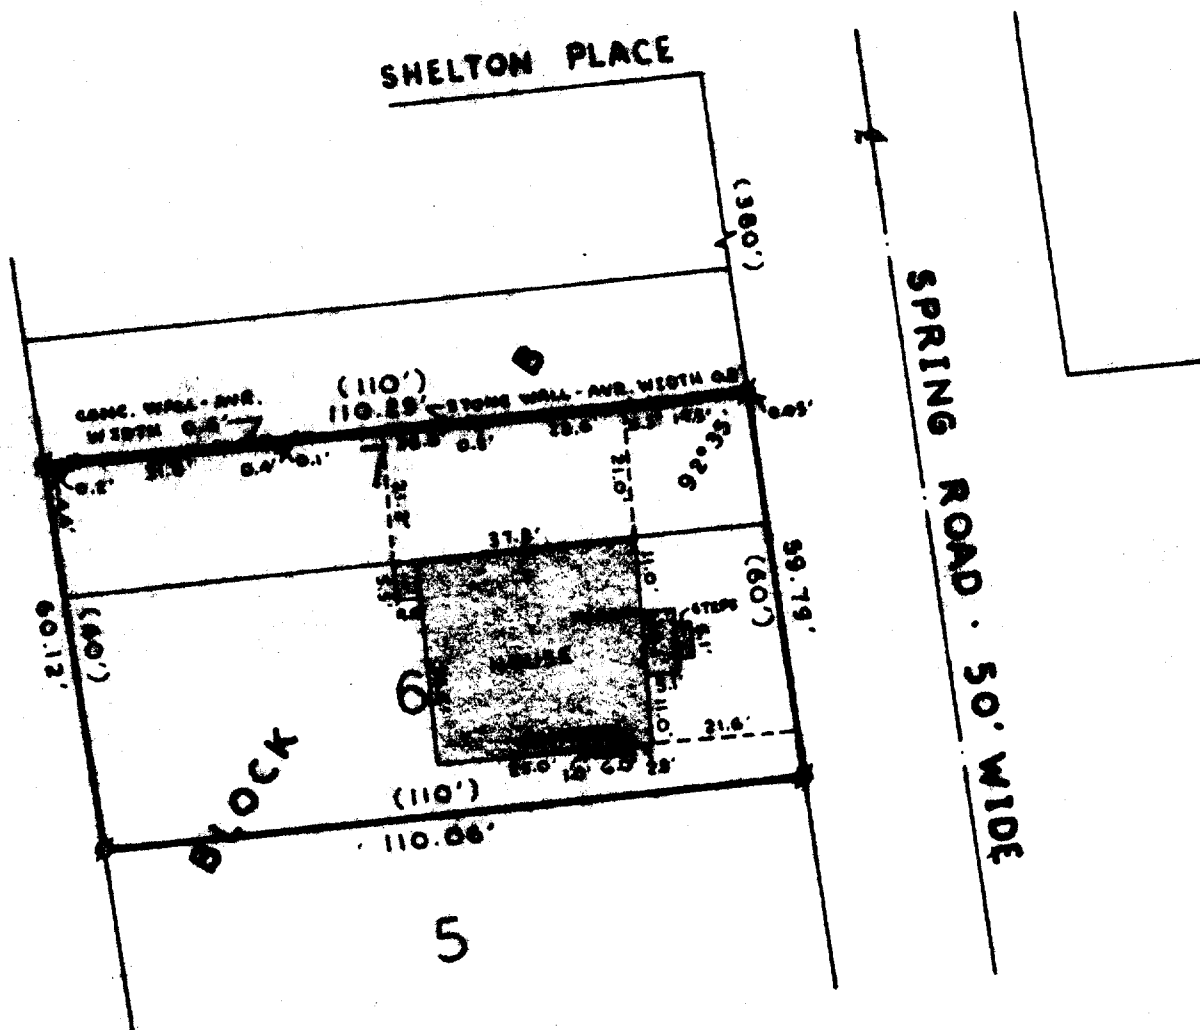

N


SCALE: 1"=30'

LEGEND

- ⬢ - IRON PIPE FOUND
- - IRON PIPE PLACED
- - CONCRETE MONUMENT
- ✕ - SPIKE
- () - AS PLATTED

PLAT OF SURVEY OF
 Lot 6 and the South 20 feet of Lot 7,
 Block B, Cisco Beach Subdivision,
 T 1 N, R 17 E, Walworth County,
 Wisconsin.

I, **HAROLD H. KOLS**, DO HEREBY CERTIFY THAT I HAVE
 SURVEYED THE PROPERTY HEREON DESCRIBED ACCORDING
 TO THE OFFICIAL RECORDS, AND THAT THE PLAT HEREON
 IS A CORRECT REPRESENTATION OF THE LOT LINES.

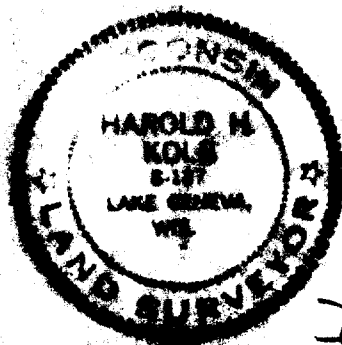

Harold H. Kols
HAROLD H. KOLS
WISCONSIN REGISTERED LAND SURVEYOR, 8-187
DATE January 25, 1973

7 CI - 21

117-367