




ORDERED BY
ELAINE JOHNSON
ASSISTANT TO
DEBBIE COBIAN & LAURA RODRIGUEZ
KEEFE REAL ESTATE
LAKE GENEVA, WI

PLAT OF SURVEY


- OF -

PATHFINDER SURVEYING INC.
(formerly)
J.K. SURVEYING INC.
P.O BOX 322
LAKE GENEVA, WI. 53147
WWW.PATHFINDERSURVEYING.NET
262-248-8303

PART OF LOTS 14 AND 15, BLOCK 2 OF WOODDALE ADDITION LOCATED IN SECTION 9, TOWN 1 NORTH, RANGE 17 EAST, TOWN OF LINN, WALWORTH COUNTY, WISCONSIN, DESCRIBED AS FOLLOWS, TO-WIT: BEGINNING AT THE NW CORNER OF SAID LOT 14; THENCE SOUTHEASTERLY ALONG THE NORTH LINE OF LOT 14, 5.04 FEET; THENCE S 0°19' E 83.35 FEET; THENCE N 89°43' W 5.98 FEET TO THE EAST LINE OF SAID LOT 15; THENCE N 0°39' E ALONG THE EAST LINE OF SAID LOT 15 8.90 FEET; THENCE S 88°33' W 49.03 FEET; THENCE N 7°54' W 95.15 FEET TO THE NORTH LINE OF SAID LOT 15; THENCE SOUTHEASTERLY ALONG THE SAID NORTH LINE 65.00 FEET TO THE PLACE OF BEGINNING.

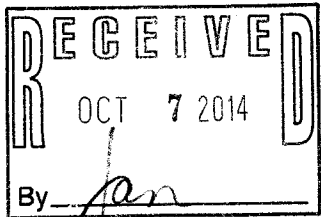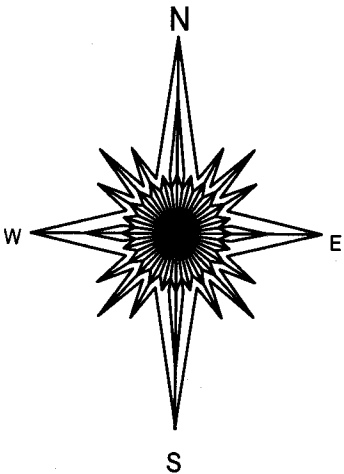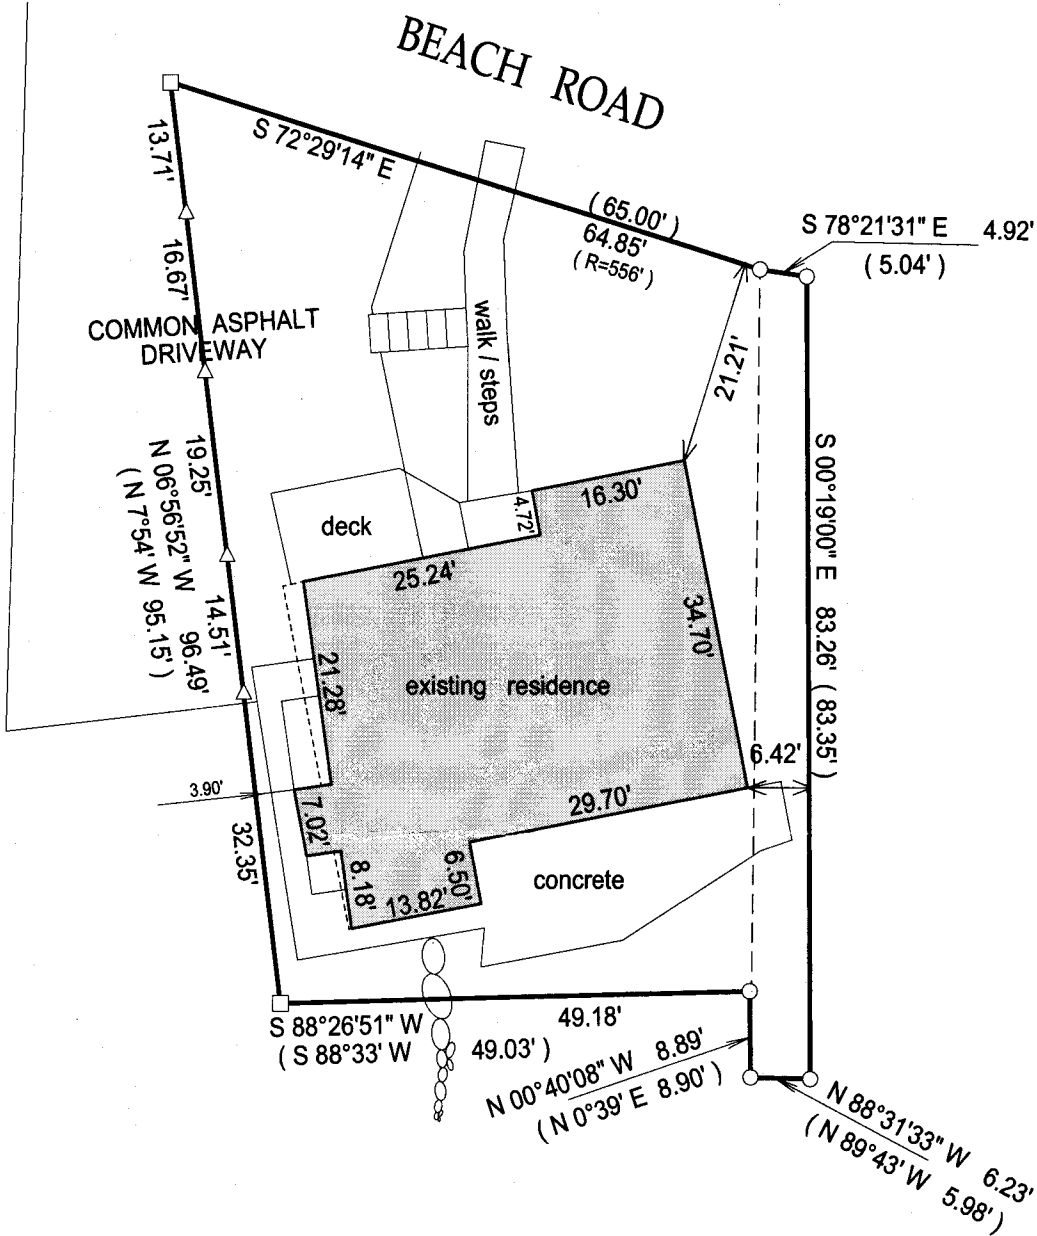

- △ = mag nail
- () = recorded as
- = found iron bar
- = found iron pipe
- = set iron pipe
- = set iron bar

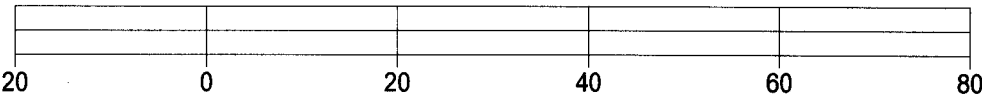


BASIS OF BEARING OF THIS PLAT: THE EAST LINE OF THE PARCEL SURVEYED WAS ASSUMED TO BEAR S 0°19' E.

I hereby certify that I have surveyed the above- described property and the above map is a true representation thereof and shows the size and location of the property, its exterior boundaries, the location and dimensions of all structures thereon, fences, apparrant easements and roadways and visible encroachments if any.

This survey is made for the present owners of the property, and those who purchase, mortgage, or guarantee the title thereto, within one year from the date hereof.

DATED THIS 24TH DAY OF AUGUST, 2014.

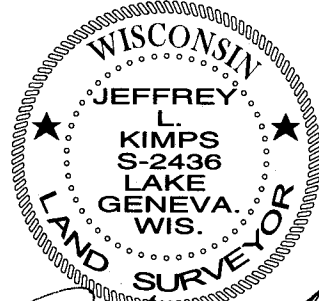

JEFFREY L. KIMPS S-2436
Wisconsin Registered Land Surveyor
(original if signed in red)

IW -27B

117-3677

SCALE 1" = 20'

JOB # 14-194

TAX ID #
IW 00027B