



REGISTERED PROFESSIONAL LAND SURVEYOR
LAKE GENEVA, WISCONSIN

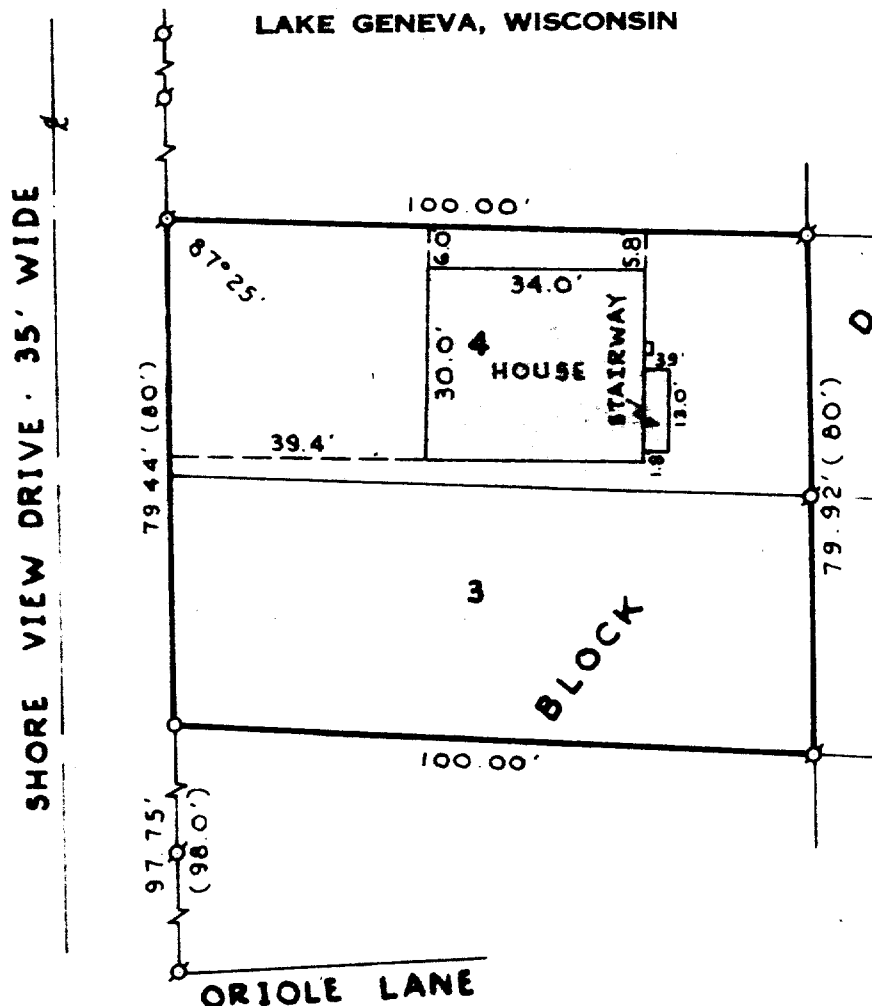

SCALE 1"=30'

- ① - IRON PIPE FOUND
- ② - IRON PIPE PLACED
- - CONCRETE MONUMENT
- ④ - SPIKE
- ⑤ - PLATTED AS

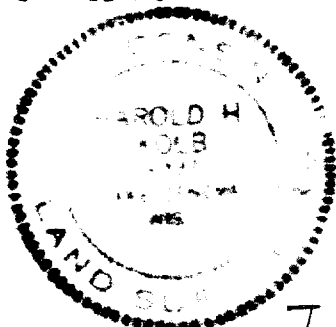

3 4 D. CISCO BEACH

I. HAROLD H. KOLB, DO HEREBY CERTIFY THAT I HAVE SURVEYED THE PROPERTY HEREON DESCRIBED ACCORDING TO THE OFFICIAL RECORDS AND THAT THE PLAT HEREON IS A CORRECT REPRESENTATION OF THE LOT LINES.

Harold A. Cook

HAROLD H. KOLB
WISCONSIN REGISTERED LAND SURVEYOR. S-187

DATE _____

ICI - 77

117-368