

PLAT OF SURVEY



-OF-

LOT 2 IN LAKE GENEVA BEACH SUBDIVISION LOCATED IN
THE TOWN OF LINN, WALWORTH COUNTY, WISCONSIN

LYNCH & ASSOCIATES
ENGINEERING CONSULTANTS, LLC.
5482 S. WESTRIDGE DR.
NEW BERLIN, WI 53151
(262) 248-3697


LEGEND

- FOUND 1" IRON PIPE
- ⊙ FOUND 2" IRON PIPE
- FOUND 5/8" IRON ROD
- (XX) RECORDED AS
- ⊠ UTILITY PEDISTAL
- ⊘ POWER POLE
- OVERHEAD UTILITY LINE
- WELL
- ⊕ SEPTIC TANK COVER

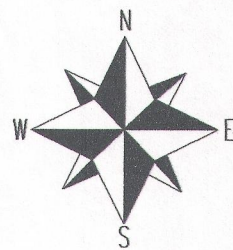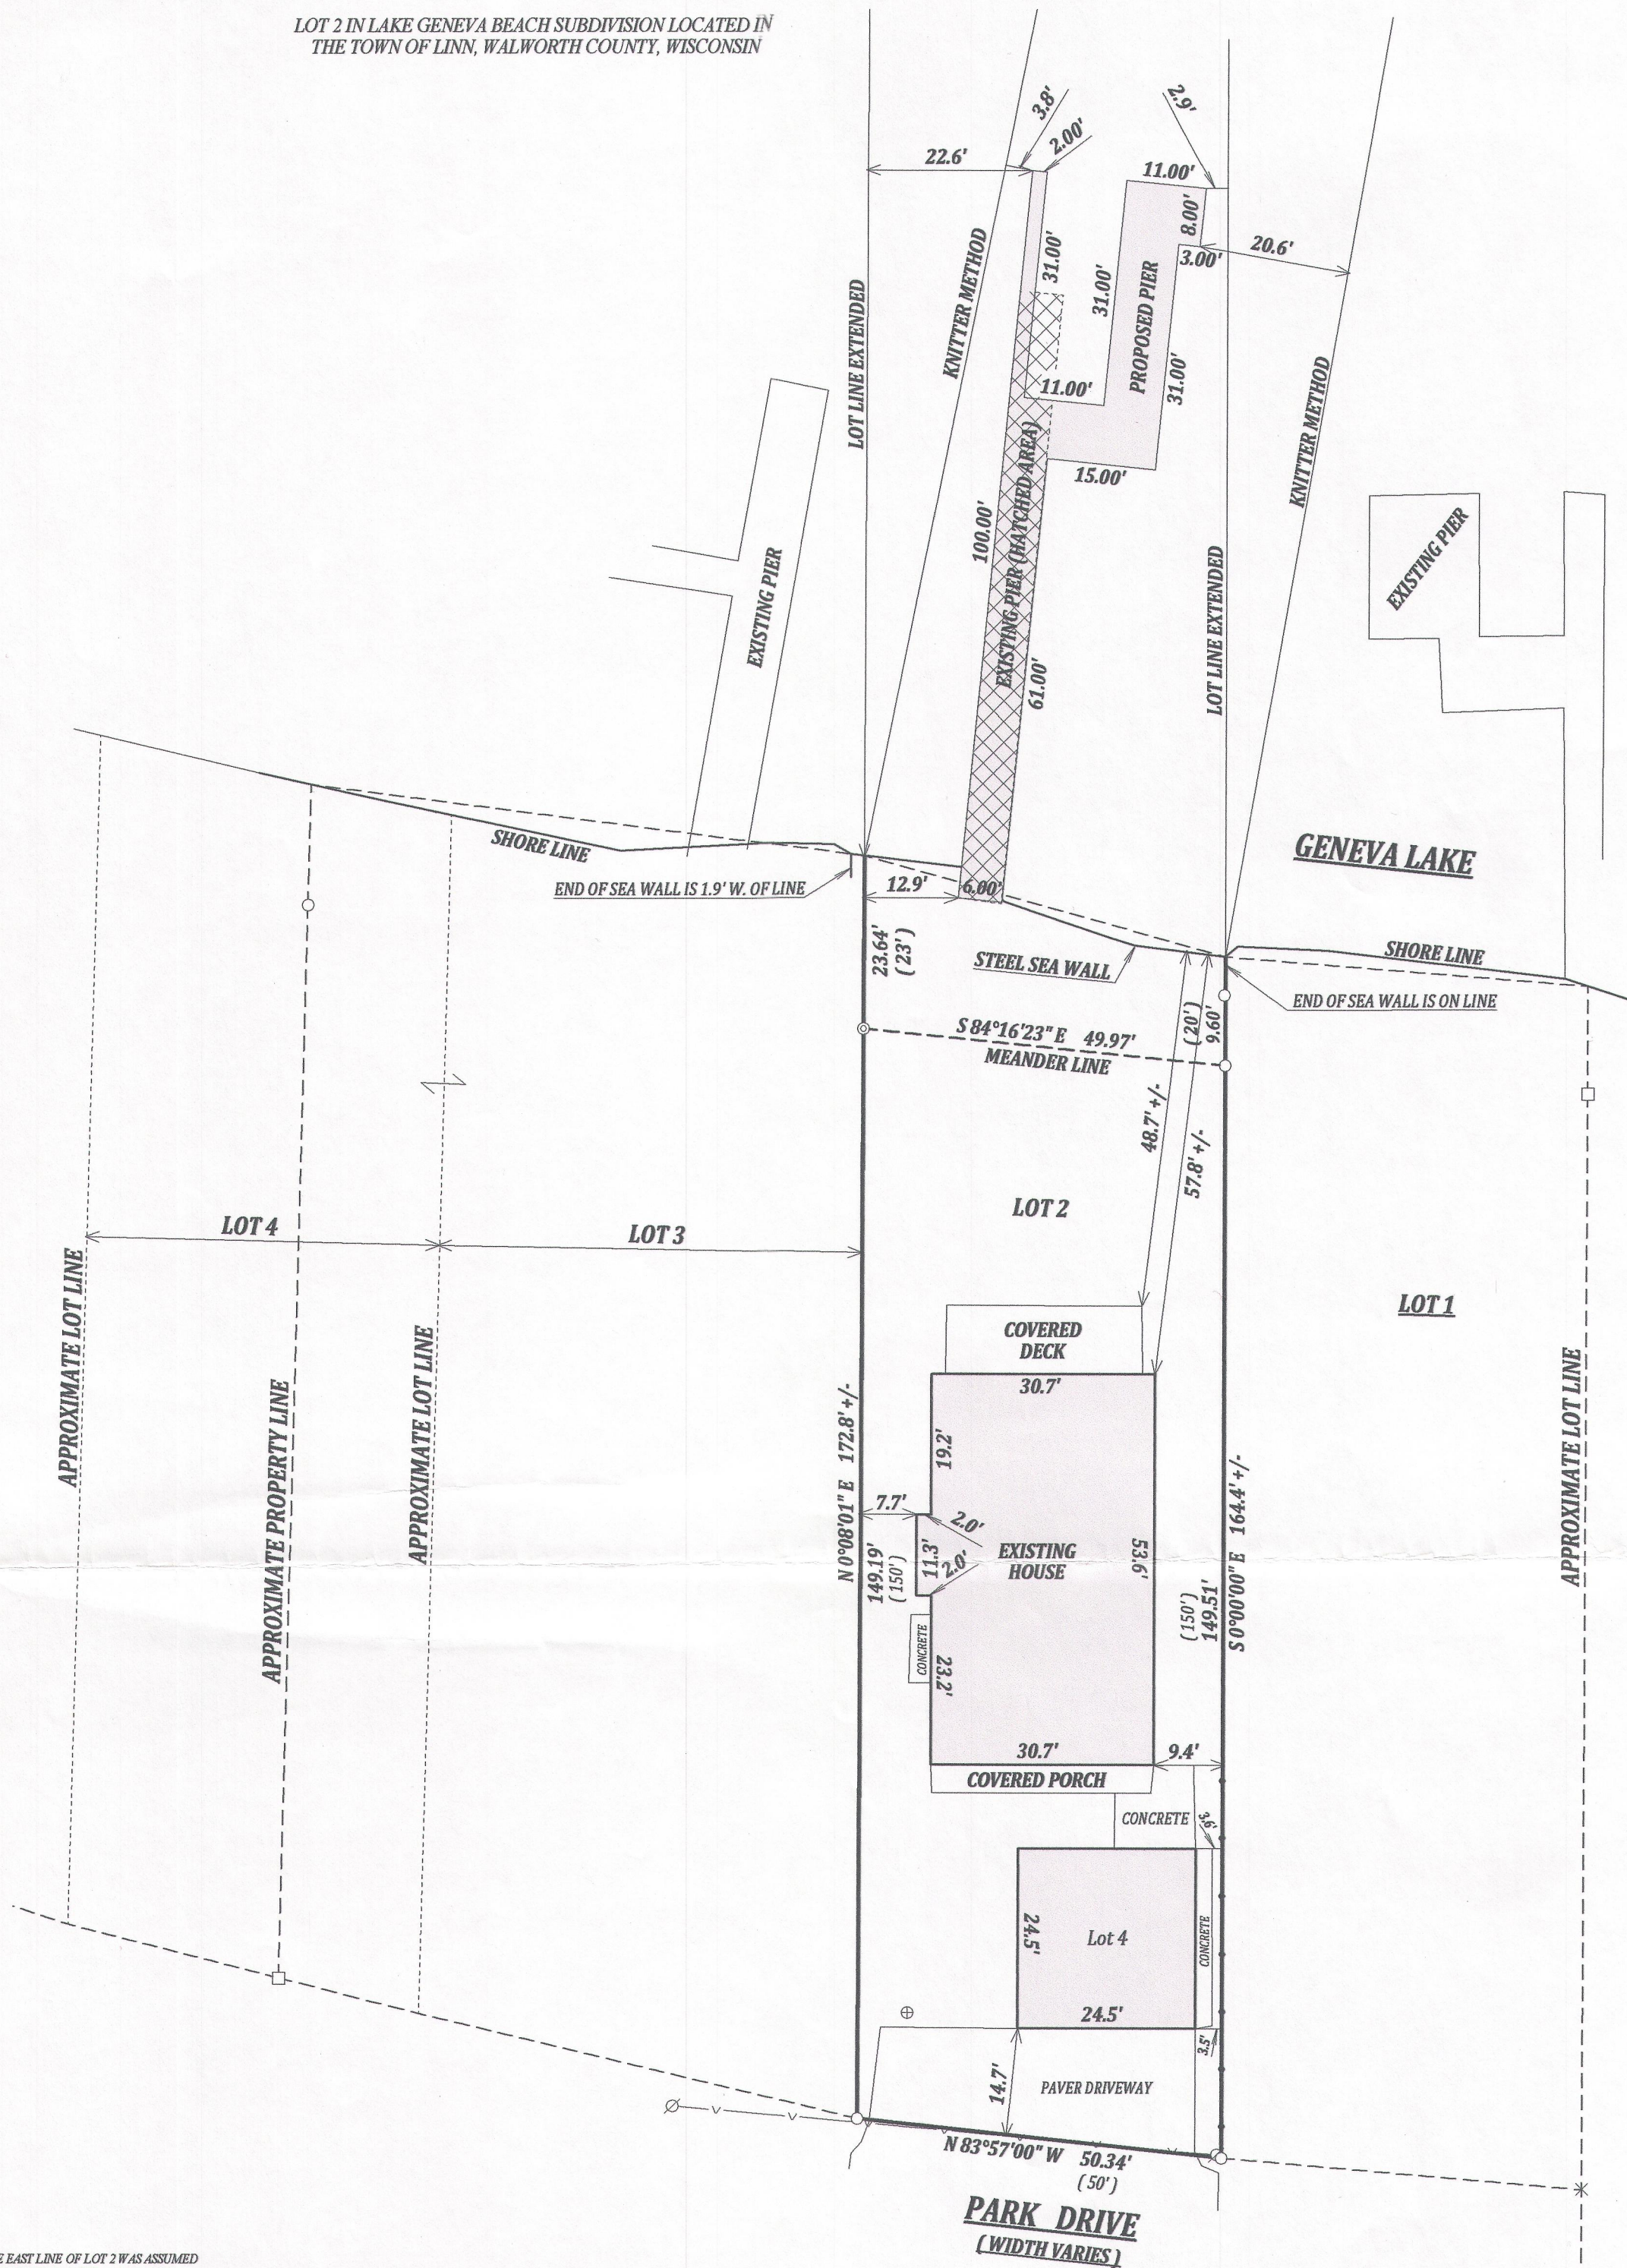

THE EAST LINE OF LOT 2 WAS ASSUMED
TO BEAR DUE NORTH

SCALE 1" = 20'

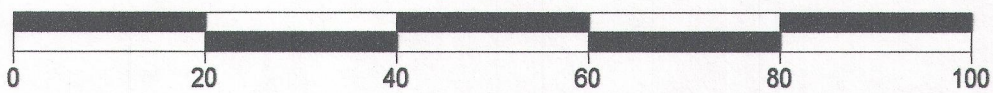


NOTE:

No title commitment or results of a title search were provided to this office pertaining to this survey. This Plat Of Survey may not reflect easements of record, encumbrances, restrictions, ownership, title evidence, or other facts that a current and accurate title search may disclose.

I have surveyed the above-described property and the above map is a true representation thereof and shows the size and location of the property, its exterior boundaries, the location and dimensions of all structures thereon, fences apparent easements and roadways and visible encroachments, if any.

This survey is made for the exclusive use of the present owners of the property, and also those who purchase, mortgage, or insure the title thereto within one (1) year from date hereof; and as to them I warrant the accuracy of said survey map.

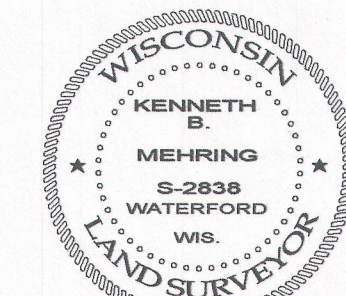

DATED THIS 13th DAY OF OCTOBER, 2014

KENNETH B. MEHRING S - 2838
Wisconsin Registered Land Surveyor
(original if signed in red)