


APRIL 1 1960

lots 12 and 13, except the
South 10.00 feet of lot 12,
Block 1, Lake View Park
Subdivision, T 1 N, R 17 E,
Walworth County, Wisconsin.

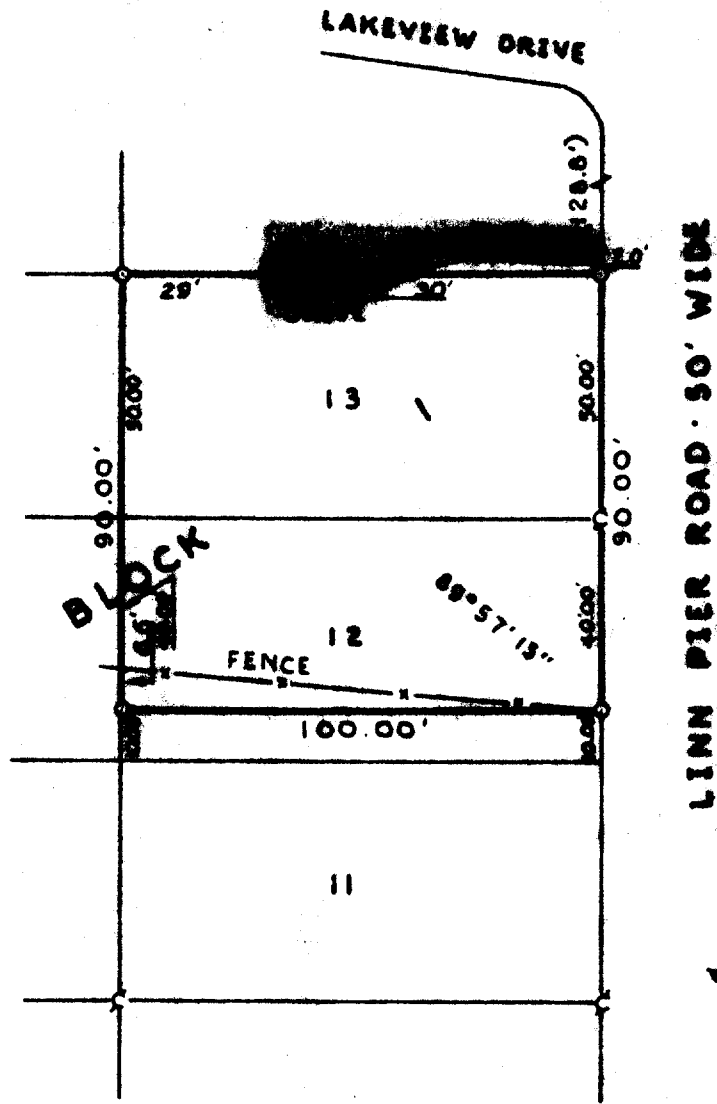

SCALE: 1"=40'

- Φ - IRON PIPE FOUND
- - IRON PIPE PLACED
- - CONCRETE MONUMENT
- ⋈ - POSEY PIN FOUND
- () - AS PLATTED



I, HAROLD H. KOLB, DO HEREBY CERTIFY THAT I HAVE SURVEYED THE PROPERTY HEREON DESCRIBED ACCORDING TO THE OFFICIAL RECORDS, AND THAT THE PLAT HEREON IS A CORRECT REPRESENTATION OF THE LOT LINES.

Harold H. Kolb
HAROLD H. KOLB
WISCONSIN REGISTERED LAND SURVEYOR, S-187
DATE February 19, 1973

14VP-1A3

117-370