


HAROLD H. KOLB

REGISTERED PROFESSIONAL LAND SURVEYOR
LAKE GENEVA, WISCONSIN

I.P. SET 100' SOUTH OF CORNER
ON LINE

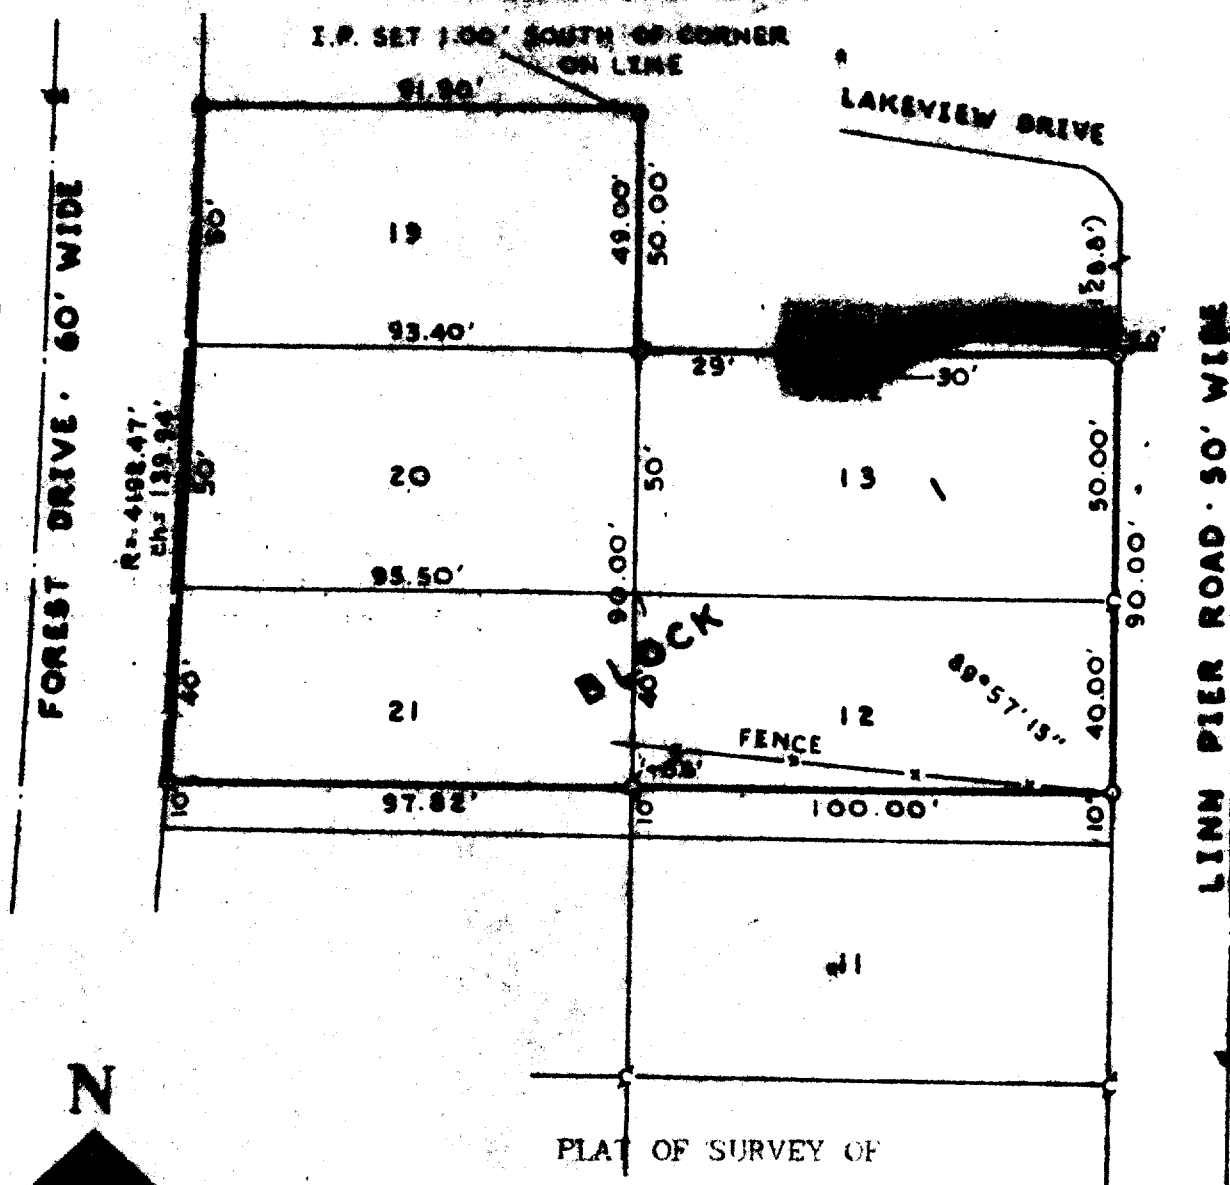

SCALE: 1"=40'


LEGEND

- ⊕ - IRON PIPE FOUND
- - IRON PIPE PLACED
- - CONCRETE MONUMENT
- ⊙ - POSEY PIN FOUND
- () - AS PLATTED

PLAT OF SURVEY OF
Lots 12, 13 and 19-21, except the South 10
feet of Lots 12 and 21, Block 1, Lake View
Park Subdivision, T 1 N, R 12 E, Walworth
County, Wisconsin.

I, HAROLD H. KOLB, DO HEREBY CERTIFY THAT I HAVE
SURVEYED THE PROPERTY HEREON DESCRIBED ACCORDING
TO THE OFFICIAL RECORDS, AND THAT THE PLAT HEREON
IS A CORRECT REPRESENTATION OF THE LOT LINES.

Harold H. Kolb
HAROLD H. KOLB
WISCONSIN REGISTERED LAND SURVEYOR, S-187
DATE February 19, 1973
REVISED: March 7, 1973

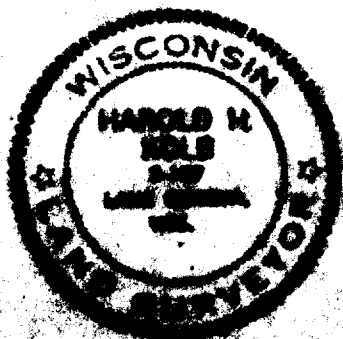

ILVP-1A3
ILVP-1F

117-371