

PREPARED FOR
ENGERMAN CONTRACTING, INC.
W3411 LINTON RD.
LAKE GENEVA, WI 53147

LYNCH & ASSOCIATES
ENGINEERING CONSULTANTS, LLC.
5482 S. WESTRIDGE DR.
NEW BERLIN, WI 53151
(262) 248-3697

PLAT OF SURVEY

-OF-

LOT 100 IN LAKE GENEVA HIGHLANDS, TOWN OF LINN,
WALWORTH COUNTY, WISCONSIN.

LEGEND

○ FOUND 1" IRON PIPE

(XX) RECORDED AS


∅ POWER POLE

— V — OVERHEAD UTILITY LINES

⊙ WELL




⊙ SEPTIC VENT

⊕ SEPTIC TANK COVER

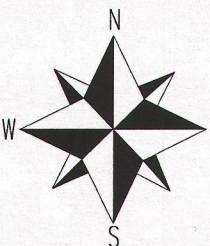

BEARINGS HEREON ARE ASSUMED
AND RELATE TO PREVIOUS SURVEYS
ON FILE

SCALE 1" = 20'

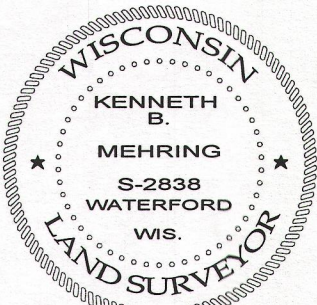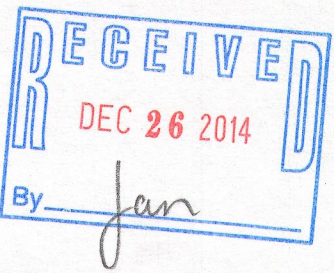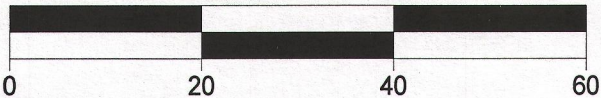

DATED THIS 8th DAY OF DECEMBER, 2014

KENNETH B. MEHRING S - 2838
Wisconsin Registered Land Surveyor
(original if signed in red)


NOTE:

No title commitment or results of a title search were provided to this office pertaining to this survey. This Plat Of Survey may not reflect easements of record, encumbrances, restrictions, ownership, title evidence, or other facts that a current and accurate title search may disclose.

I have surveyed the above-described property and the above map is a true representation thereof and shows the size and location of the property, its exterior boundaries, the location and dimensions of all structures thereon, fences apparent easements and roadways and visible encroachments, if any.

This survey is made for the exclusive use of the present owners of the property, and also those who purchase, mortgage, or insure the title thereto within one (1) year from date hereof; and as to them I warrant the accuracy of said survey map.

C/L HIGHLAND ROAD
(50' WIDE)

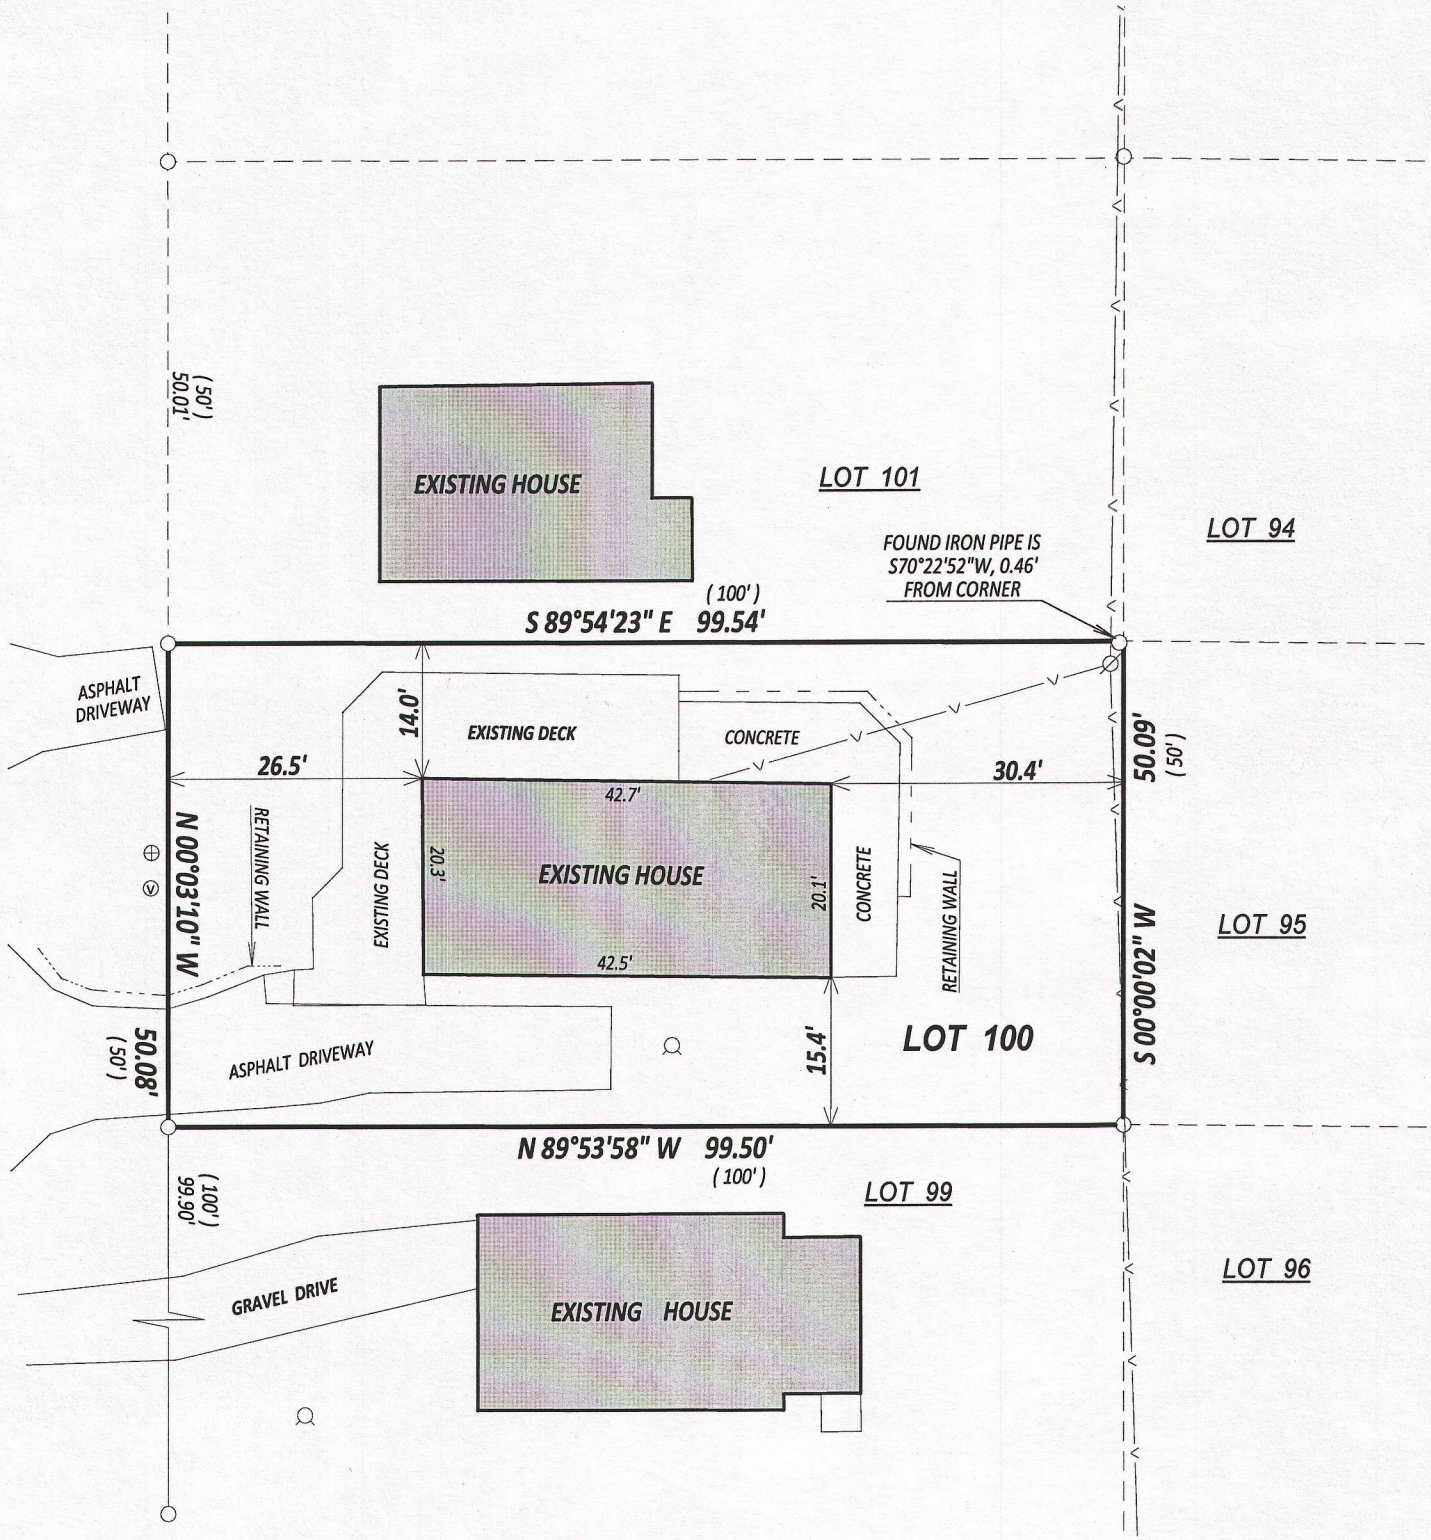

JOB # 14554-4
TAX ID # ILGH 00097

ILGH-97

117-3719