

HAROLD H. KOLB

REGISTERED PROFESSIONAL LAND SURVEYOR
LAKE GENEVA, WISCONSIN

FENCE 04' E OF
IRON PIPE

PLAT OF SURVEY OF



A parcel of land located in
the Northeast $\frac{1}{4}$ of Section 16,
T 1 N, R 17 E, Walworth County,
Wisconsin.



SCALE 1" = 200'

LEGEND

- φ - IRON PIPE FOUND
- - IRON PIPE PLACED
- - CONCRETE MONUMENT
- x - SPIKE
- c - IRON PIN FOUND

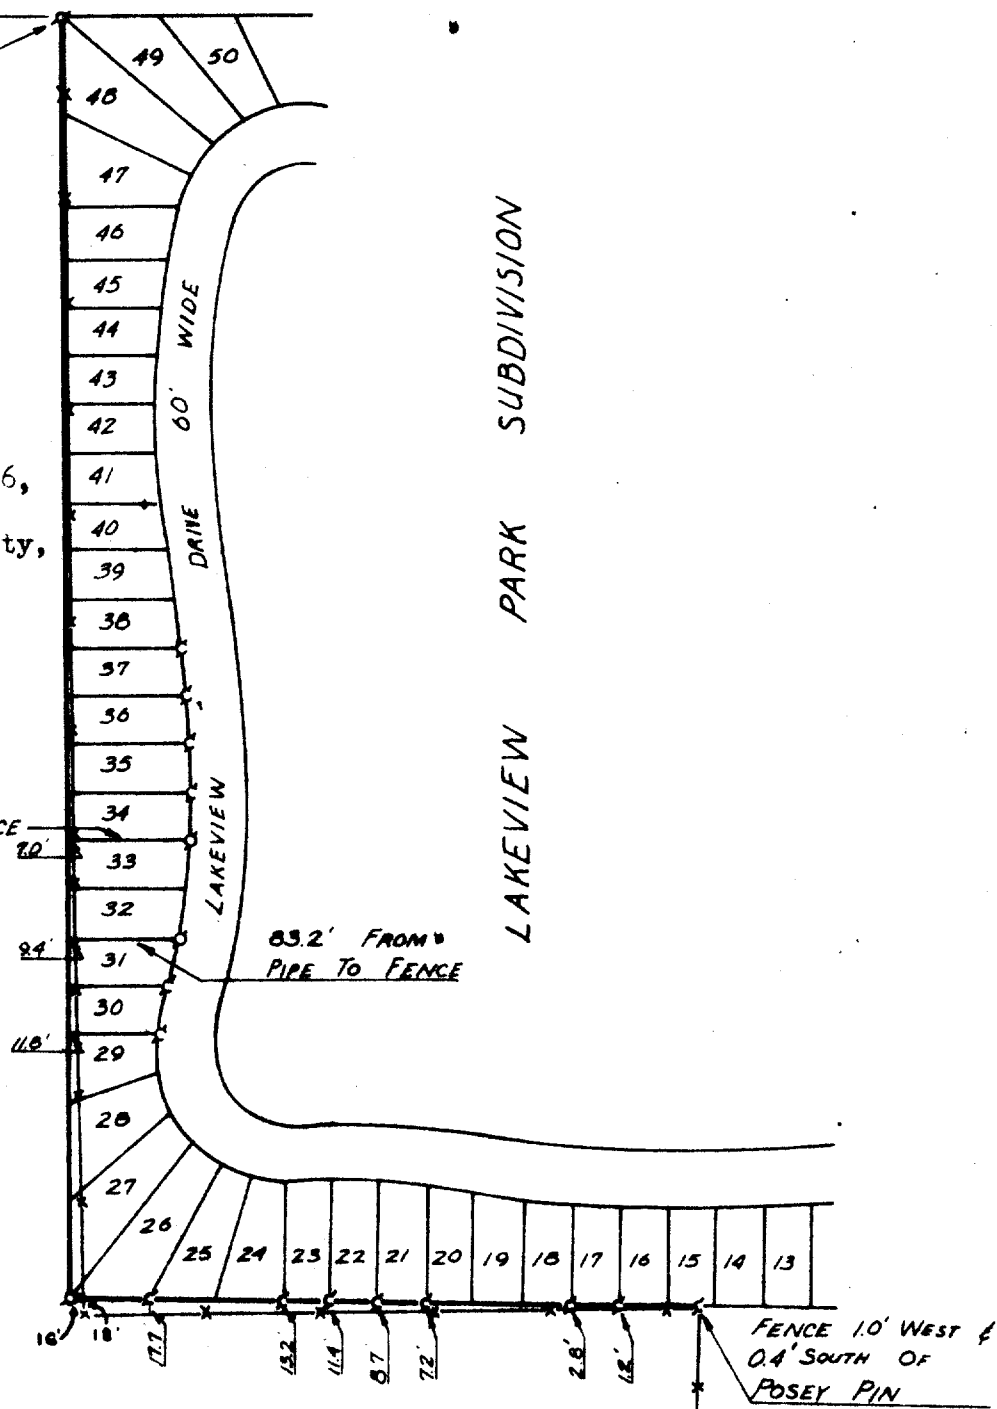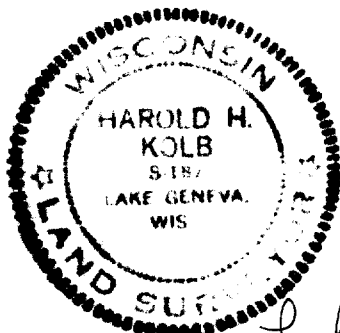

I, HAROLD H. KOLB, DO HEREBY CERTIFY THAT I HAVE
SURVEYED THE PROPERTY HEREON DESCRIBED ACCORDING
TO THE OFFICIAL RECORDS, AND THAT THE PLAT HEREON
IS A CORRECT REPRESENTATION OF THE LOT LINES.

Harold H. Kolb
HAROLD H. KOLB
WISCONSIN REGISTERED LAND SURVEYOR, S-187
DATE January 19, 1973

Lake View Park Misc Cont

117-372