


PLAT OF SURVEY -OF-

LOTS 49, 50, AND 51, BLOCK 2, LAKEVIEW PARK, TOWN OF LINN, WALWORTH COUNTY, WISCONSIN.

SURVEY FOR: DEBBIE MCNICHOLS

SURVEY ADDRESS: W3833 LAKEVIEW PARK DR.

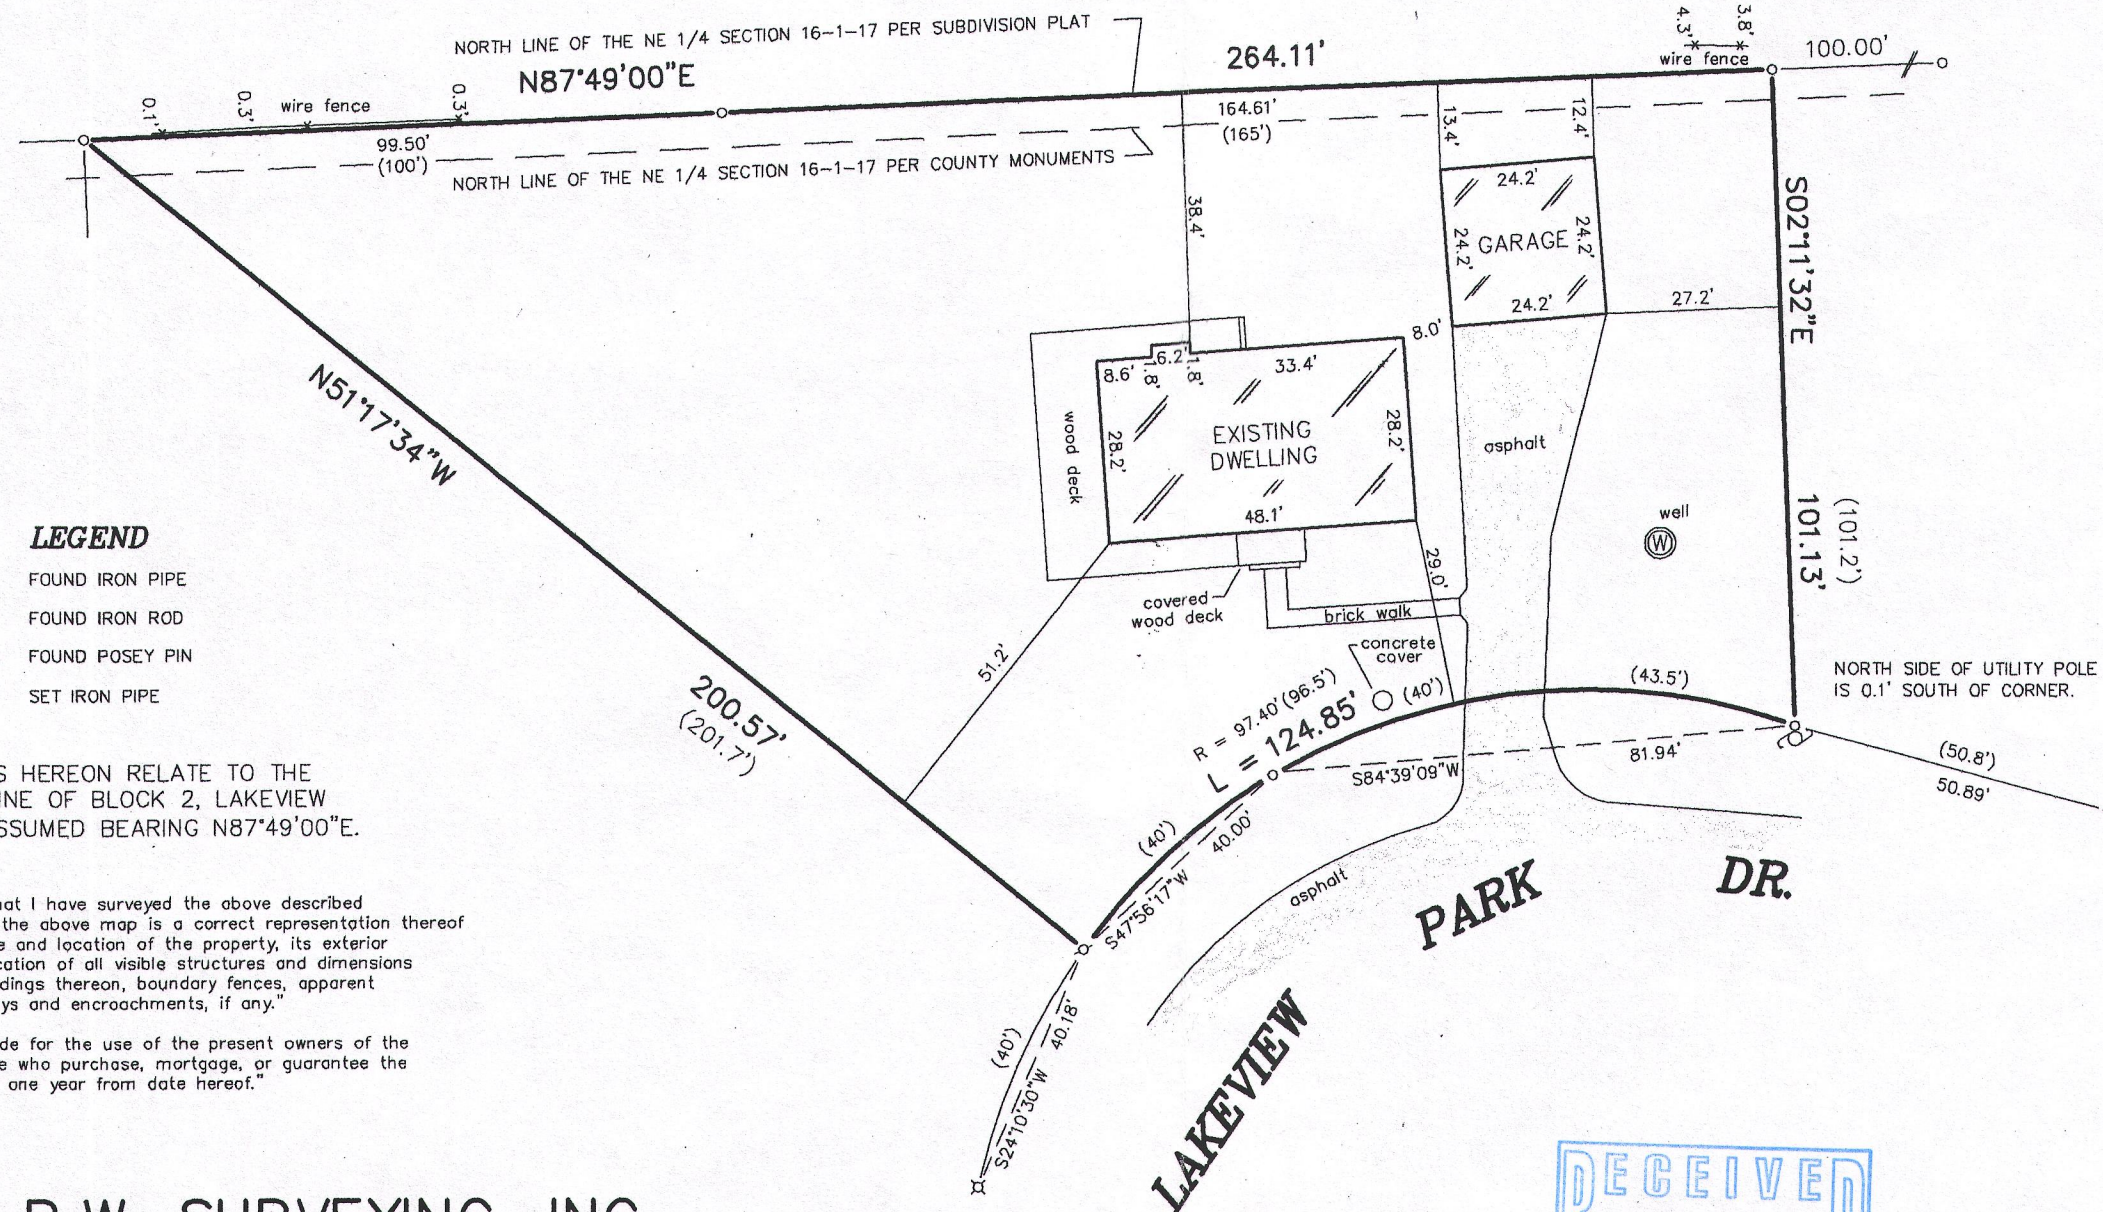

LEGEND

- FOUND IRON PIPE
- ✕ FOUND IRON ROD
- ✕ FOUND POSEY PIN
- SET IRON PIPE



BEARINGS HEREON RELATE TO THE
NORTH LINE OF BLOCK 2, LAKEVIEW
PARK. ASSUMED BEARING N87°49'00"E.

"I hereby certify that I have surveyed the above described
property and that the above map is a correct representation thereof
and shows the size and location of the property, its exterior
boundaries, the location of all visible structures and dimensions
of all principal buildings thereon, boundary fences, apparent
easements, roadways and encroachments, if any."

"This survey is made for the use of the present owners of the
property, and those who purchase, mortgage, or guarantee the
title thereto within one year from date hereof."

B.W. SURVEYING, INC.

LAND SURVEYS
MAPPING AND PLANNING
412 N. PINE STREET
BURLINGTON, WI 53105
(262)-767-0225

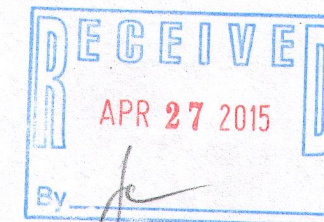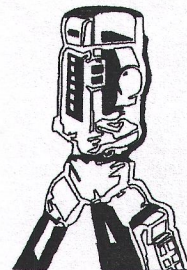

THIS IS NOT AN ORIGINAL PRINT
UNLESS THIS SEAL IS RED.

Robert J. Wetzel
ROBERT J. WETZEL S-1778

MARCH 23, 2015
DATE

8886
JOB NUMBER

ILVP-8C

117-3763