

PREPARED FOR:
KEVIN WHITE
482 OAKDALE AVE.
GLENCOE, IL 60022


PLAT OF SURVEY

-OF-

LOT 10, GENEVA OAKS, A SUBDIVISION LOCATED IN GOV'T LOT 3, INT HE NW 1/4 OF SECTION 4, T1N, R17E, TOWN OF LINN, WALWORTH COUNTY, WISCONSIN


LYNCH & ASSOCIATES
ENGINEERING CONSULTANTS, LLC.
405 SKYLINE DRIVE, SUITE C
LAKE GENEVA, WI 53147
(262) 248-3697

C/L GENEVA OAKS TRAIL
(60' WIDE)

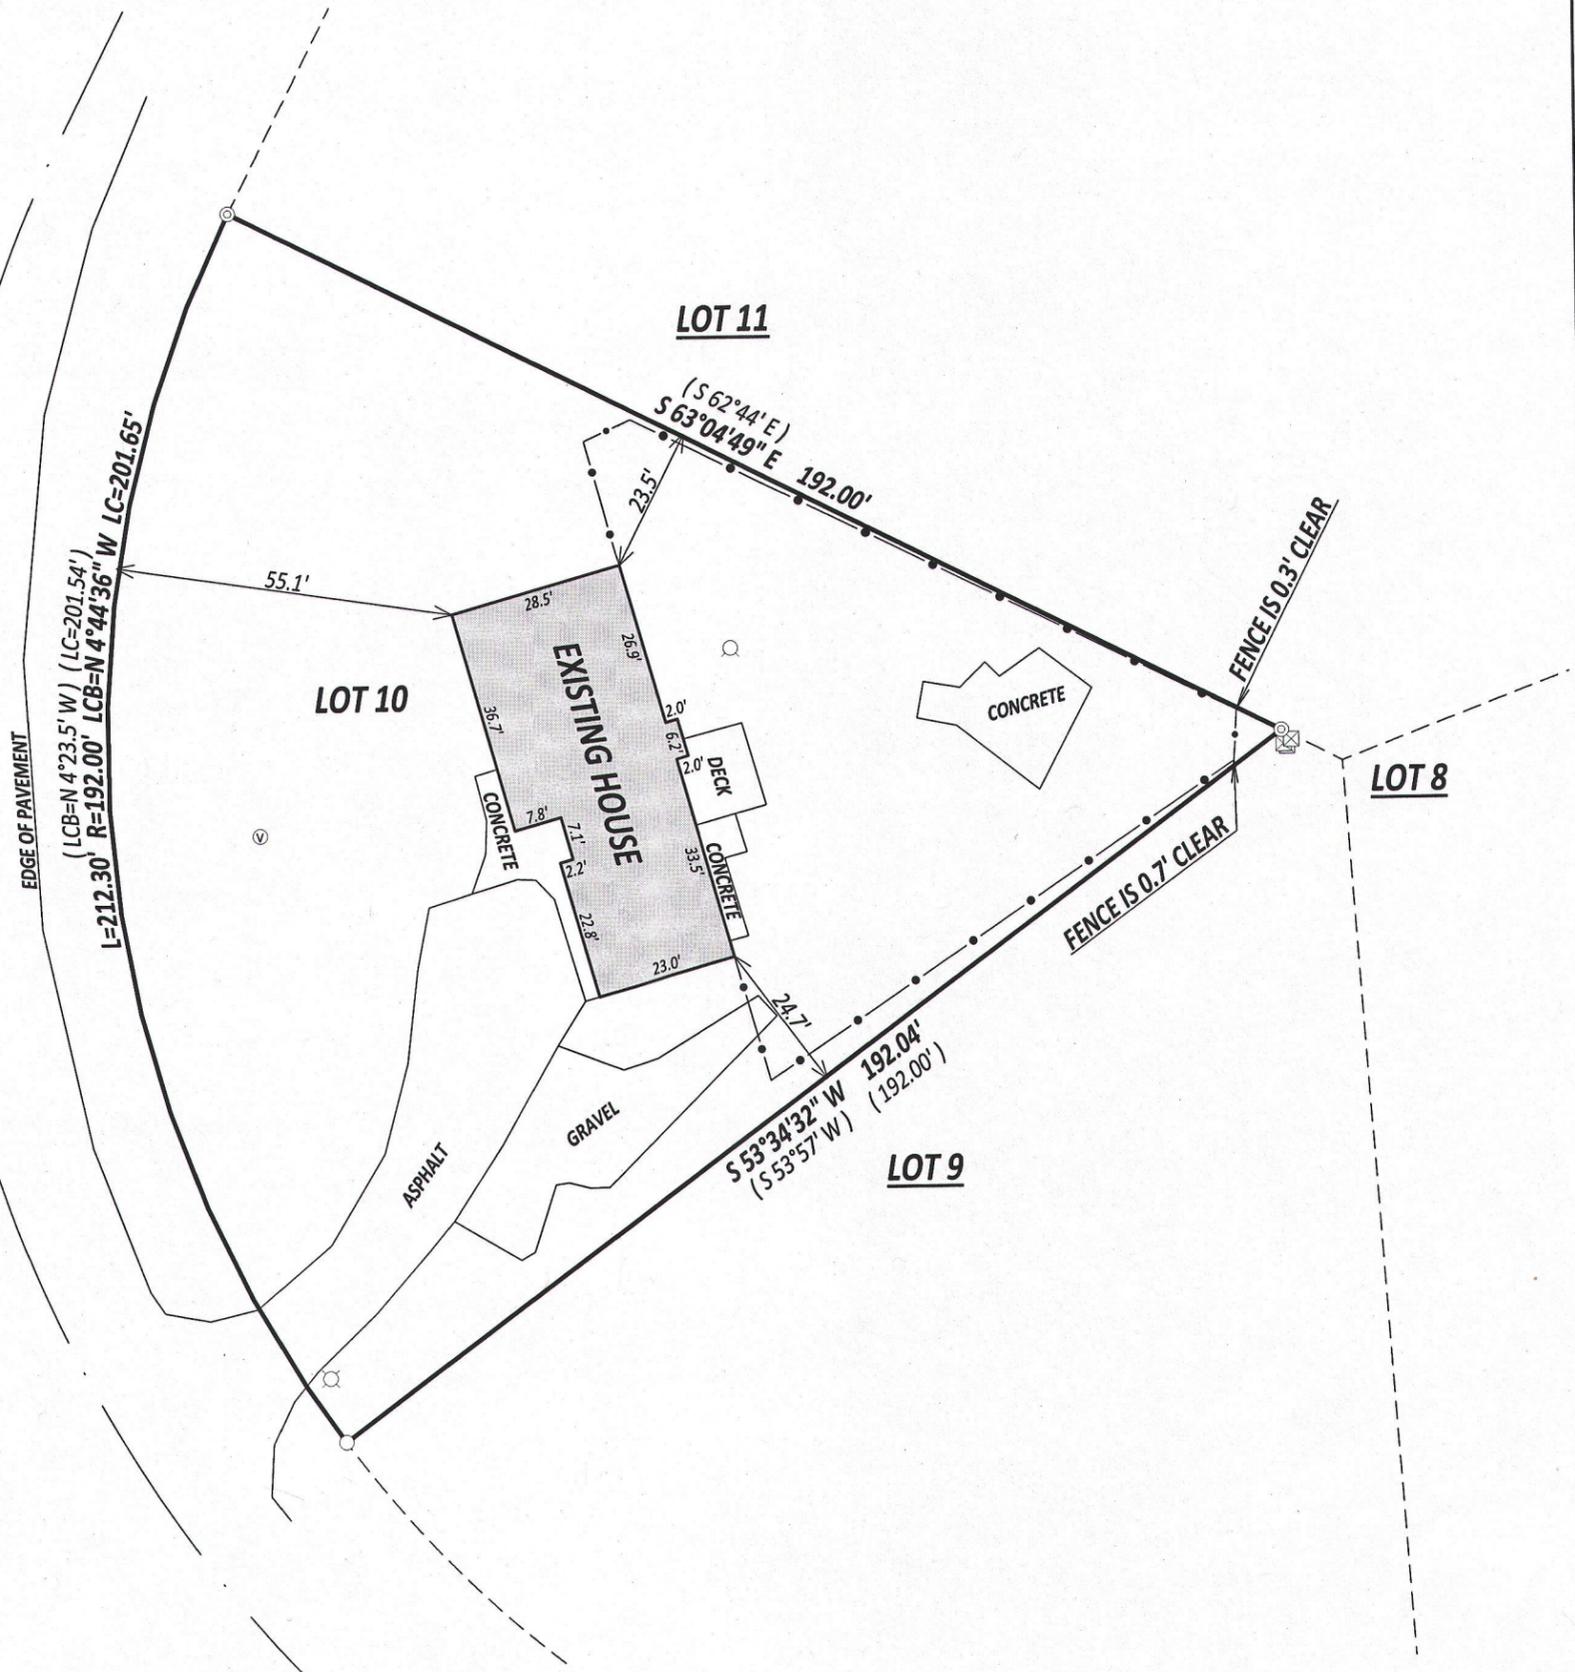


LEGEND

- FOUND 1.5" IRON PIPE
- ⊙ FOUND 2" IRON PIPE
- (XX) RECORDED AS
- FENCE
- WELL
- ⊙ SEPTIC VENT
- ⊠ UTILITY PEDISTAL
- LIGHT POLE

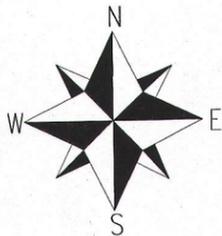

BEARINGS HEREON REFERENCED TO THE WISCONSIN COUNTY COORDINATE SYSTEM, WALWORTH COUNTY ZONE.

SCALE 1" = 30'

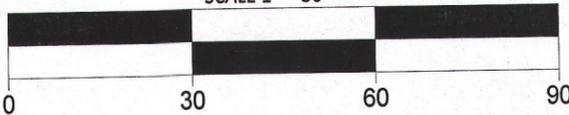

NOTE:

No title commitment or results of a title search were provided to this office pertaining to this survey. This Plat Of Survey may not reflect easements of record, encumbrances, restrictions, ownership, title evidence, or other facts that a current and accurate title search may disclose.

I have surveyed the above-described property and the above map is a true representation thereof and shows the size and location of the property, its exterior boundaries, the location and dimensions of all structures thereon, fences apparent easements and roadways and visible encroachments, if any.

This survey is made for the exclusive use of the present owners of the property, and also those who purchase, mortgage, or insure the title thereto within one (1) year from date hereof; and as to them I warrant the accuracy of said survey map.



DATED THIS 17th DAY OF APRIL, 2015

KENNETH B. MEHRING S - 2838
Wisconsin Registered Land Surveyor
(original if signed in red)

JOB # 15-542
TAX ID # IGO 00010

IGO-10

117-3771