


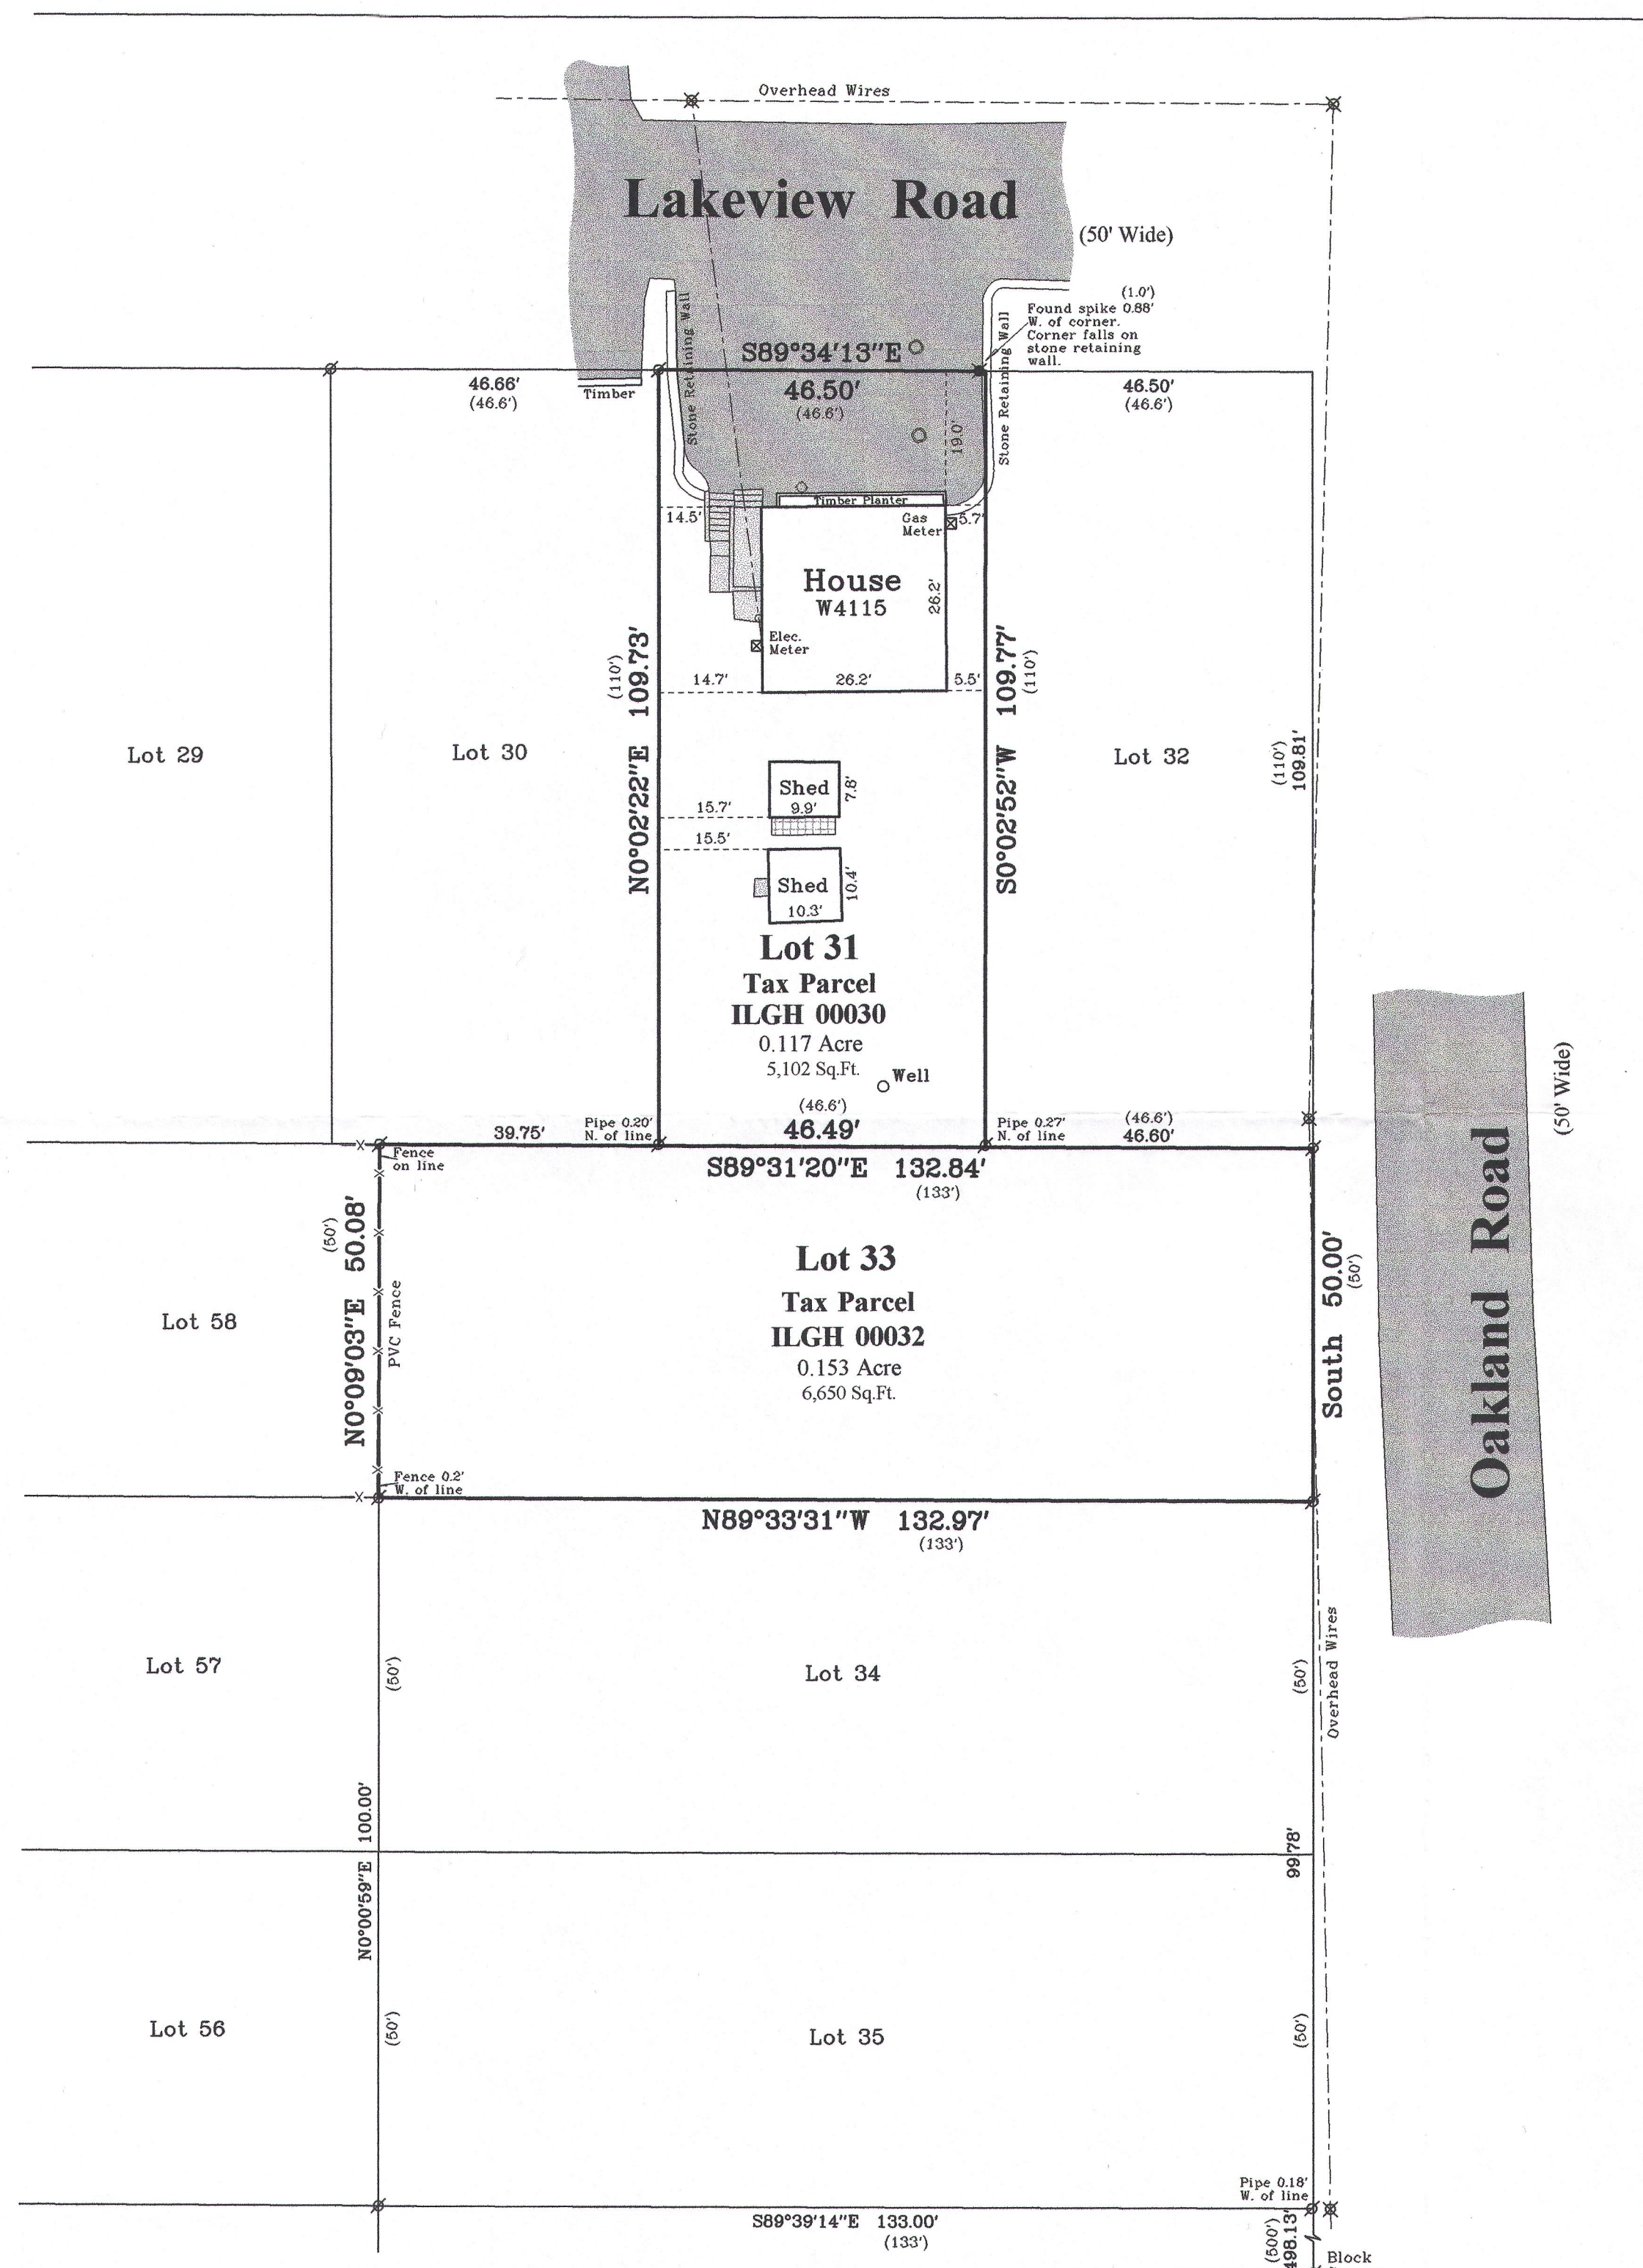




Plat of Survey

of

Lots 31 & 33 of Lake Geneva Highlands,

a subdivision located in Government Lot 1 in the Southeast 1/4 of Section 8,
Town 1 North, Range 17 East, Town of Linn, Walworth County, Wisconsin.

Surveyed for: **Clair Law Offices, S.C.**
617 East Walworth Avenue
Delavan, Wisconsin. 53115

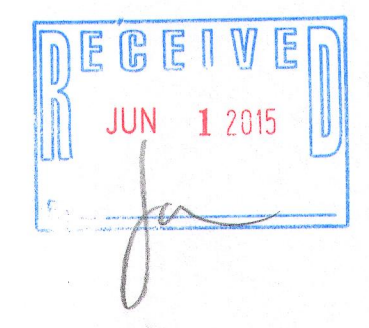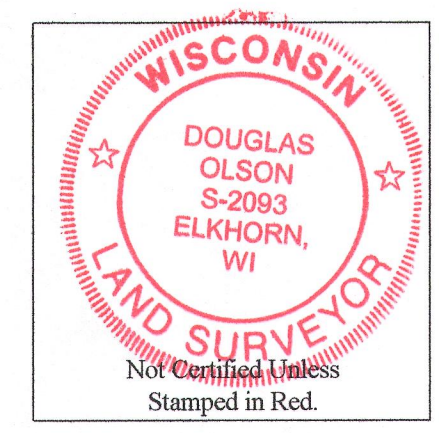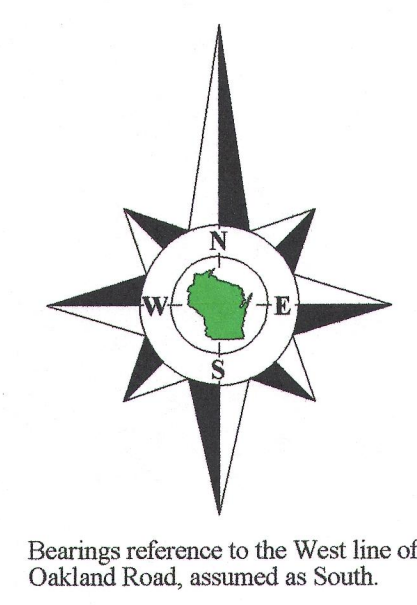

- Notes:**
- 1) This survey plat is not certified unless signed and sealed in red ink.
 - 2) This survey is subject to Wisconsin lien laws. This Plat of Survey is the notice of intent to file lien. Lien waiver required.

Copyright 2014 by Jensen & Olson Land Surveying, LLC.


All rights reserved. No part of this survey plat may be reproduced or transmitted in any form by any means - graphic, electronic, or mechanical, including photocopying, tracing, or information storage and retrieval systems - without permission in writing from Douglas G. Olson, Jensen & Olson Land Surveying, LLC.

I hereby certify that I have surveyed the above described property and the map hereon is correct to the best of my professional knowledge and belief and shows the size and location of the property, its exterior boundaries, the location and dimensions of all visible structures thereon, boundary fences, apparent easements and roadways and visible encroachments, if any.

This survey is made for the exclusive use of the present owners of the property, and also those who purchase, mortgage or guarantee title thereto, within one year from the date hereof.

Douglas G. Olson
Wisconsin Registered Land Surveyor - 2093

Survey Date: August 28, 2014.
Revisions:

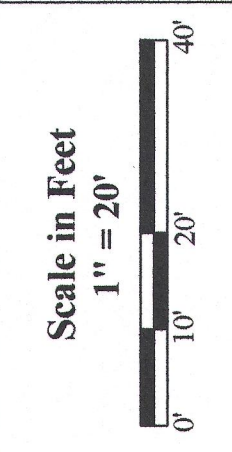

Jensen & Olson Land Surveying, LLC
45 South Wisconsin Street * P.O. Box 322 * Elkhorn, Wisconsin. 53121
Telephone: (262) 723-3434 * Facsimile: (262) 723-8044
Email: jensen.olson@elknet.net

- Legend**
- Found Iron Pipe
 - Found Nail
 - Recorded Information
 - Utility Pole
 - Metal Cover
 - Asphalt Surface
 - Patio Blocks
 - Water Valve
 - Pedestal
 - Concrete
 - PVC Pipe

Sheet 1 of 1 Sheets
Drawing Name: t1m17e-2014095-2014099Plat.sj
Job Reference Number
2014.099
2014.099

ILGH - 30
ILGH - 32
117- 3783