

Center 1/4 Corner
Section 18-1-17.
N. 202.327.01
E. 2,395,820.88

Sybil Lane
(15' Wide)

N1°54'39"W 49.99'

49.99'
(50')

**Lot 45
Tax Parcel
ICA 00043**

0.069 Acre
2,995 Sq.Ft.

Lot 44

N87°32'15"E 59.92'

**Poured
Concrete
Foundation**
Located 01-07-13

**House
N1522**

S87°32'43"W 59.92'

Lot 48

N89°23'02"E 803.62'

N89°23'02"E 1316.33'

N89°30'42"E 2636.77'
(N89°30'42"E 2636.77') State Plane


Plat of Survey

of


Lot 45 of Ross D. Sill's Subdivision of Large Lots I and II, Camp Sybil,

a subdivision located in the Northeast 1/4 of Section 18, Town 1 North,
Range 17 East, Town of Linn, Walworth County, Wisconsin.

Surveyed for: **Glenn Morgenroth**
18N101 Hidden Hills Trail
West Dundee, Illinois. 60118

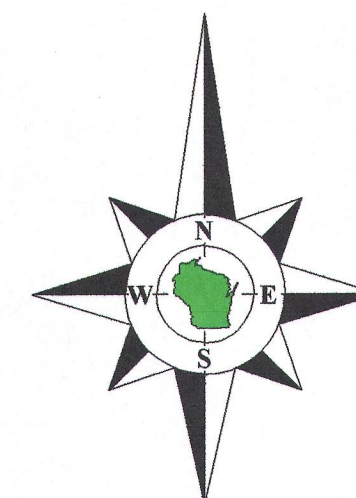

Bearings reference to the Wisconsin State
Plane Coordinate System, South Zone.

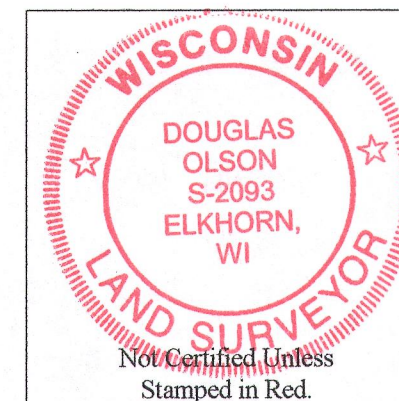

Notes:

- 1) This survey plat is not certified unless signed and sealed in red ink.
- 2) This survey is subject to Wisconsin lien laws. This Plat of Survey is the notice of intent to file lien. Lien waiver required.

Copyright 2012 by Jensen & Olson Land Surveying, LLC.

All rights reserved. No part of this survey plat may be reproduced or transmitted in any form by any means - graphic, electronic, or mechanical, including photocopying, tracing, or information storage and retrieval systems - without permission in writing from Douglas G. Olson, Jensen & Olson Land Surveying, LLC.

I, Douglas G. Olson, Wisconsin Registered Land Surveyor, do hereby certify that this survey was performed by me, or under my direction in full compliance with the owner's/agent's instructions and Chapter A-E 7 of the Wisconsin Administrative Code "Minimum Standards for Property Surveys", and that this map is an accurate representation thereof to the best of my knowledge and belief.

Douglas G. Olson
Wisconsin Registered Land Surveyor - 2093

South 1/8 Corner of
the Northeast 1/4 of
Section 18-1-17.

East 1/4 Corner
Section 18-1-17.
N. 202,349.48
E. 2,398,457.54

- Legend**
- Found County Section Corner
 - Found Iron Pipe, 1" dia.
 - Set Iron Pipe, 1" dia.
 - Recorded Information
 - Utility Pole
 - Concrete Cover
 - Asphalt Surface
 - Gravel Surface
 - Brick Pavers
 - Septic Vent
 - Concrete

Sheet 1 of 1 Sheets

Job Reference Number

2012.104

2012.104


Jensen & Olson Land Surveying, LLC

45 South Wisconsin Street * P.O. Box 322 * Elkhorn, Wisconsin. 53121
Telephone: (262) 723-3434 * Facsimile: (262) 723-8044

Email: jensen.olson@elknet.net

Survey Date: Sept. 14, 2012.
Revisions: No. 1 - Proposed Addn.
No. 2 - Addition @ 8' from
Property line
No. 3 - Foundation
No. 4 - Lot number typo

Scale in Feet
1" = 10'

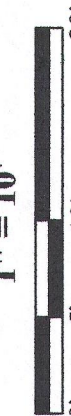

ICA - 43

117-3792