

PLAT OF SURVEY

- OF -

LOT 18 OAK SHORES SUBDIVISION, LOCATED IN
SECTION 8, TOWN 1 NORTH, RANGE 17 EAST,
TOWN OF LINN, WALWORTH COUNTY, WISCONSIN.

SURVEY FOR: JIM SYKORA
SURVEY ADDRESS: N 1530 OAK SHORE LANE

FOUNDATION RECERTIFICATION

I HEREBY CERTIFY THAT THE EXISTING CONCRETE
FOUNDATION FOR PROPOSED ADDITION AS SHOWN
ON THIS PLAT OF SURVEY IS LOCATED AS SHOWN
[THUS], DATED THIS 3rd DAY OF DECEMBER, 2009

Franklin J. Lehman
FRANKLIN J. LEHMAN S-2211


I hereby certify that I have surveyed the above described property
and that the above map is a correct representation thereof and
shows the size and location of the property, its exterior boundaries,
the location of all visible structures and dimensions of all principal
buildings thereon, boundary fences, apparent easements, roadways
and encroachments, if any.

This survey is made for the use of the present owners of the property,
and those who purchase mortgage or guarantee the title thereto within
one year from date hereof.

LIBERTY LAND SURVEYING

789 CHICORY ROAD
BURLINGTON, WISCONSIN 53105
(262)901-5116 (262)767-8786

50' WIDE
OAK SHORE LANE

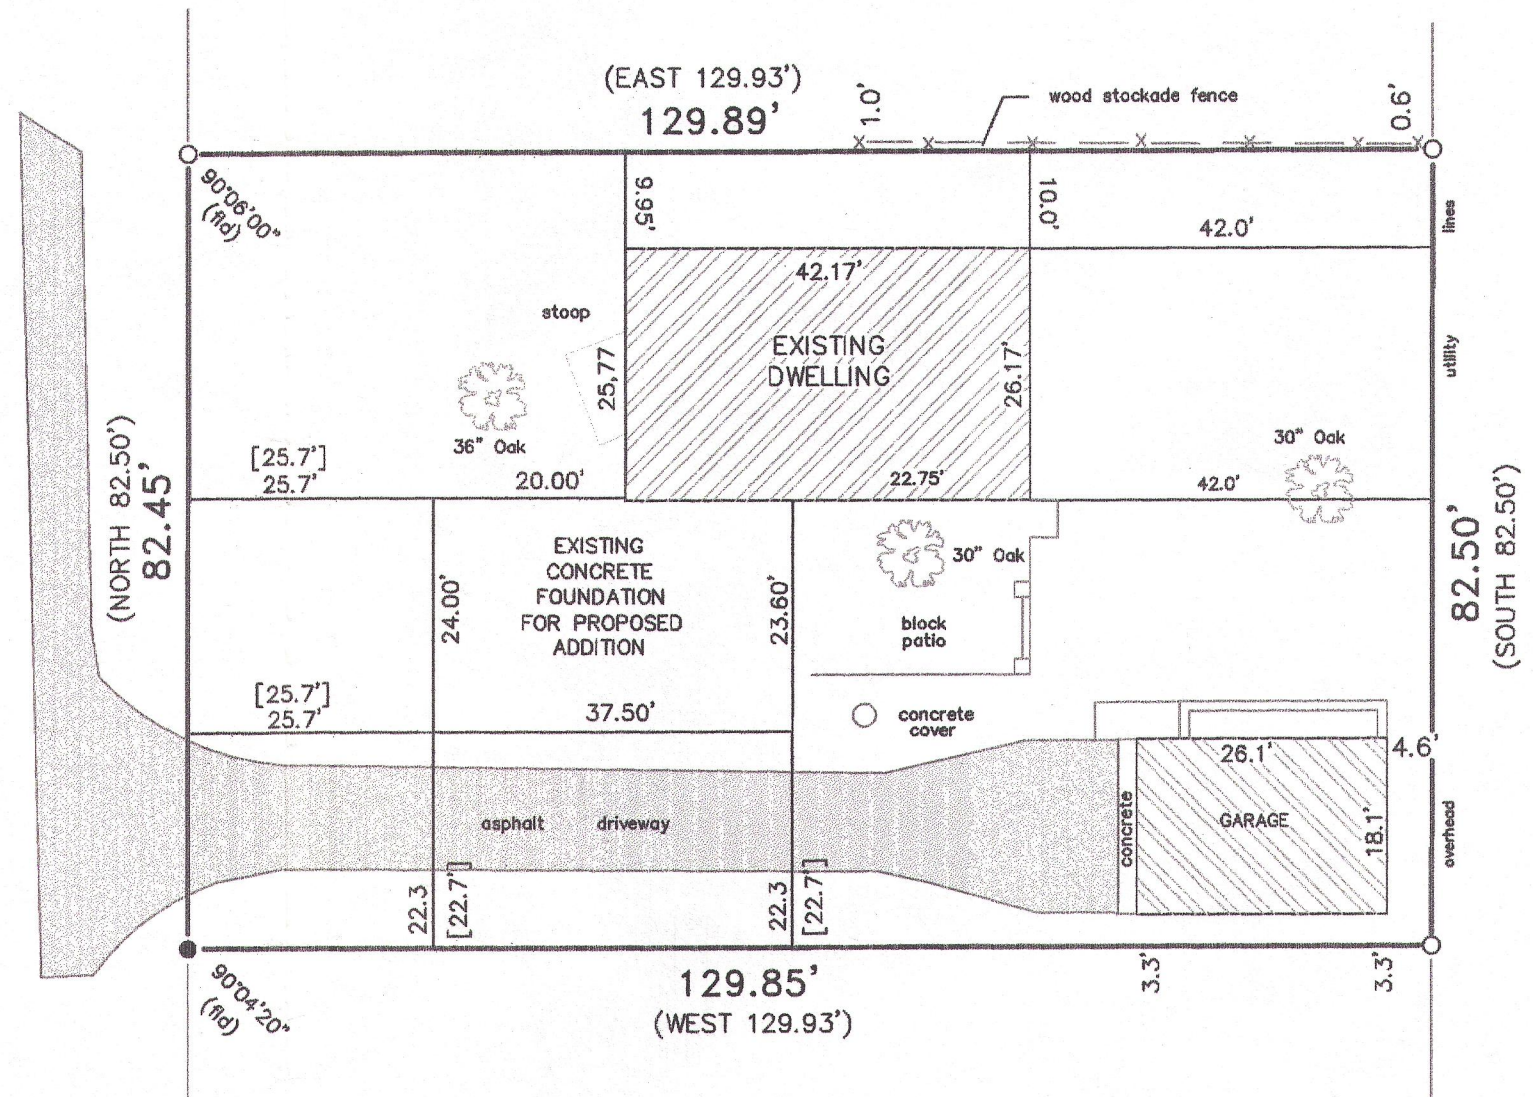


LEGEND

- FOUND IRON PIPE
- FOUND IRON ROD
- () RECORDED AS

SCALE: 1" = 20'



THIS IS NOT AN ORIGINAL PRINT
UNLESS THIS SEAL IS RED

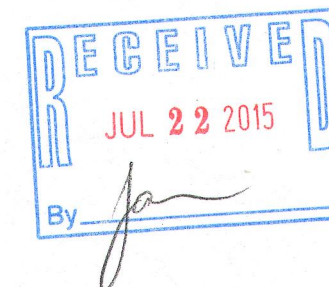

Franklin J. Lehman
FRANKLIN J. LEHMAN S-2211
REV: 11-21-09
9-27-09 DATE 090901 JOB NUMBER

10-18 117-3817