
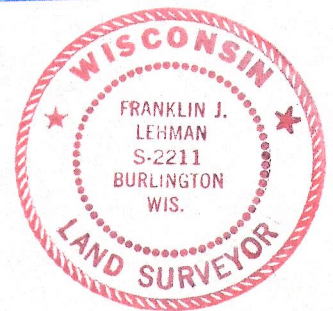
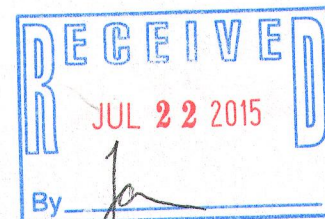


PLAT OF SURVEY -OF-

LOTS 55 AND 58 OF LAKE GENEVA BEACH, A SUBDIVISION LOCATED IN TOWN 1 NORTH,
RANGE 17 EAST, WALWORTH COUNTY, WISCONSIN.

SURVEY FOR: KATHERINE M. DOWNS
SURVEY ADDRESS: 1735 SPRING ROAD
TAX PARCEL # ILGB 00049

North line of proposed garage staked as shown
with 5 foot offset stakes set along East line

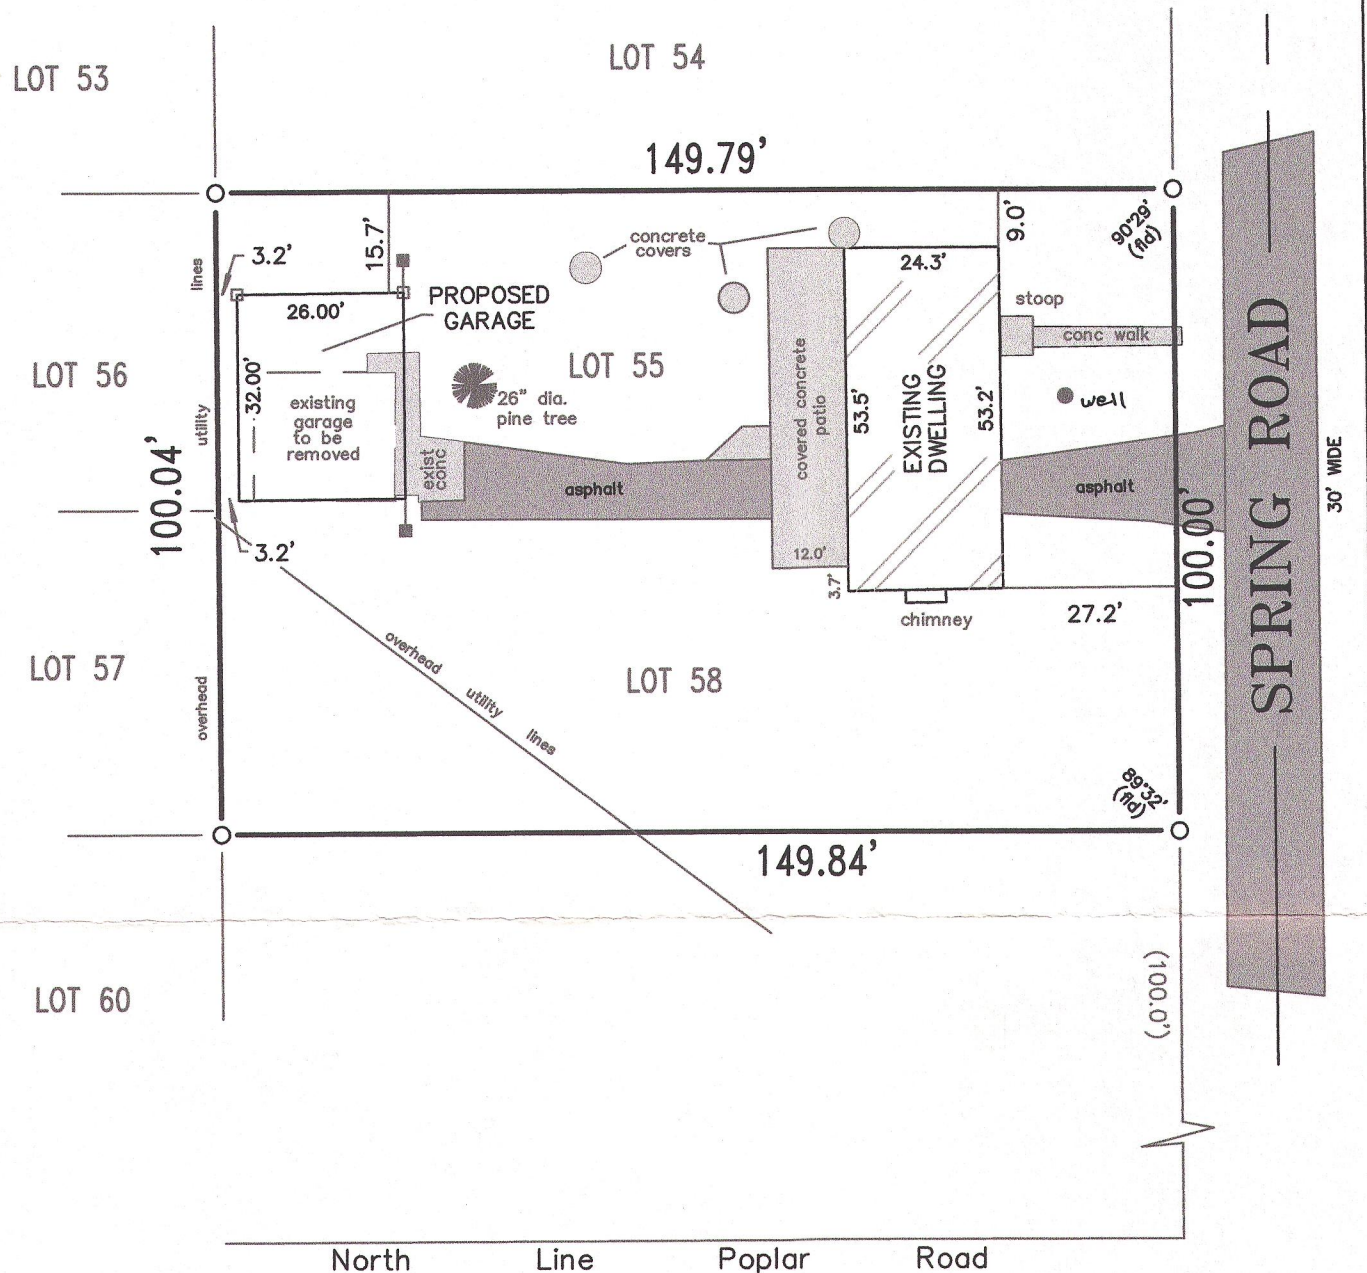

THIS IS NOT AN ORIGINAL PRINT
UNLESS THIS SEAL IS RED

SCALE: 1" = 30'

LEGEND

- FOUND IRON PIPE
- () RECORDED AS
- ▣ SET WOOD STAKE
- SET WOOD OFFSET STAKE

Franklin J. Lehman
FRANKLIN J. LEHMAN S-2211

SEPT. 15, 2010 100902
DATE JOB NUMBER

LIBERTY LAND SURVEYING

789 CHICORY ROAD
BURLINGTON, WISCONSIN 53105
(262)210-7260 (262)767-8786

ILGB-49

117-3819