




PREPARED FOR
PREMIER HOMES 1 INC
P.O. BOX 100
WILLIAMS BAY, WI. 53191

PLAT OF SURVEY

- OF -

PATHFINDER SURVEYING INC.
(formerly)
J.K. SURVEYING INC.
P.O. BOX 322
LAKE GENEVA, WI. 53147
WWW.PATHFINDERSURVEYING.NET
262-248-8303

LOTS 42, 43 AND 44, BLOCK " F " CISCO BEACH, A SUBDIVISION LOCATED
IN THE NE 1/4 OF SECTION 5, TOWN 1 NORTH, RANGE 17 EAST, TOWN OF
LINN, COUNTY OF WALWORTH AND STATE OF WISCONSIN.

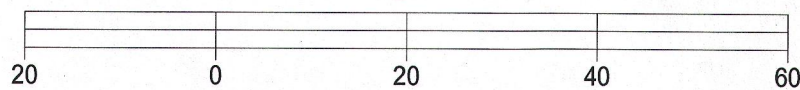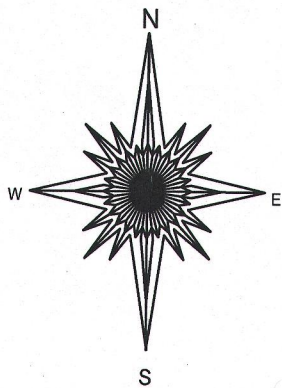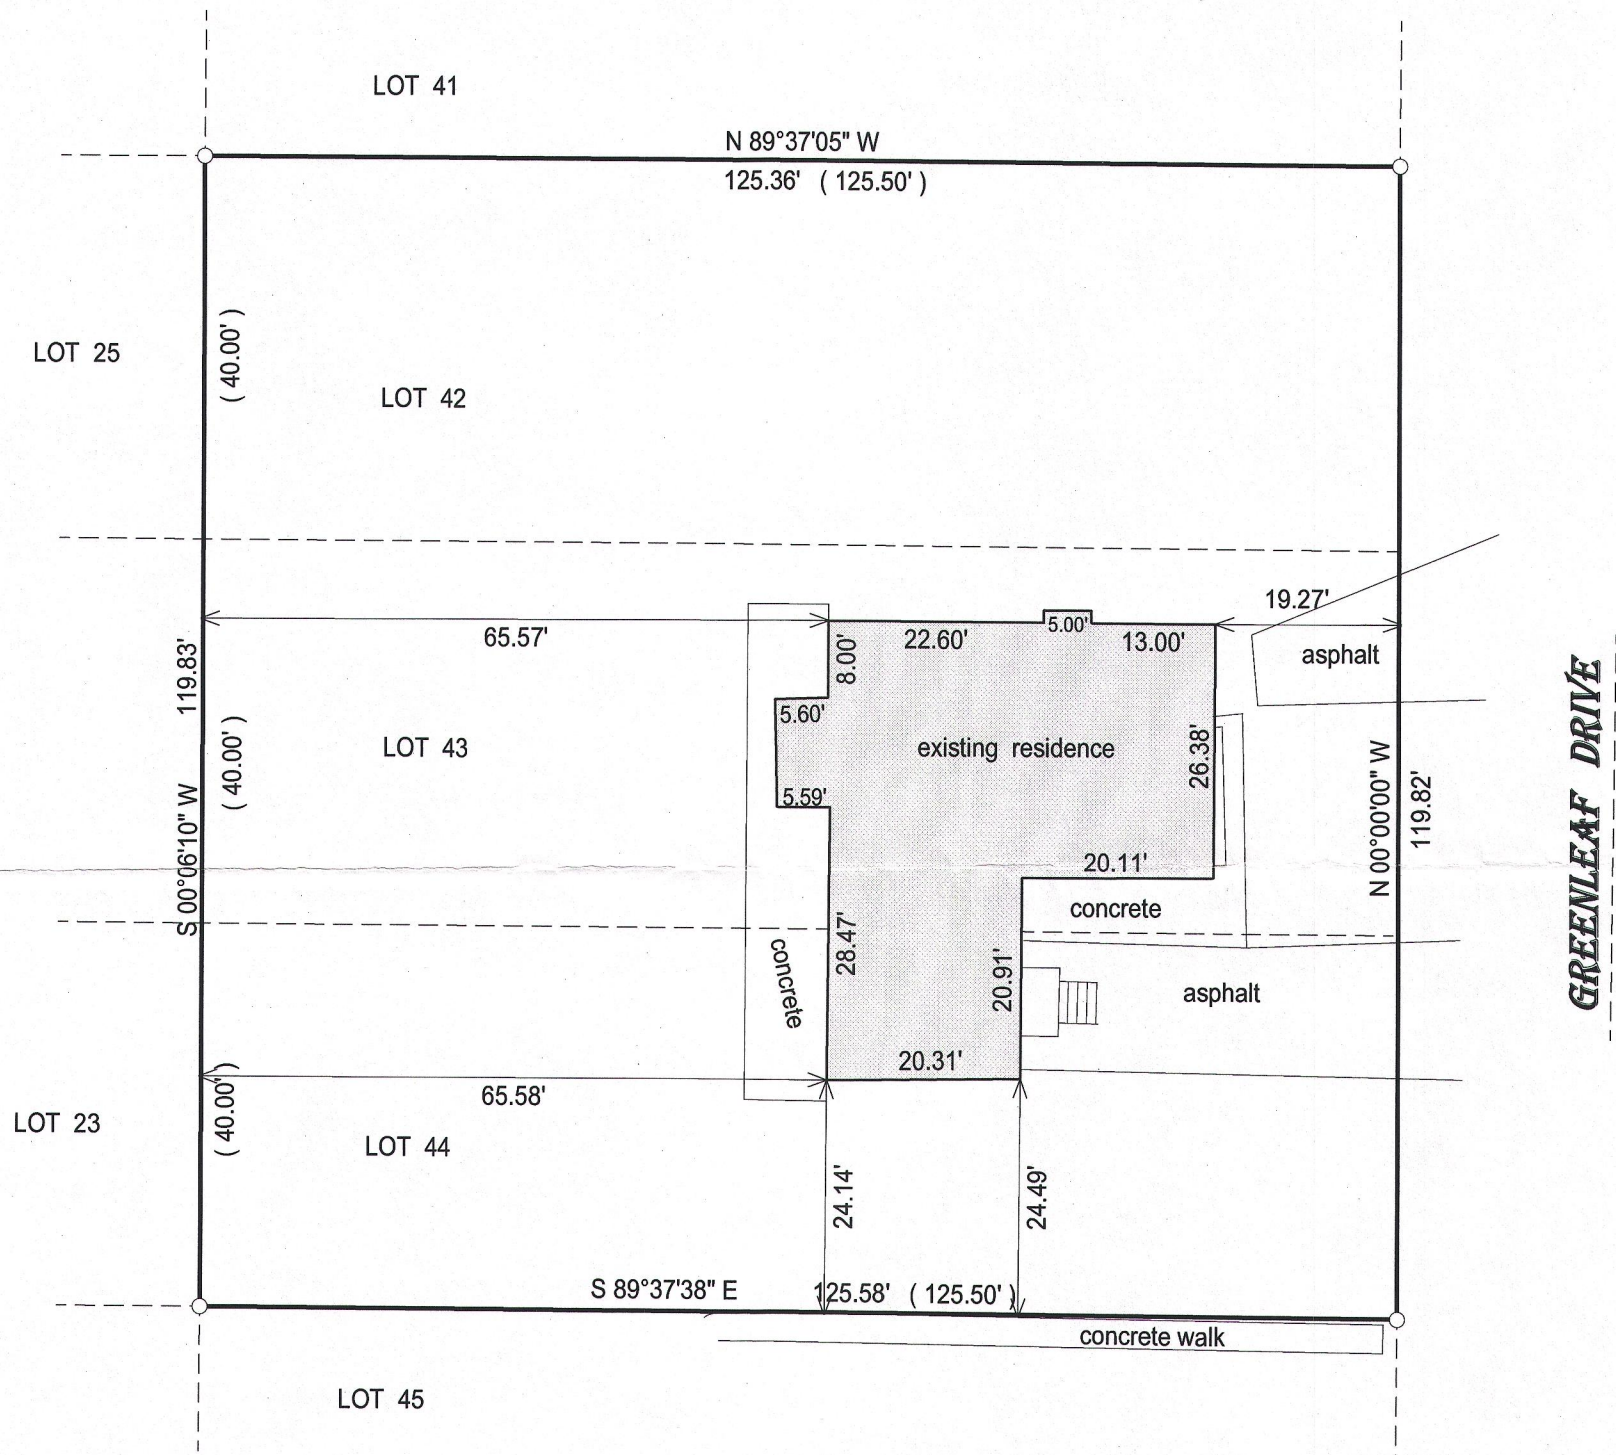


BASIS OF BEARING OF THIS PLAT: THE WEST LINE OF GREENLEAF
WAS ASSUMED TO BEAR NORTH.

I hereby certify that I have surveyed the above- described property and the
above map is a true representation thereof and shows the size and
location of the property, its exterior boundaries, the location and
dimensions of all structures thereon, fences, apparrant easements and
roadways and visible encroachments if any.

This survey is made for the present owners of the property, and those who
purchase, mortgage, or guarantee the title thereto, within one year from
the date hereof.

DATED THIS 29TH DAY OF MAY, 2015.

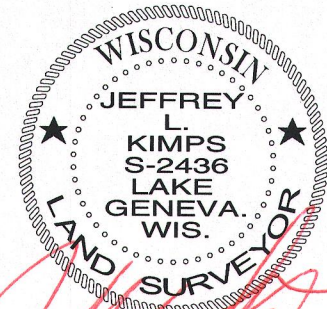

JEFFREY L KIMPS S - 2436
Wisconsin Registered Land Surveyor
(original if signed in red)

() = recorded as

□ = found iron bar

○ = found iron pipe

● = set iron pipe

■ = set iron bar

SCALE 1" = 20'

JOB # 15-163

TAX ID # ICI00142