

FARRIS, HANSEN & ASSOCIATES, INC.

ENGINEERING — ARCHITECTURE — SURVEYING
7 RIDGWAY COURT — P.O. BOX 437 — ELKHORN, WISCONSIN 53121
PHONE: (262) 723-2098 FAX: (262) 723-5886

GRID NORTH
WISCONSIN STATE PLANE
COORDINATE SYSTEM
SOUTH ZONE (NAD-27)
LINE OF THE 1/4 OF
SECTION ??-??-?? BEARS
??-??-??-??-??

PLAT OF SURVEY



LOT 7 OF LAKE GENEVA CLUB
LOCATED IN PART OF THE SE 1/4 OF THE NW 1/4 OF
SECTION 18, TOWN 1 NORTH, RANGE 17 EAST,
WALWORTH COUNTY, WISCONSIN

— WORK ORDERED BY —
RASMUSSEN LAW
PO BOX 250
WALWORTH, WI 53184

LEGAL DESCRIPTION FROM TITLE COMMITMENT:

Lot 7 of the plat of Lake Geneva Club as recorded in the office of the Register of Deeds in and for Walworth County, Wisconsin in Volume 7 of Plats at page 78 in Town of Linn, County of Walworth, State of Wisconsin.

Tax Key No: ILGC 00005

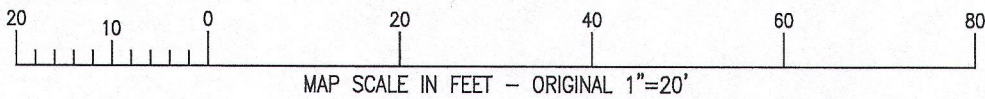
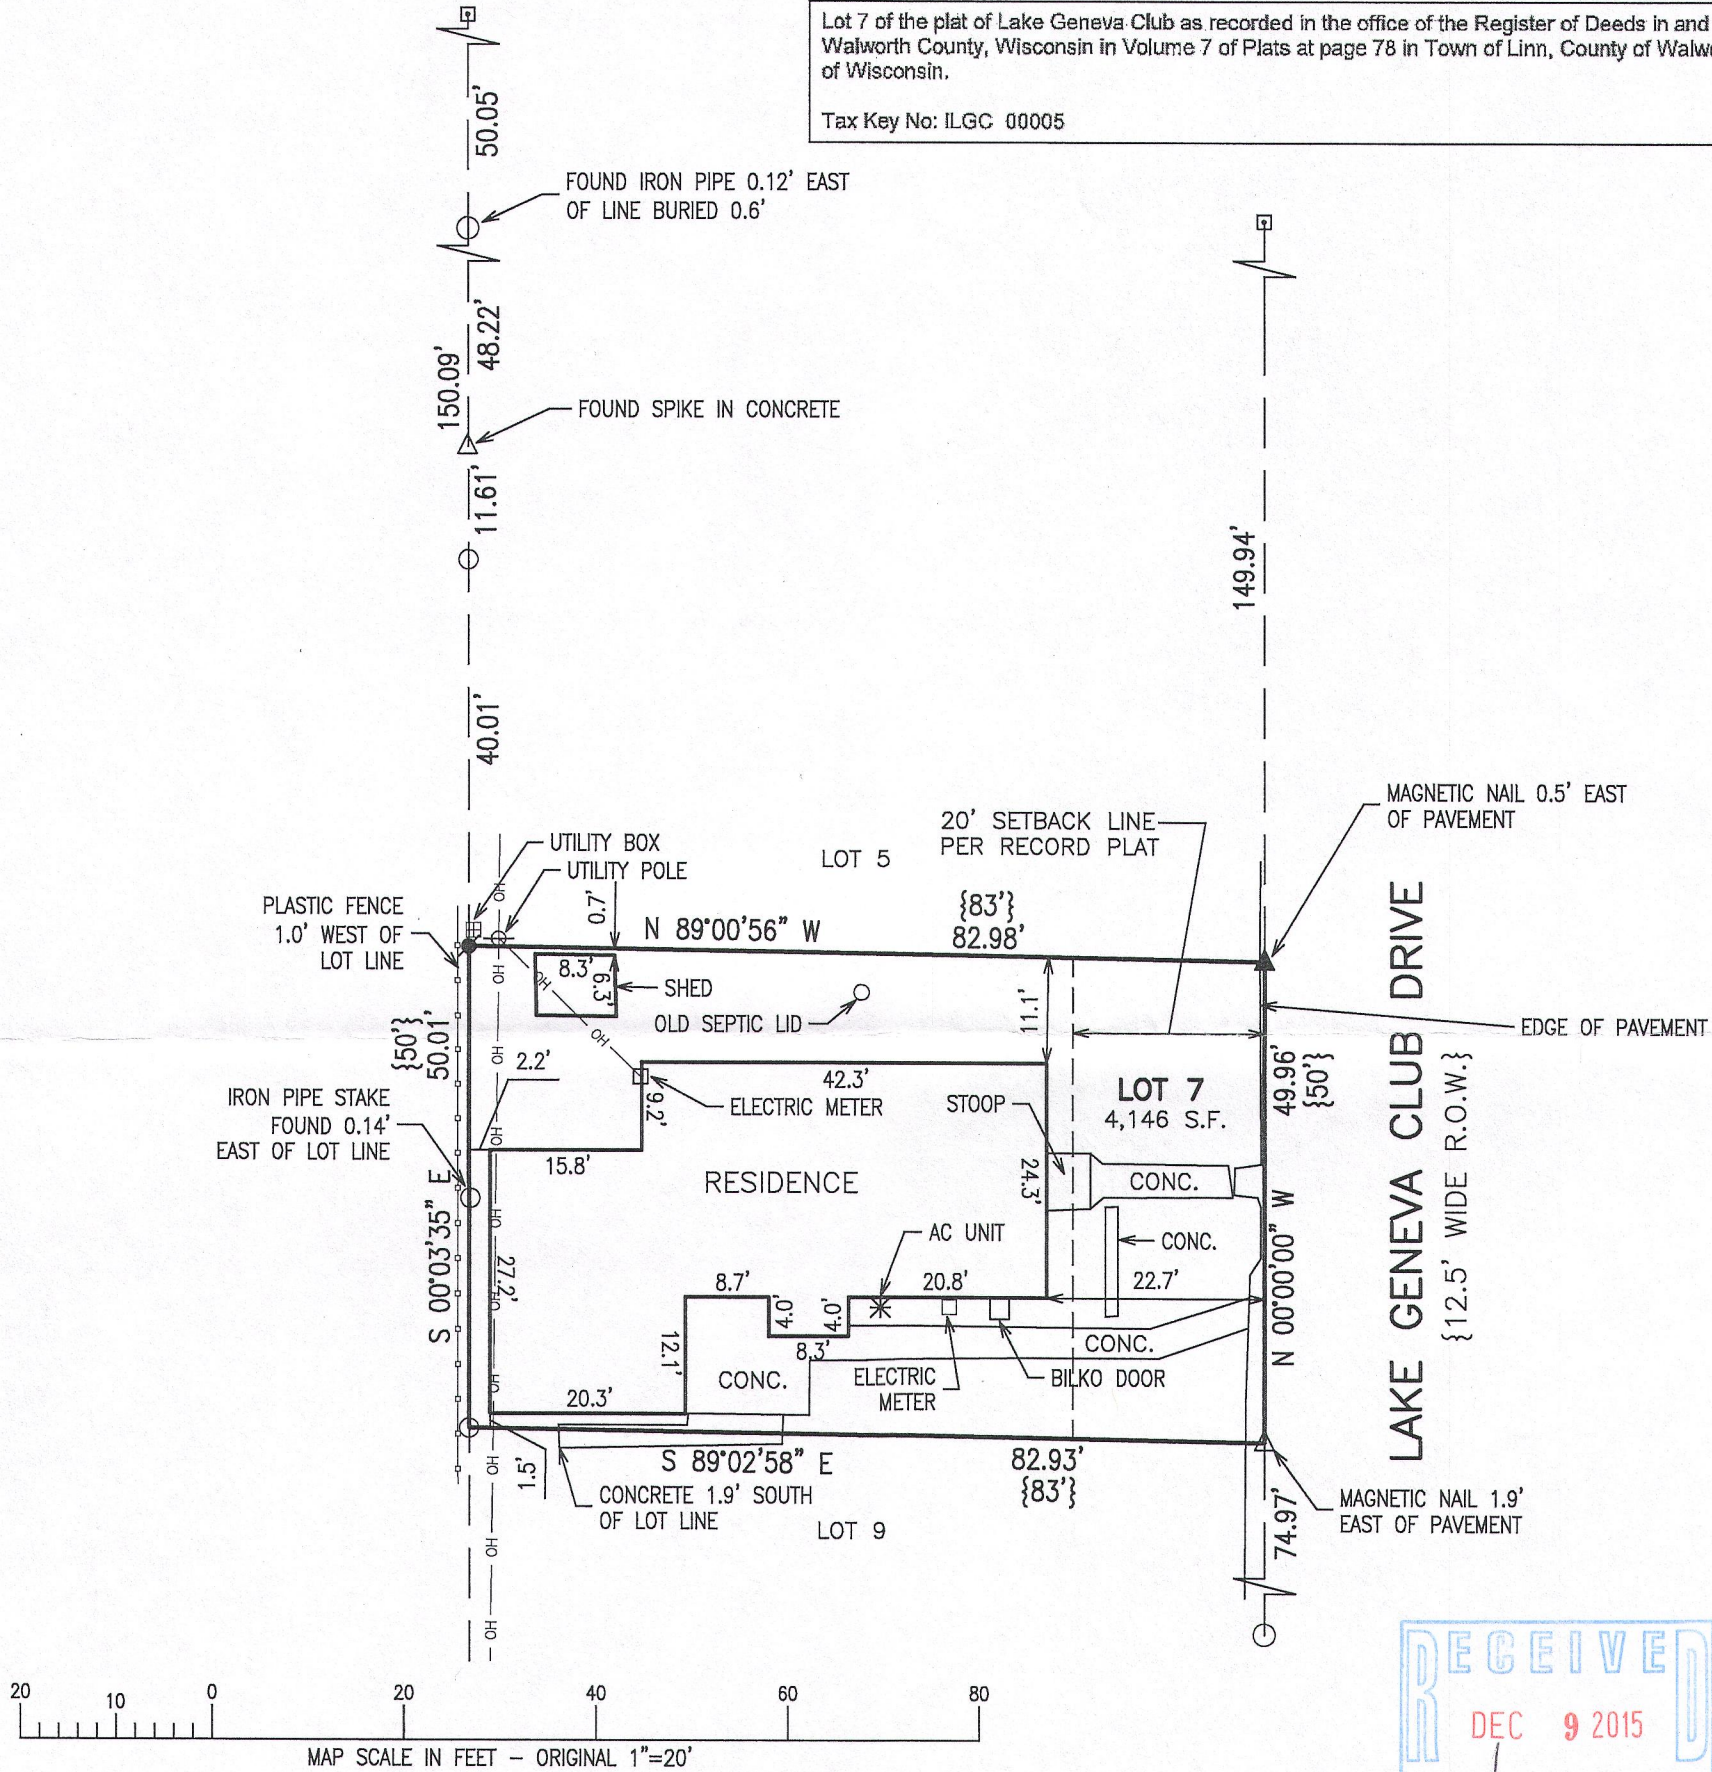


NOTE: COPIES OF THIS MAP TO WHICH THE FOLLOWING CERTIFICATE WILL APPLY SHOW THE SURVEYOR'S ORIGINAL SEAL AND SIGNATURE IN RED INK. COPIES BY ANY OTHER MEANS MAY HAVE ALTERATIONS WHICH DO NOT REPRESENT THE SURVEYOR'S WORK PRODUCT.

I HEREBY CERTIFY THAT THE ABOVE DESCRIBED PROPERTY HAS BEEN SURVEYED UNDER MY DIRECTION AND THAT THE ABOVE MAP IS A TRUE REPRESENTATION THEREOF AND SHOWS THE SIZE AND LOCATION OF THE PROPERTY, ITS EXTERIOR BOUNDARIES, THE LOCATION OF ALL VISIBLE STRUCTURES, AND DIMENSIONS OF ALL PRINCIPLE BUILDINGS THEREON, BOUNDARY FENCES, APPARENT EASEMENTS, ROADWAYS, AND VISIBLE ENCROACHMENTS, IF ANY. THIS SURVEY IS MADE FOR THE USE OF THE PRESENT OWNERS OF THE PROPERTY, AND ALSO THOSE WHO PURCHASE, MORTGAGE, OR GUARANTEE THE TITLE THERETO WITHIN ONE YEAR FROM THE DATE HEREOF.

DATED: SEPTEMBER 21, 2015

Peter S. Gordon
PETER S. GORDON P.L.S. 2101

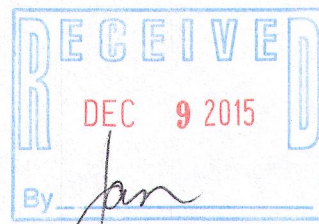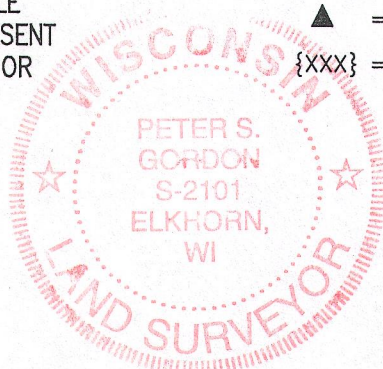

LEGEND

- = FOUND IRON PIPE STAKE
- = FOUND CONCRETE MONUMENT
- = SET IRON REBAR STAKE, 3/4" x 24" x 1.60 lbs/ft
- △ = FOUND "MAG NAIL" IN PAVEMENT
- ▲ = SET "MAG NAIL" IN PAVEMENT
- {XXX} = RECORDED AS

PROJECT: 9373
DATE: 9/21/2015
SHEET 1 OF 1