

HAROLD H. KOLB
REGISTERED PROFESSIONAL LAND SURVEYOR
LAW OFFICE, WISCONSIN

PLAT OF SURVEY OF

Lots 40-43, Edgewater Terrace
 Subdivision, T 1 N, R 17 E,
 Walworth County, Wisconsin.



N



SCALE: 1"=40'

LEGEND

- ◆ - IRON PIPE FOUND
- - IRON PIPE PLACED
- - IRON ROD FOUND
- x - SPINE
- () - Platted As

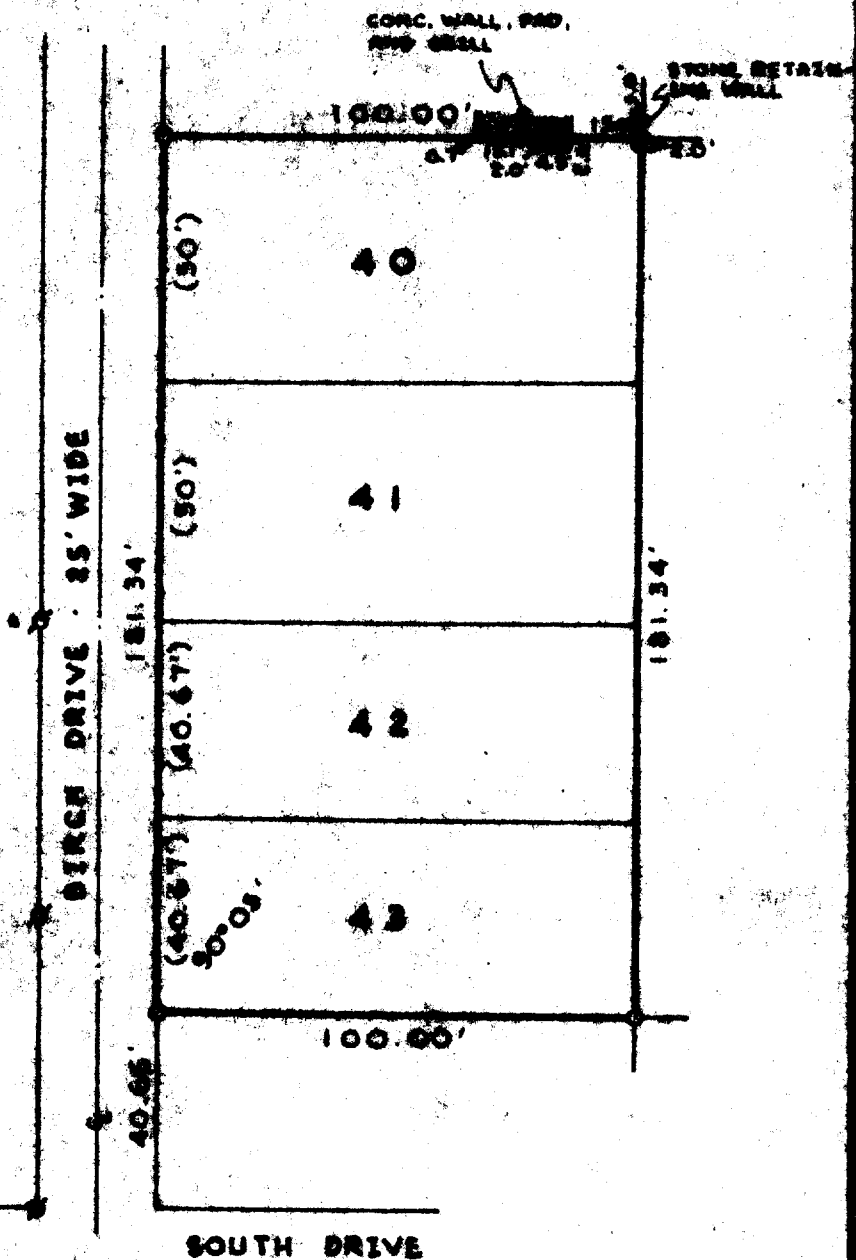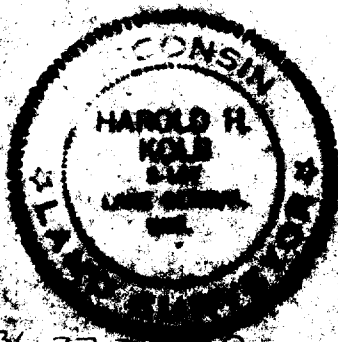

I, HAROLD H. KOLB, DO HEREBY CERTIFY THAT I HAVE
 SURVEYED THE PROPERTY HEREON DESCRIBED ACCORDING
 TO THE OFFICIAL RECORDS AND THAT THE PLAT HEREON
 IS A CORRECT REPRESENTATION OF THE LOT LINES.

Harold H. Kolb
 HAROLD H. KOLB
 REGISTERED LAND SURVEYOR, 8-187
 AUGUST 1, 1973