

LAND-MARK SURVEYING

Mark L. Miritz


Wisconsin Professional Land Surveyor S-2582

N9330 Knuteson Drive
Whitewater, WI 53190
Phone: (262) 495-3284
MARKMIRITZ@
LAND-MARKSURVEYING.COM

PLAT OF SURVEY

LOTS 68 THROUGH 74, INCLUSIVE, BLOCK 2, LAKEVIEW PARK SUBDIVISION, LOCATED IN THE NORTHEAST 1/4 OF THE NORTH-EAST 1/4 OF SECTION 16, TOWN 1 NORTH, RANGE 17 EAST, TOWN OF LINN, WALWORTH COUNTY, WISCONSIN.

ORDERED BY: MARK LARKIN
KEEFE REAL ESTATE
751 GENEVA PKWAY
LAKE GENEVA, WI 53147

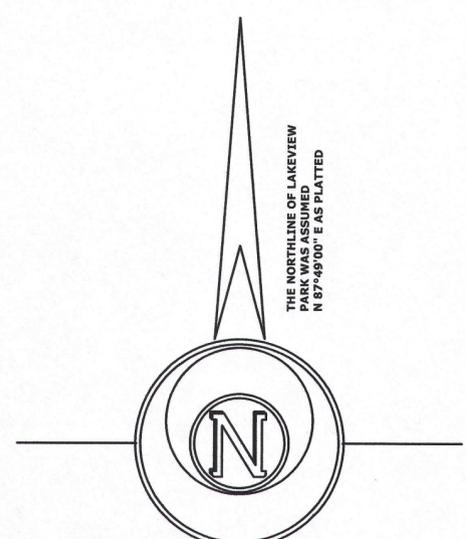


- LEGEND**
- FOUND IRON PIPE 1"
 - FOUND IRON ROD 3/4"
 - FOUND COUNTY MONUMENT
 - FOUND CONCRETE MONUMENT
 - UTILITY POLE
 - (x x) RECORDED AS DIMENSION
 - x - EXISTING FENCE

SCALE: 1 INCH = 20 FEET

"I hereby certify that the above described property has been surveyed by me or under my direction and that the above map is a true representation thereof and shows the size and location of the property, its exterior boundaries, the location of all visible structures and dimensions of all principal buildings thereon, boundary fences, apparent easements, roadways and visible encroachments, if any."
"This survey is made for the use of the present owners of the property, and also those who purchase, mortgage, or guarantee the title thereto within one year from date hereof."

Mark L. Miritz
MARK L. MIRITZ
WISCONSIN PROFESSIONAL
LAND SURVEYOR S-2582

DATE: MAY 11, 2016 JOB NO. 16.504

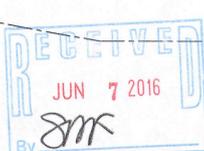

EAST 1/4 CORNER SECTION 16-1-17

ILVP-15A

117-3913