
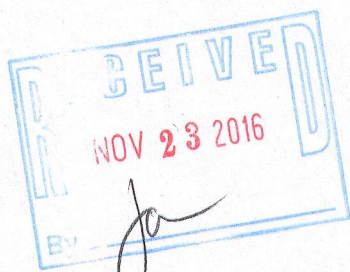


PLAT OF SURVEY



-OF-

THE SOUTH 15 FEET OF LOT 36, LOT 37 AND THE NORTH 1/2 OF LOT 38 IN BLOCK "J", SAID LOTS BEING IN CISCO BEACH, A SUBDIVISION IN SECTION 5, TOWNSHIP 1 NORTH, RANGE 17 EAST OF THE FOURTH PRINCIPAL MERIDIAN, ACCORDING TO THE PLAT RECORDED ON OCTOBER 9, 1926 IN VOLUME 8 OF PLATS ON PAGES 103 AND 104 IN THE OFFICE OF THE REGISTER OF DEEDS FOR WALWORTH COUNTY, WISCONSIN. SAID LAND BEING IN THE TOWN OF LINN, COUNTY OF WALWORTH AND STATE OF WISCONSIN.

SURVEY FOR: CHERYL HANSEN OF RE/MAX GENEVA REALTY
SURVEY ADDRESS: N2473 CISCO ROAD, LAKE GENEVA, WI 53147

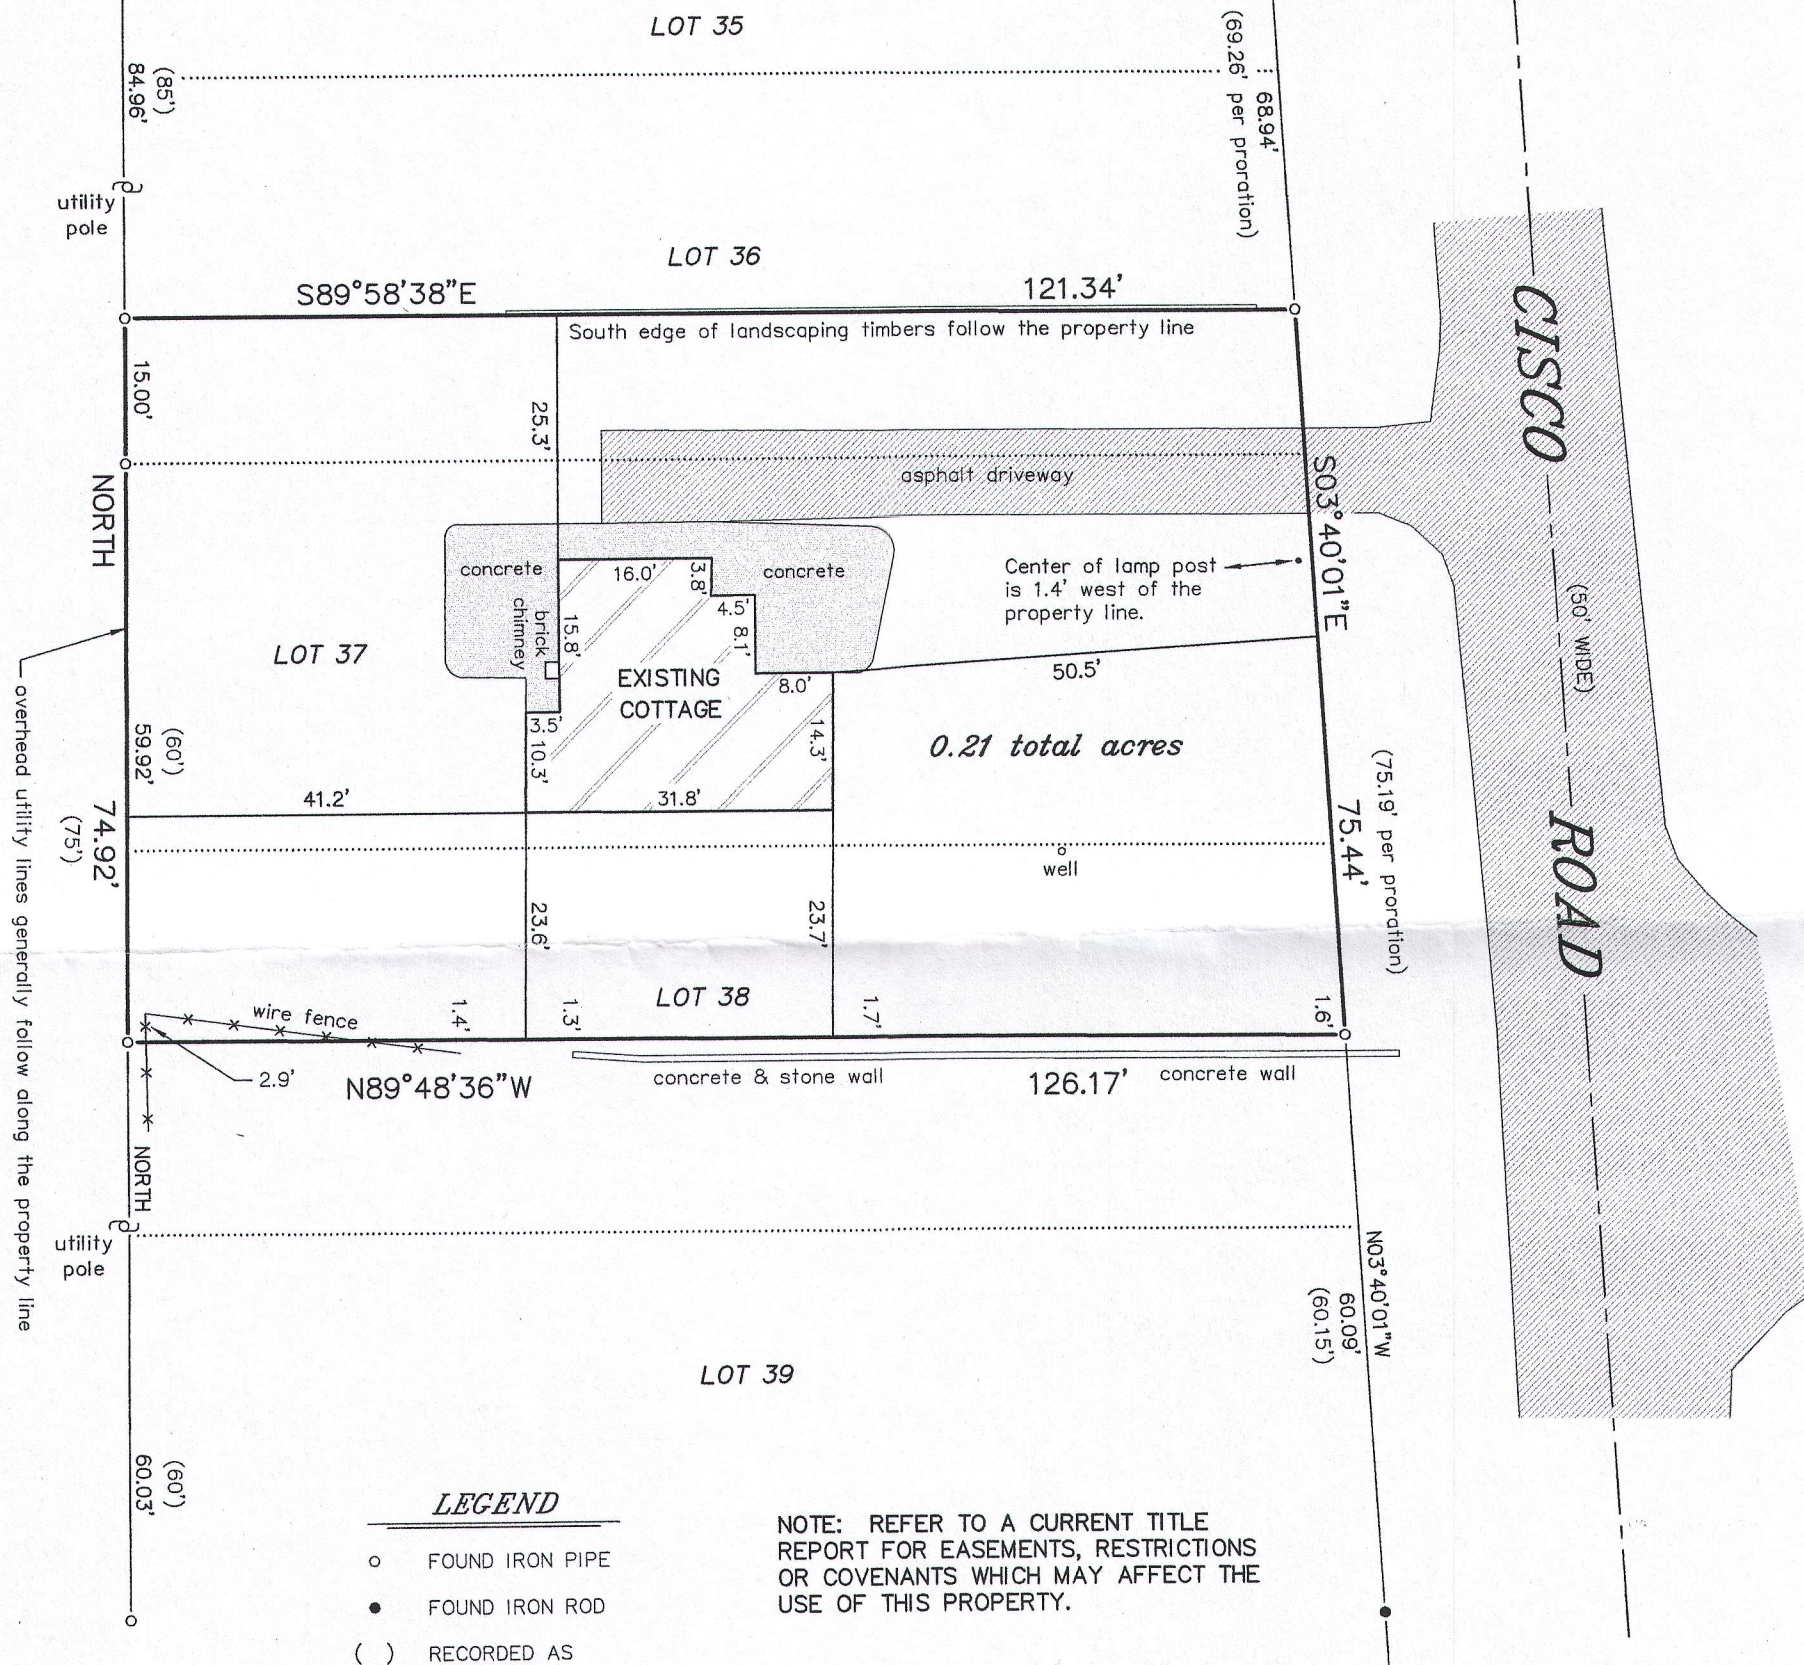

BEARINGS HEREON RELATE TO THE WEST LINE OF LOTS 34-39 IN BLOCK "J" OF CISCO BEACH SUBDIVISION. ASSUMED BEARING OF NORTH.

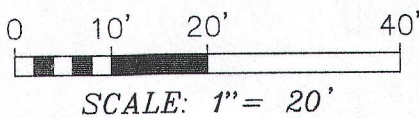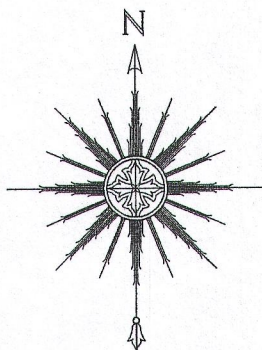

THIS IS NOT AN ORIGINAL PRINT
UNLESS THIS SEAL IS RED.

Thomas L. Satter

THOMAS L. SATTER

S-2850

"I HEREBY CERTIFY THAT I HAVE SURVEYED THE ABOVE DESCRIBED PROPERTY AND THAT THE ABOVE MAP IS A CORRECT REPRESENTATION THEREOF AND SHOWS THE SIZE AND LOCATION OF THE PROPERTY, ITS EXTERIOR BOUNDARIES, THE LOCATION OF ALL VISIBLE STRUCTURES AND DIMENSIONS OF ALL PRINCIPAL BUILDINGS THEREON, BOUNDARY FENCES, APPARENT EASEMENTS, ROADWAYS AND ENCROACHMENTS, IF ANY."

"THIS SURVEY IS MADE FOR THE USE OF THE PRESENT OWNERS OF THE PROPERTY, AND THOSE WHO PURCHASE, MORTGAGE, OR GUARANTEE THE TITLE THERETO WITHIN ONE YEAR FROM DATE HEREOF."

SATTER SURVEYING, LLC
LAND SURVEYS, MAPPING AND PLANNING
272 ORIGIN STREET
BURLINGTON, WI 53105
262-661-4239

NOVEMBER 10, 2016
DATE

111603
JOB NUMBER