



# PLAT OF SURVEY

LOT 11 OF BLOCK A CISCO BEACH  
PART OF THE SW 1/4 OF THE NE 1/4 SECTION 5  
TOWN 1 NORTH, RANGE 17 EAST  
WALWORTH COUNTY, WI.

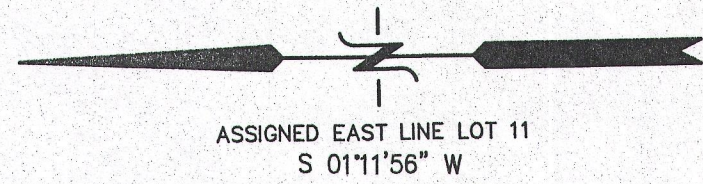

RES. TO EAST  
FLOOR EL. 875.3'

LOT 12

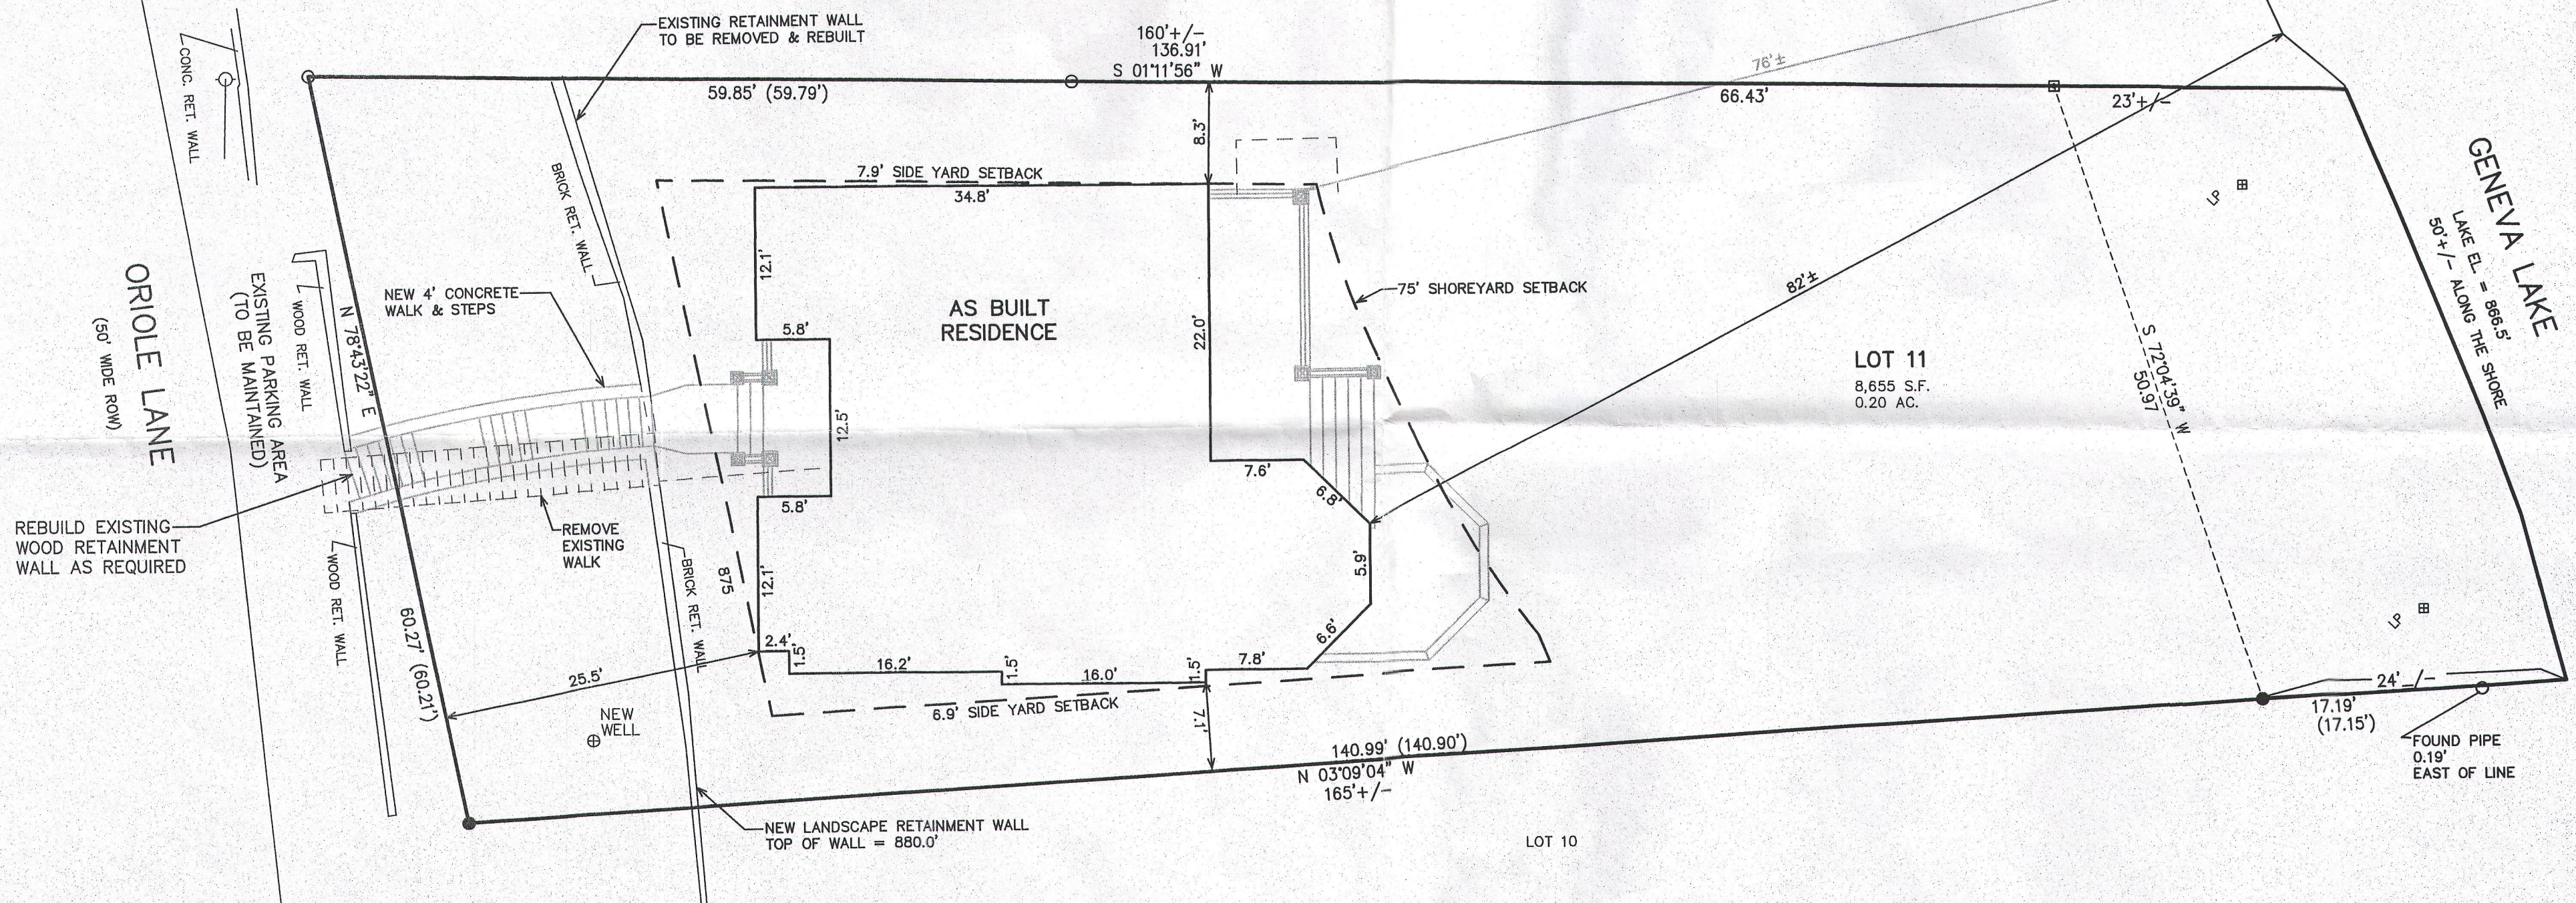

- LEGEND
- = FOUND IRON PIPE STAKE
  - = FOUND IRON REBAR STAKE
  - = FOUND CONCRETE MONUMENT
  - (XXX) = RECORDED AS

## SITE SUMMARY


|                                                   |                      |
|---------------------------------------------------|----------------------|
| TOTAL LAND AREA                                   | - 8,655 S.F.         |
| PROPOSED RESIDENCE AREA                           | - 1,489 S.F. (17.2%) |
| PROPOSED IMPERVIOUS AREA (PORCHES, PATIO & WALKS) | - 612 S.F. (7.1%)    |
| TOTAL IMPERVIOUS AREA                             | - 2,101 S.F. (24.3%) |
| PROPOSED GREEN SPACE                              | - 6,554 S.F. (75.7%) |

THIS SURVEY WAS MADE WITH SNOW AND ICE ON THE GROUND ON THE DATE OF THE FIELD WORK. SOME SURFACE IMPROVEMENTS (WALKS, PATIOS) MAY NOT HAVE BEEN VISIBLE AND ARE NOT SHOWN.

NOTE: COPIES OF THIS MAP TO WHICH THE FOLLOWING CERTIFICATE WILL APPLY SHOW THE SURVEYOR'S ORIGINAL SEAL AND SIGNATURE IN RED INK. COPIES BY ANY OTHER MEANS MAY HAVE ALTERATIONS WHICH DO NOT REPRESENT THE SURVEYOR'S WORK PRODUCT.


I HEREBY CERTIFY THAT THE ABOVE DESCRIBED PROPERTY HAS BEEN SURVEYED UNDER MY DIRECTION AND THAT THE ABOVE MAP IS A TRUE REPRESENTATION THEREOF AND SHOWS THE SIZE AND LOCATION OF THE PROPERTY AND ITS EXTERIOR BOUNDARIES. THIS SURVEY IS MADE FOR THE USE OF THE PRESENT OWNERS OF THE PROPERTY, AND ALSO THOSE WHO PURCHASE, MORTGAGE, OR GUARANTEE THE TITLE THERETO WITHIN ONE YEAR FROM THE DATE HEREOF.

DATED: JANUARY 15, 2016

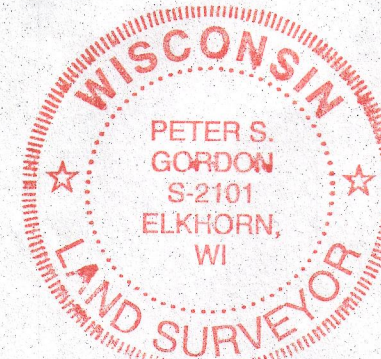

*Peter S. Gordon*  
PETER S. GORDON P.L.S. 2101

8/16/2016-KB  
SITE, GRADING, DRAINAGE &  
EROSION CONTROL PLAN  
8/30/2016-KB  
ADJUST SITE SUMMARY & 75' SETBACK  
REVISED 11-28-2016  
TO SHOW AS BUILT RESIDENCE  
SIZE & LOCATION

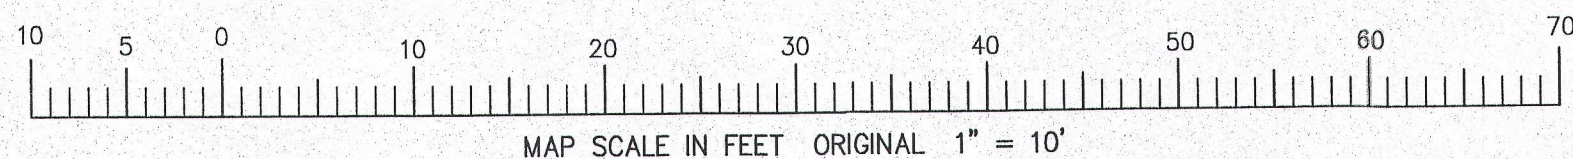

WORK ORDERED BY:  
LOWELL MANAGEMENT  
PO BOX 926  
LAKE GENEVA, WI. 53147

FARRIS, HANSEN & ASSOCIATES, INC.  
ENGINEERING - ARCHITECTURE - SURVEYING  
7 RIDGWAY COURT P.O. BOX 437  
ELKHORN, WISCONSIN 53121  
OFFICE: (262) 723-2098 FAX: (262) 723-5886

## REVISIONS

PROJECT NO.  
9447  
DATE:  
01-15-2016  
SHEET NO.  
1 OF 1

117 3973

ICI-10