




PREPARED FOR
LINDA TONGE
KEEFE REAL ESTATE
LAKE GENEVA WI

PLAT OF SURVEY

- OF -

PATHFINDER SURVEYING INC.
(formerly)
J.K. SURVEYING INC.
P.O BOX 322
LAKE GENEVA, WI. 53147
WWW.PATHFINDERSURVEYING.NET
262-248-8303

LOTS 13 AND 14, BLOCK "E", CISCO BEACH SUBDIVISION, BEING
A PART OF THE WEST 1/2 OF THE NE 1/4 OF SECTION 5, AND LOT
1 OF ROWENA SUBDIVISION A SUBDIVISION IN TOWN 1 NORTH,
RANGE 17 EAST, TOWN OF LINN, COUNTY OF WALWORTH AND
STATE OF WISCONSIN.

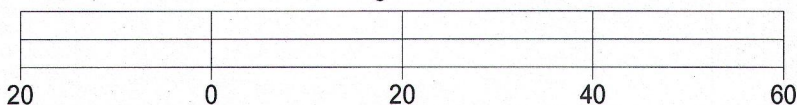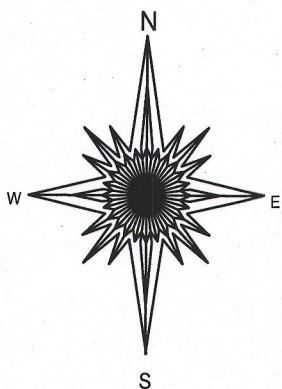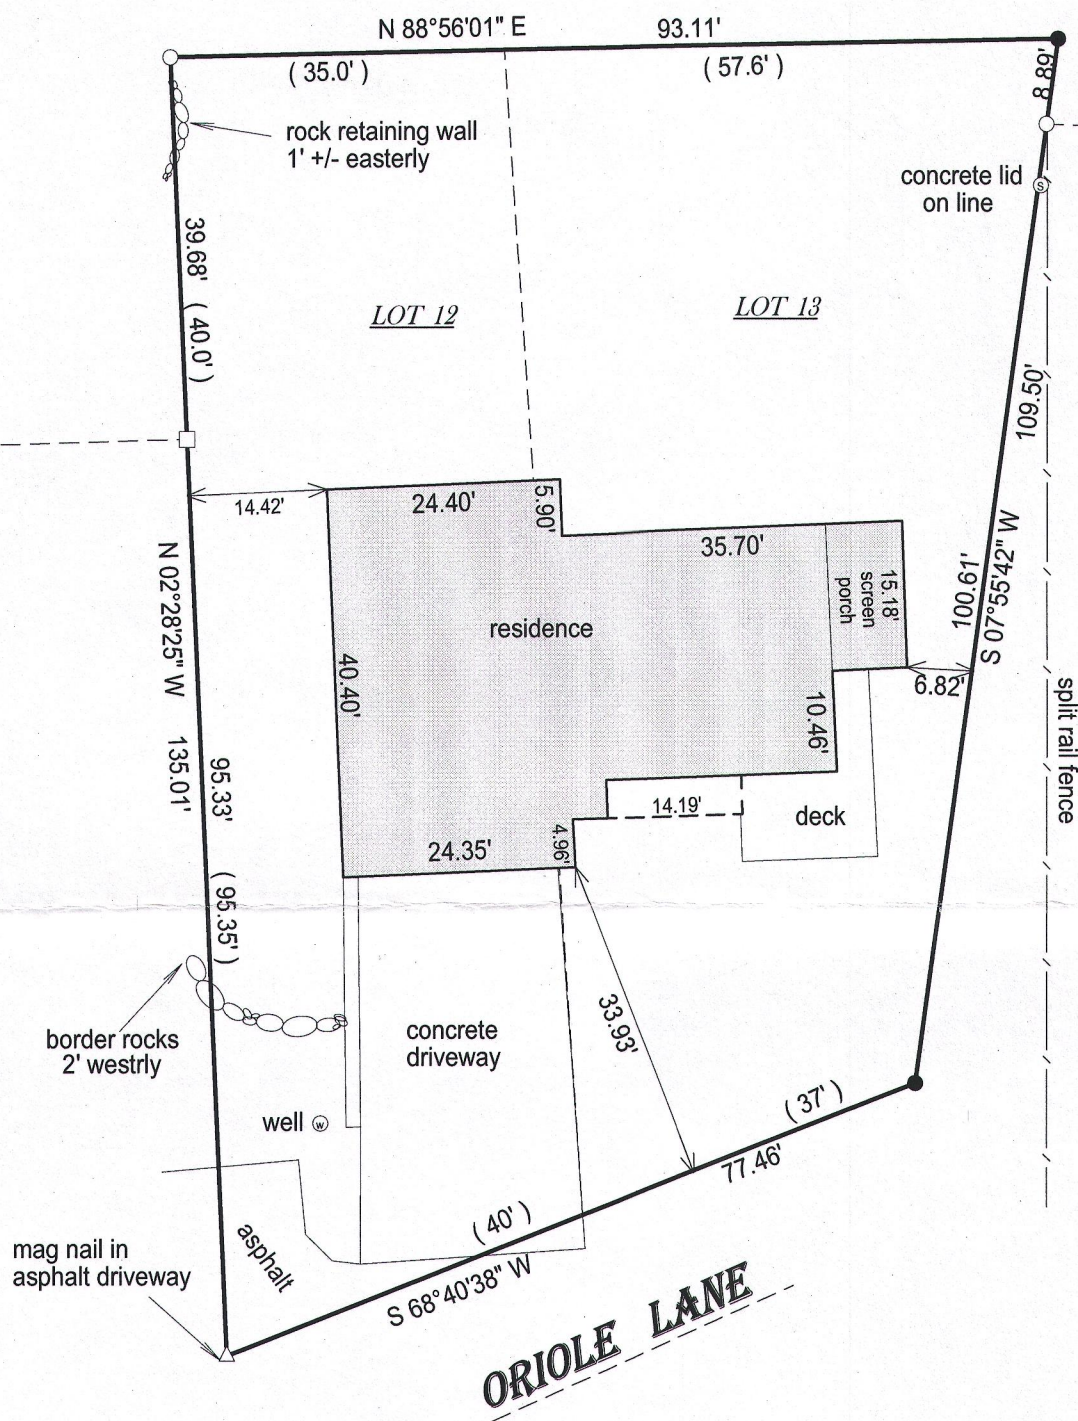

BASIS OF BEARING OF THIS PLAT: EXISTING SURVEYS OF RECORD.

I hereby certify that I have surveyed the above- described property and the
above map is a true representation thereof and shows the size and
location of the property, its exterior boundaries, the location and
dimensions of all structures thereon, fences, apparant easements and
roadways and visible encroachments if any.

This survey is made for the present owners of the property, and those who
purchase, mortgage, or guarantee the title thereto, within one year from
the date hereof.



DATED THIS 19TH DAY OF AUGUST, 2016.

- () = recorded as
- = found iron bar
- = found iron pipe
- = set iron pipe
- = set iron bar

SCALE 1" = 20'

JOB # 16-247

TAX ID # ICI 00104

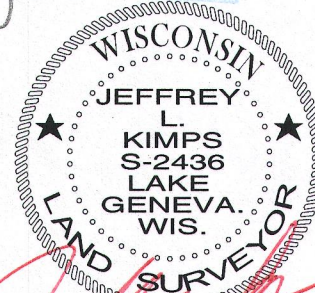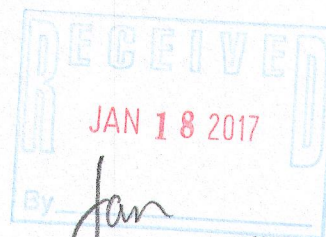

JEFFREY L. KIMPS S - 2436
Wisconsin Professional Land Surveyor
(original if signed in red)