


GEORGE T. DUNHAM
SURVEYING & SUBDIVIDING
DELAVER, WISCONSIN

N

Scale - 1" = 20'
● = Iron Pipe

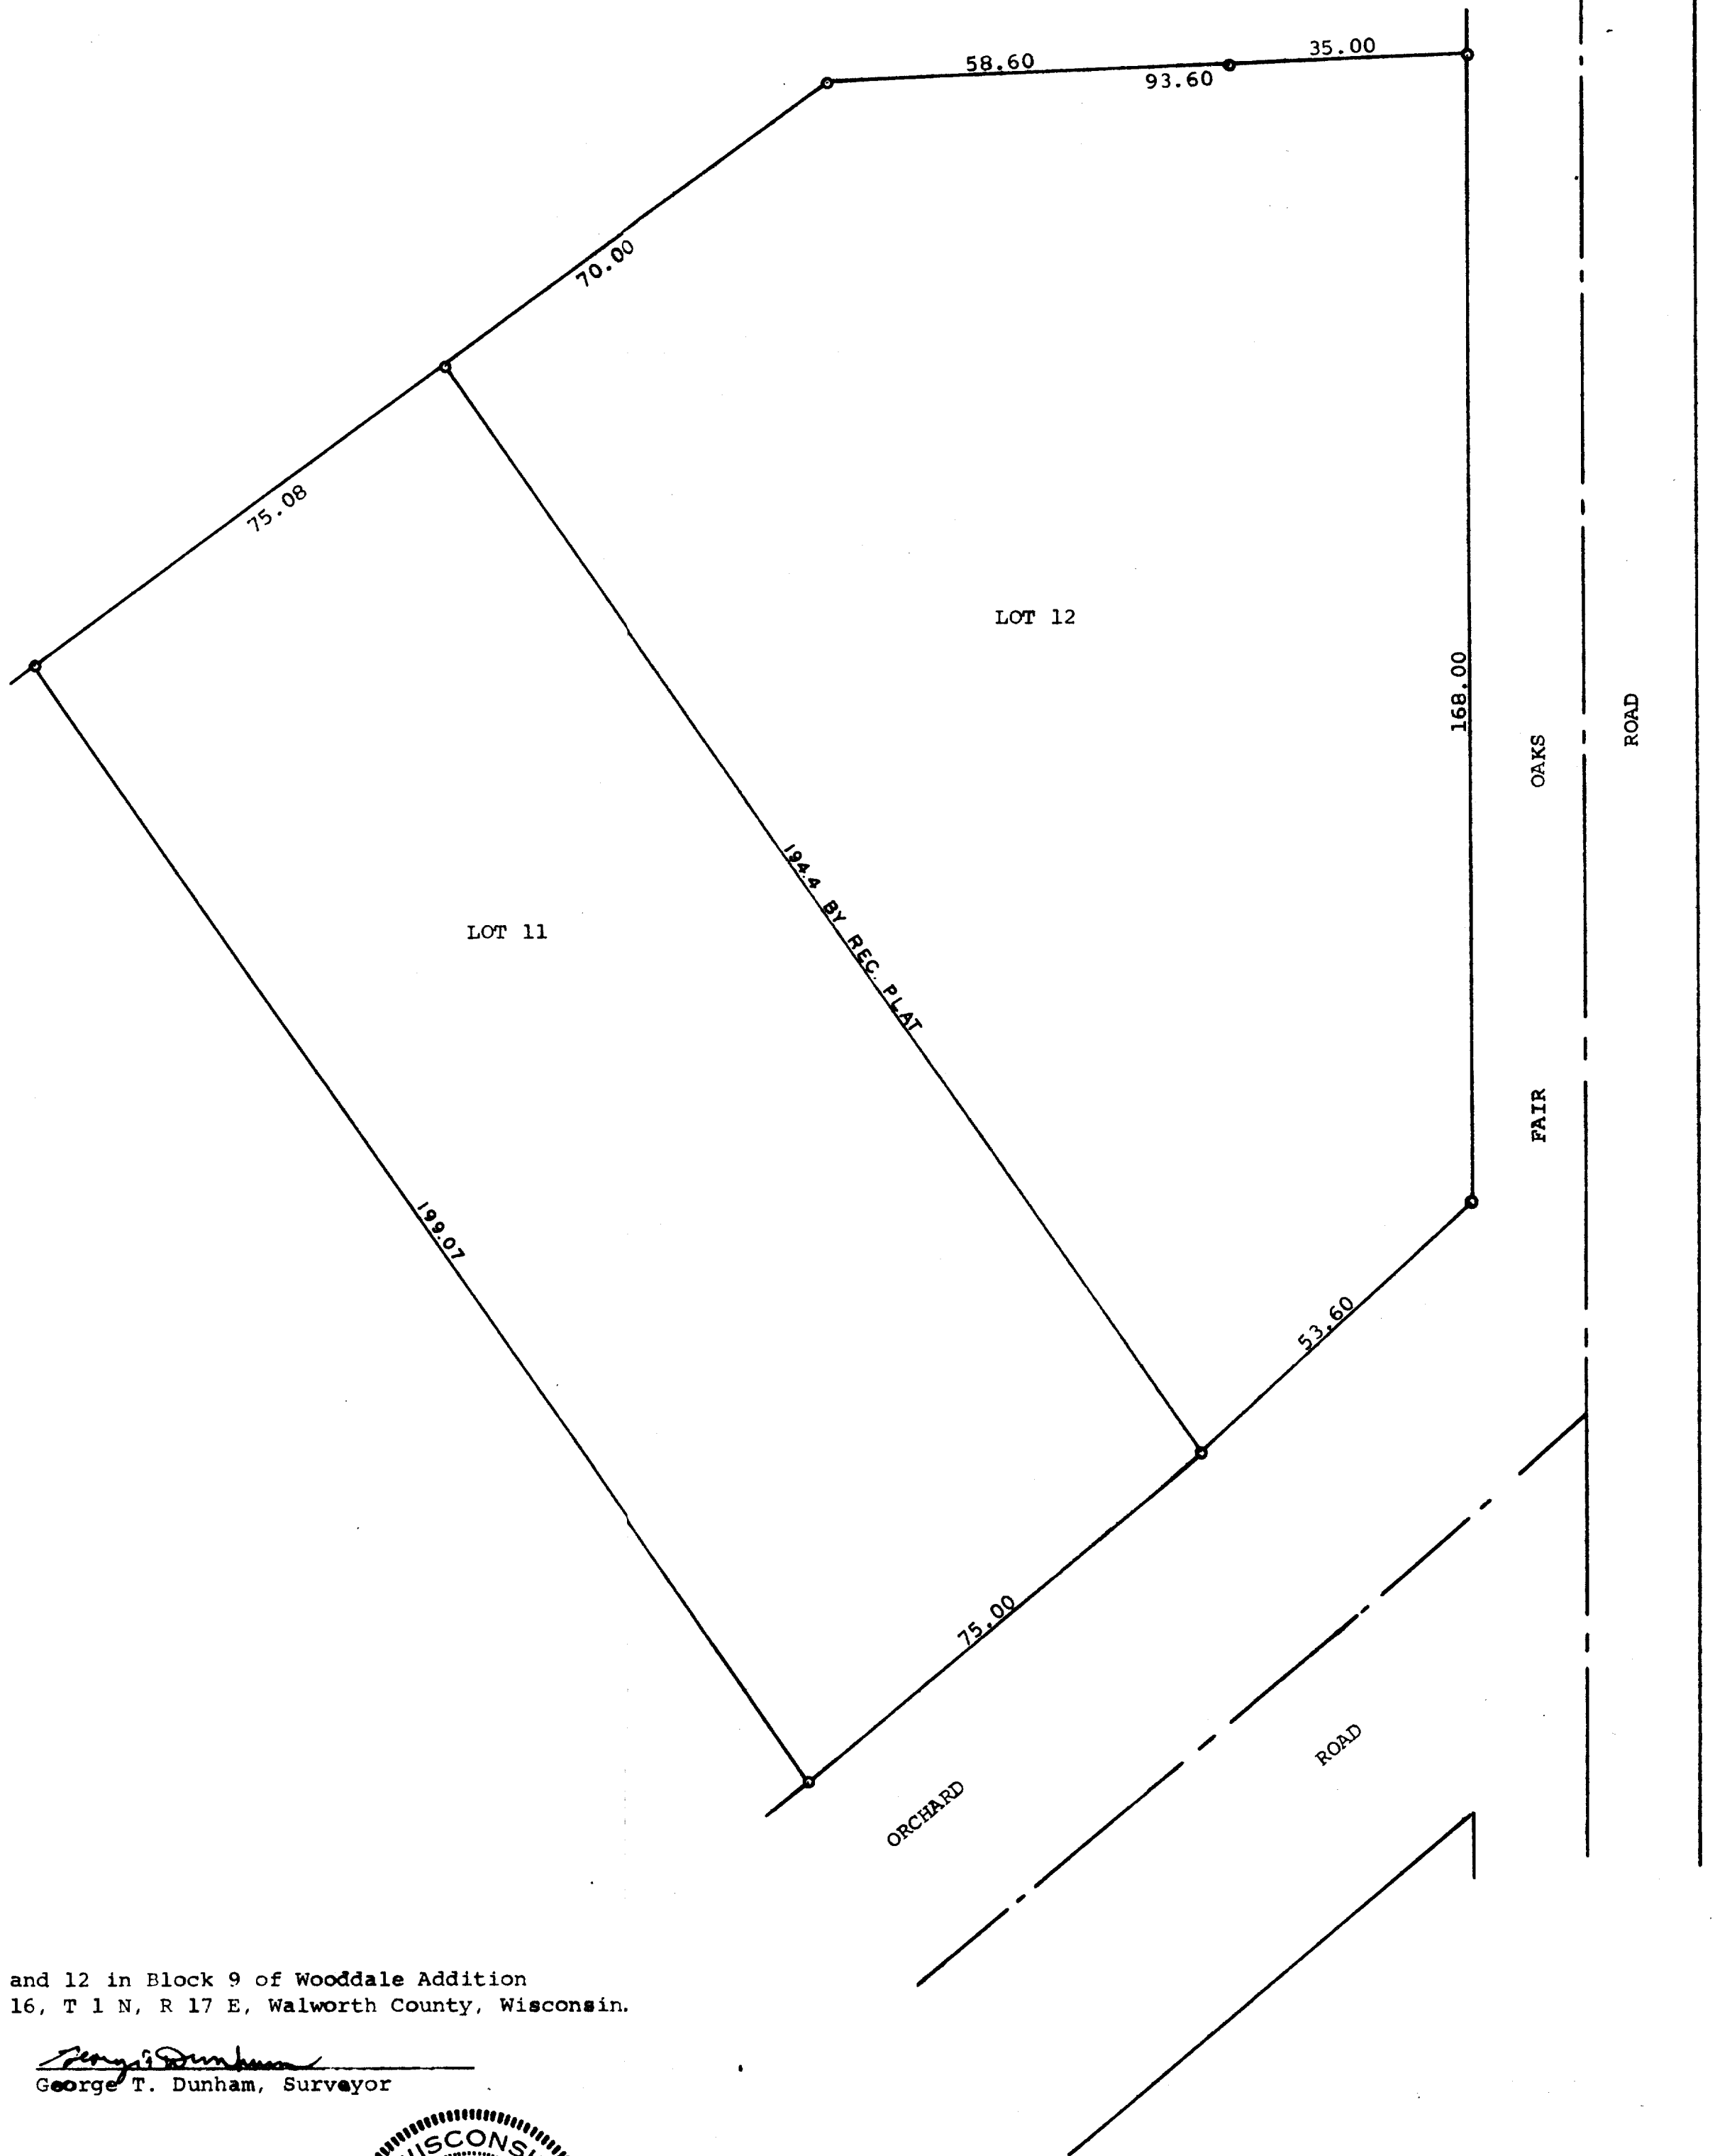

Plat of survey of Lots 11 and 12 in Block 9 of Wooddale Addition
located in Sections 9 and 16, T 1 N, R 17 E, Walworth County, Wisconsin.
August 14, 1973

George T. Dunham
George T. Dunham, Surveyor

