
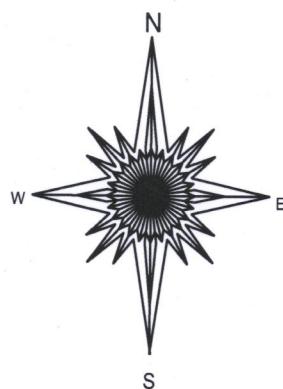


PLAT OF SURVEY

- OF -

PATHFINDER SURVEYING INC.
(formerly)
J.K. SURVEYING INC.
P.O BOX 322
LAKE GENEVA, WI. 53147
WWW.PATHFINDERSURVEYING.NET
262-248-8303

LOT 41 IN CAMP SYBIL (SAID CAMP SYBIL BEING A SUBDIVISION MADE BY ROSS D. SILL OF PIECE 5 OF LOT 2, THE SAME BEING A PART OF THE NE 1/4 OF SEC. 18, T.1.N., R.17.E., WALWORTH COUNTY WISCONSIN) ACCORDING TO THE PLAT OF SAID CAMP SYBIL OF RECORD IN THE OFFICE OF THE REGISTER OF DEEDS IN AND FOR SAID COUNTY OF WALWORTH.

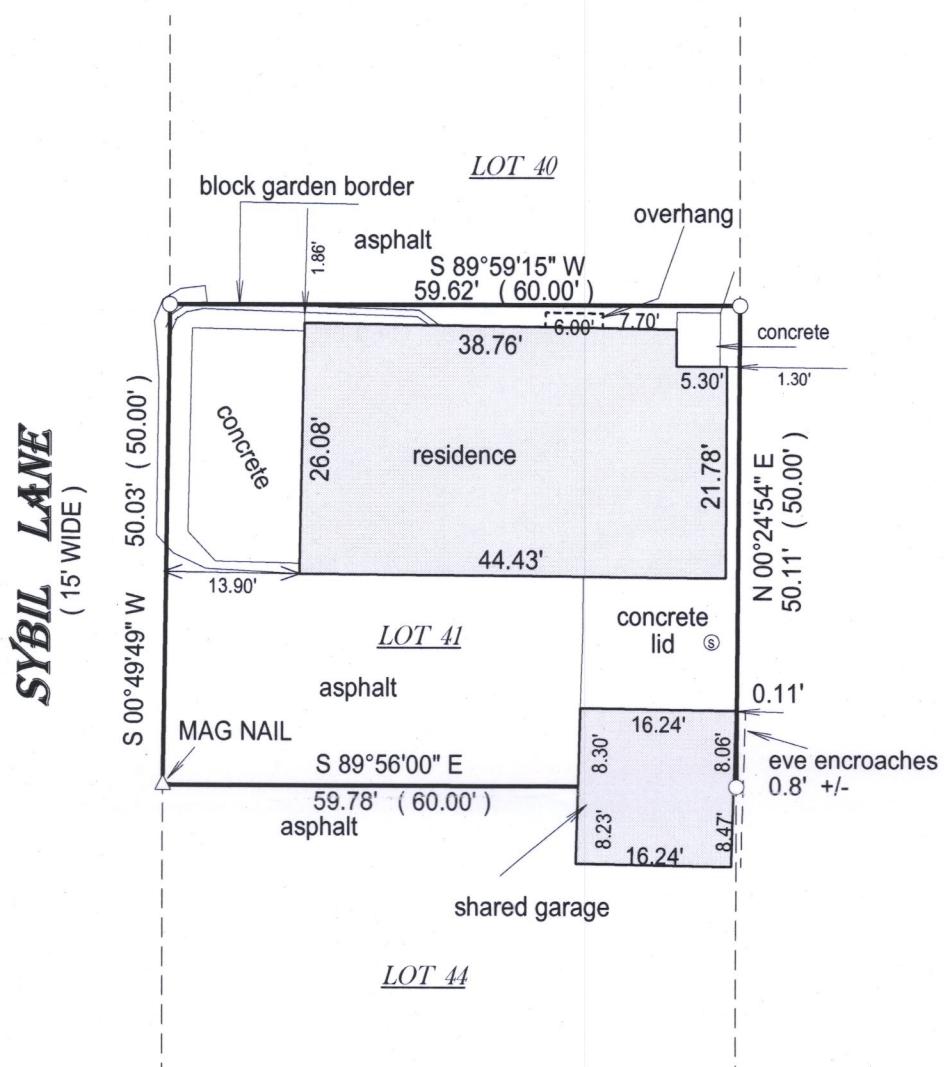

()= recorded as

= found iron bar

○ = found iron pipe

● = set iron pipe

JOB # 17-199

TAX ID # ICA 00040

BASIS OF BEARING OF THIS PLAT: THE SOUTH LINE OF LOT 41 WAS ASSUMED TO BEAR S89°56'00" E AS MONUMENTED.

I hereby certify that I have surveyed the above- described property and the above map is a true representation thereof and shows the size and location of the property, its exterior boundaries, the location and dimensions of all structures thereon, fences, apparent easements and roadways and visible encroachments if any.

This survey is made for the present owners of the property, and those who purchase, mortgage, or guarantee the title thereto, within one year from the date hereof.

DATED THIS 17TH DAY OF JULY 2017

A circular seal for a Wisconsin land surveyor. The outer ring contains the word "WISCONSIN" at the top and "LAND SURVEYOR" at the bottom, separated by a wavy line. The inner circle contains the name "JEFFREY" at the top, "L." in the center, and "KIMPS" below it. Below "KIMPS" are the numbers "S-2436", "LAKE", "GENEVA.", and "WIS.". The seal is framed by a decorative border of stars and dots. A large, red, scribbled "X" is drawn across the bottom of the seal.

117-4060