


7 RIDGWAY COURT— P.O. BOX 437
ELKHORN, WISCONSIN 53121
PHONE (262) 723-2098
FAX (262) 723-5886



LOT 15 OF LAKE GENEVA CLUB

LOCATED IN GOV.'T LOT 3, N 1/2 FRAC.T SECTION 18
TOWN 1 NORTH, RANGE 17 EAST, WALWORTH COUNTY, WI.

ORDERED BY: RYAN BUILDERS
N3298 CHERRY ROAD
LAKE GENEVA, WI. 53147

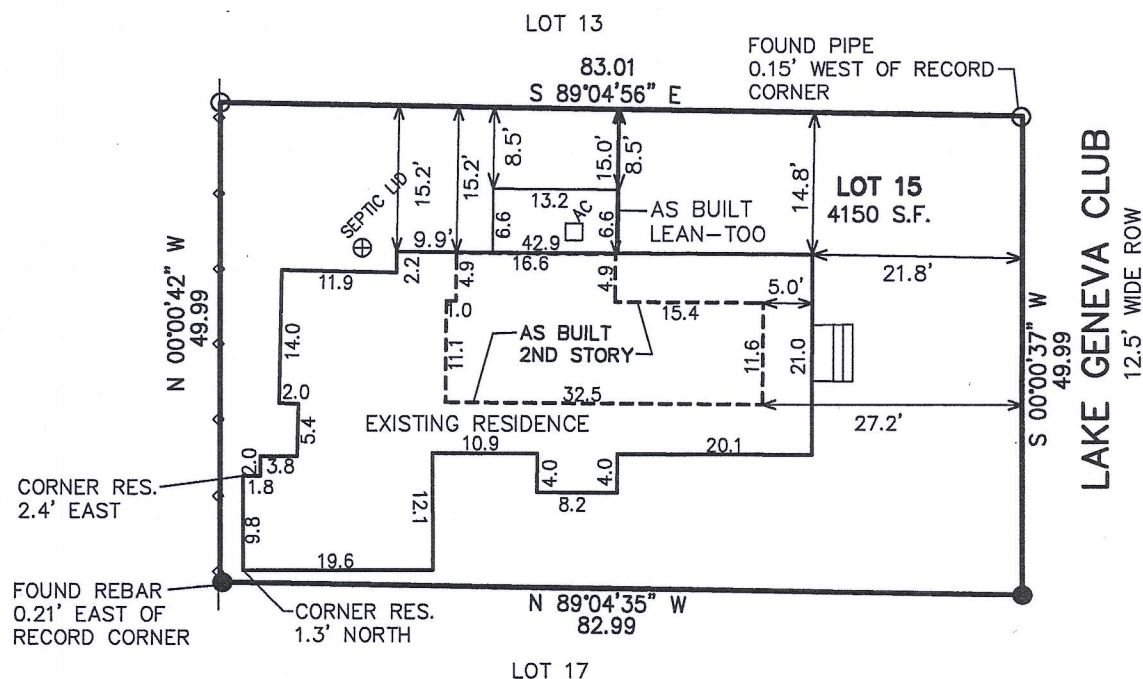

- = FOUND IRON PIPE STAKE
● = FOUND IRON REBAR STAKE
(XXX) = RECORDED AS

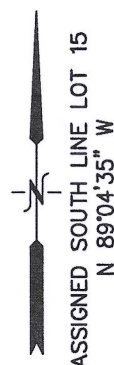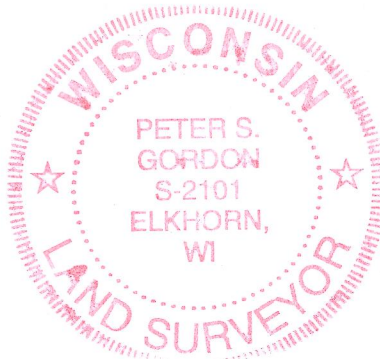

NOTE: COPIES OF THIS MAP TO WHICH THE FOLLOWING CERTIFICATE WILL APPLY SHOW SURVEYOR'S ORIGINAL SEAL AND SIGNATURE IN RED INK. COPIES BY ANY OTHER MEANS MAY HAVE ALTERATIONS WHICH DO NOT REPRESENT THE SURVEYOR'S WORK PRODUCT.

I HEREBY CERTIFY THAT THE ABOVE DESCRIBED PROPERTY HAS BEEN SURVEYED UNDER MY DIRECTION AND THAT THE ABOVE MAP IS A TRUE REPRESENTATION THEREOF AND SHOWS THE SIZE AND LOCATION OF THE PROPERTY AND ITS EXTERIOR BOUNDARIES. THIS SURVEY IS MADE FOR THE USE OF THE PRESENT OWNERS OF THE PROPERTY, AND ALSO THOSE WHO PURCHASE, MORTGAGE, OR GUARANTEE THE TITLE THERETO WITHIN ONE YEAR FROM THE DATE HEREOF.

REVISÉ 08-25-2017


TO SHOW AS BUILT LEAN-TOO & SECOND STORY ADD.

DATED: MARCH 9, 2017

Robert A. Graham

PETER S. GORDON P.L.S. 2101

PROJECT NO. 9705
DATED: 03-09-2017
SHEET 1 OF 1 SHEETS

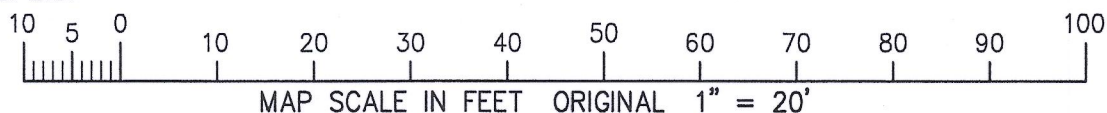

AUG 25 2017 ILG-13

117-4067