

X:\PROJECTS\9847\ACAD\9847.DWG (10/23/2017 - LB TOPO SURVEY)

BEARING BASIS N. LINE OF LOT 1
N 89°25'03" E


FARRIS, HANSEN & ASSOCIATES, INC.

ENGINEERING — ARCHITECTURE — SURVEYING
7 RIDGWAY COURT — P.O. BOX 437 — ELKHORN, WISCONSIN 53121
PHONE: (262) 723-2098 FAX: (262) 723-5886

BOUNDARY & TOPOGRAPHIC SURVEY

LOT 1 OF ROBINSON'S SUBDIVISION
LOCATED IN THE SW 1/4 OF THE SW 1/4
OF SECTION 11, TOWN 1 NORTH, RANGE 17 EAST,
TOWN OF LINN, WALWORTH COUNTY, WISCONSIN

— WORK ORDERED BY —
GENEVA HOMES INC.
P.O. BOX 7
LAKE GENEVA, WI 53147

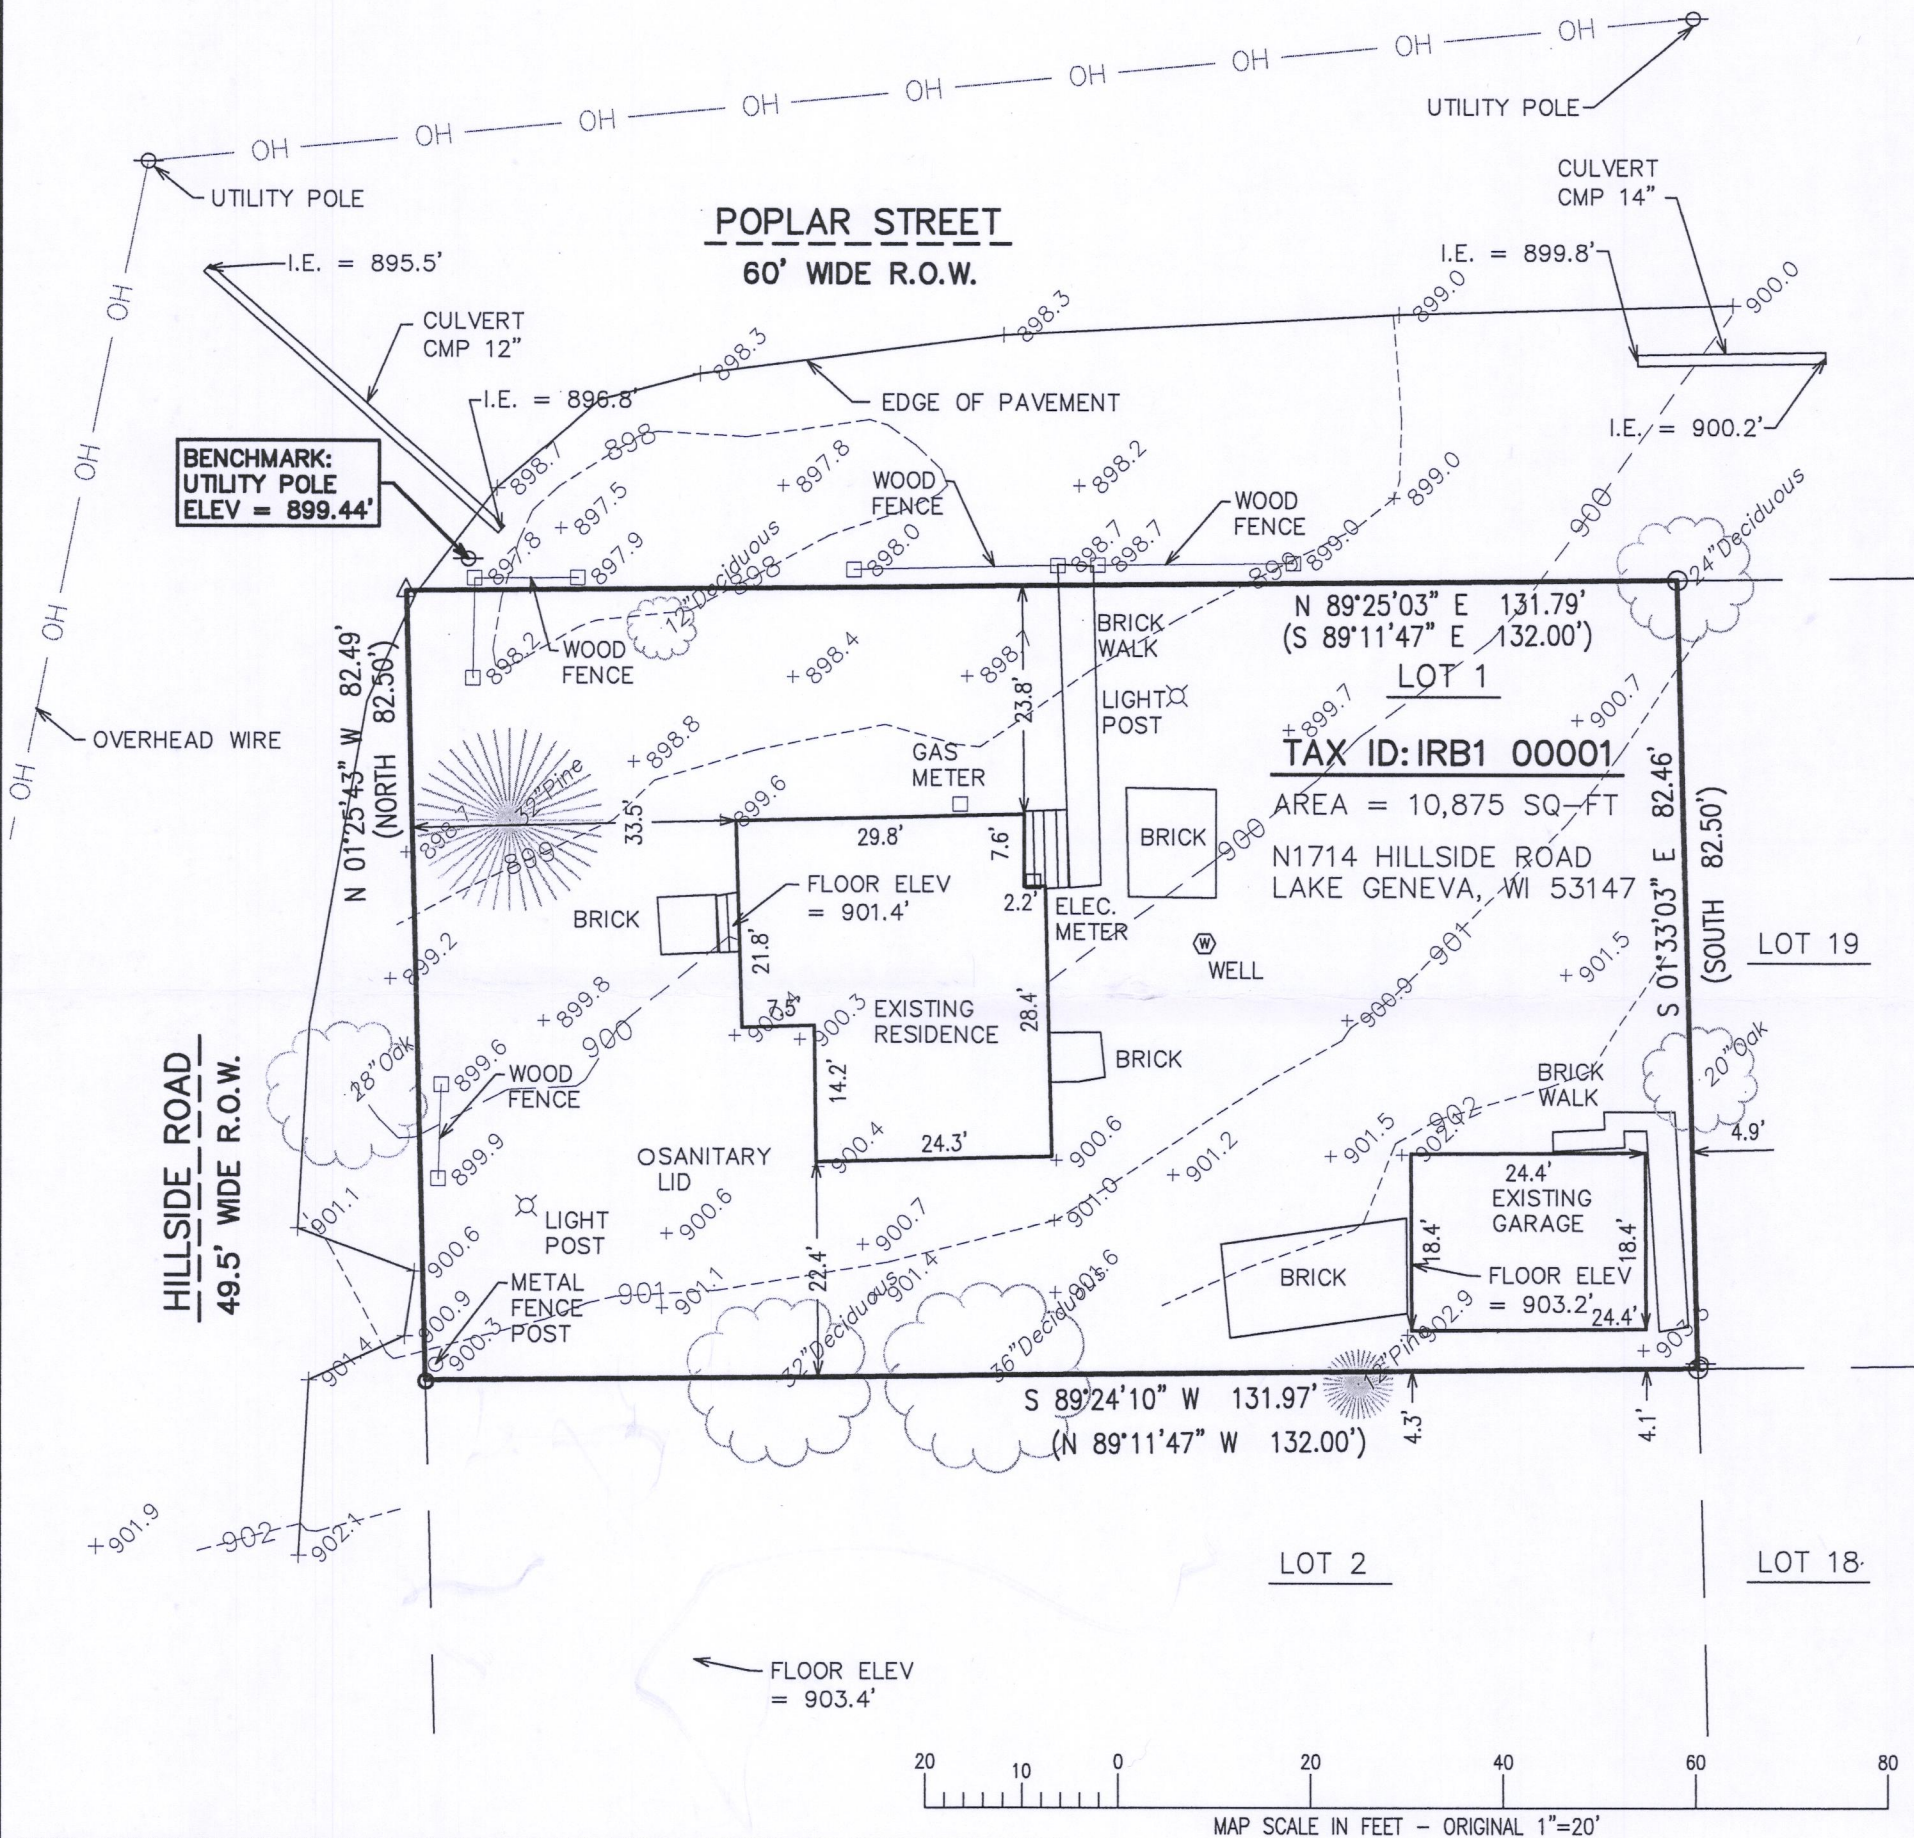


NOTE: COPIES OF THIS MAP TO WHICH THE FOLLOWING CERTIFICATE WILL APPLY SHOW THE SURVEYOR'S ORIGINAL SEAL AND SIGNATURE IN RED INK. COPIES BY ANY OTHER MEANS MAY HAVE ALTERATIONS WHICH DO NOT REPRESENT THE SURVEYOR'S WORK PRODUCT.

I HEREBY CERTIFY THAT THE ABOVE DESCRIBED PROPERTY HAS BEEN SURVEYED UNDER MY DIRECTION AND THAT THE ABOVE MAP IS A TRUE REPRESENTATION THEREOF AND SHOWS THE SIZE AND LOCATION OF THE PROPERTY AND ITS EXTERIOR BOUNDARIES. THIS SURVEY IS MADE FOR THE USE OF THE PRESENT OWNERS OF THE PROPERTY, AND ALSO THOSE WHO PURCHASE, MORTGAGE, OR GUARANTEE THE TITLE THERETO WITHIN ONE YEAR FROM THE DATE HEREOF.

DATED: 10/23/2017

Peter S. Gordon
PETER S. GORDON P.L.S. 2101

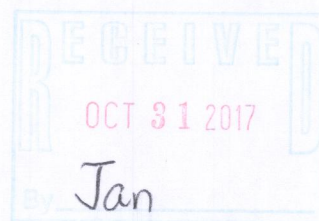

PROJECT: 9847
DATE: 10/23/2017
SHEET 1 OF 1

OCT 23 2017

IRB1-1

117-4076