


OF LOTS 4, 5, AND 6, BLOCK 14, MAPLE HILLS A SUBDIVISION,
BEING PART OF THE SW 1/4 OF THE SE 1/4 OF SECTION 18, T.
1 N., R. 17 E., OF THE 4TH P.M., WALWORTH COUNTY,
WISCONSIN.



- | | |
|----------|----------------------------|
| ● | 3/4" Iron Rebar Found |
| ■ | 1/2" Square Iron Pin Found |
| (XXX.XX) | Record Information |
| PW | Existing Well |
| ST | Existing Septic Tank |

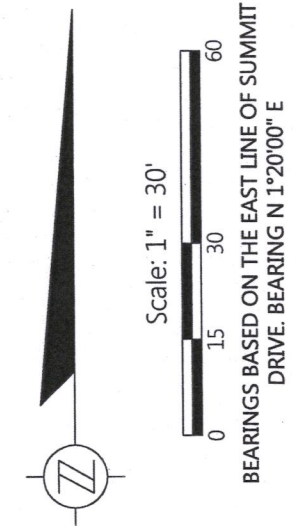

RECEIVED
DEC 14 2017
By Jan



*I hereby certify that I have supervised the survey of the property described above and to the best my knowledge and belief, the plat drawn hereon correctly represents said survey and its location. Given under my hand and seal this 20th day of September, 2017 at Beloit, Wisconsin.
Last day of field work September 18, 2017.*



Batterman
engineers surveyors planners
2857 Bartells Drive
Beloit, Wisconsin 53511
608.355.4464
www.rhbatterman.com

PLAT OF SURVEY

FOR THE EXCLUSIVE USE OF:
Shorewest Realtors
623 W. Main Street
Lake Geneva, WI. 53147

ORDER NO: 32807
BOOK: SEE FILE
FIELD CREW: DGM
DRAWN BY: DGM
DATE: September 19, 2017

File Name: J:\32800-32899\32807 - Shorewest Realtors\SURVEY\RHB DRAWING FILES

IMH-277 117-4087