

LAND-MARK SURVEYING

Mark L. Miritz

Wisconsin Professional Land Surveyor S-2582

N9330 Knuteson Drive
Whitewater, WI 53190
Phone: (262) 495-3284

MARKMIRITZ@
LAND-MARKSURVEYING.COM

ORDERED BY:

STACEY SCHULTZ

KEEFE REAL ESTATE


751 GENEVA PARKWAY

LAKE GENEVA, WI 53147


PLAT OF SURVEY

LOT 3 OF ELGIN CLUB SUBDIVISION,
LOCATED IN SECTION 4, TOWN 1
NORTH, RANGE 17 EAST, LINN TOWN-
SHIP, WALWORTH COUNTY, WISCONSIN

EXISTING
BLACKTOP
PRIVATE ROAD

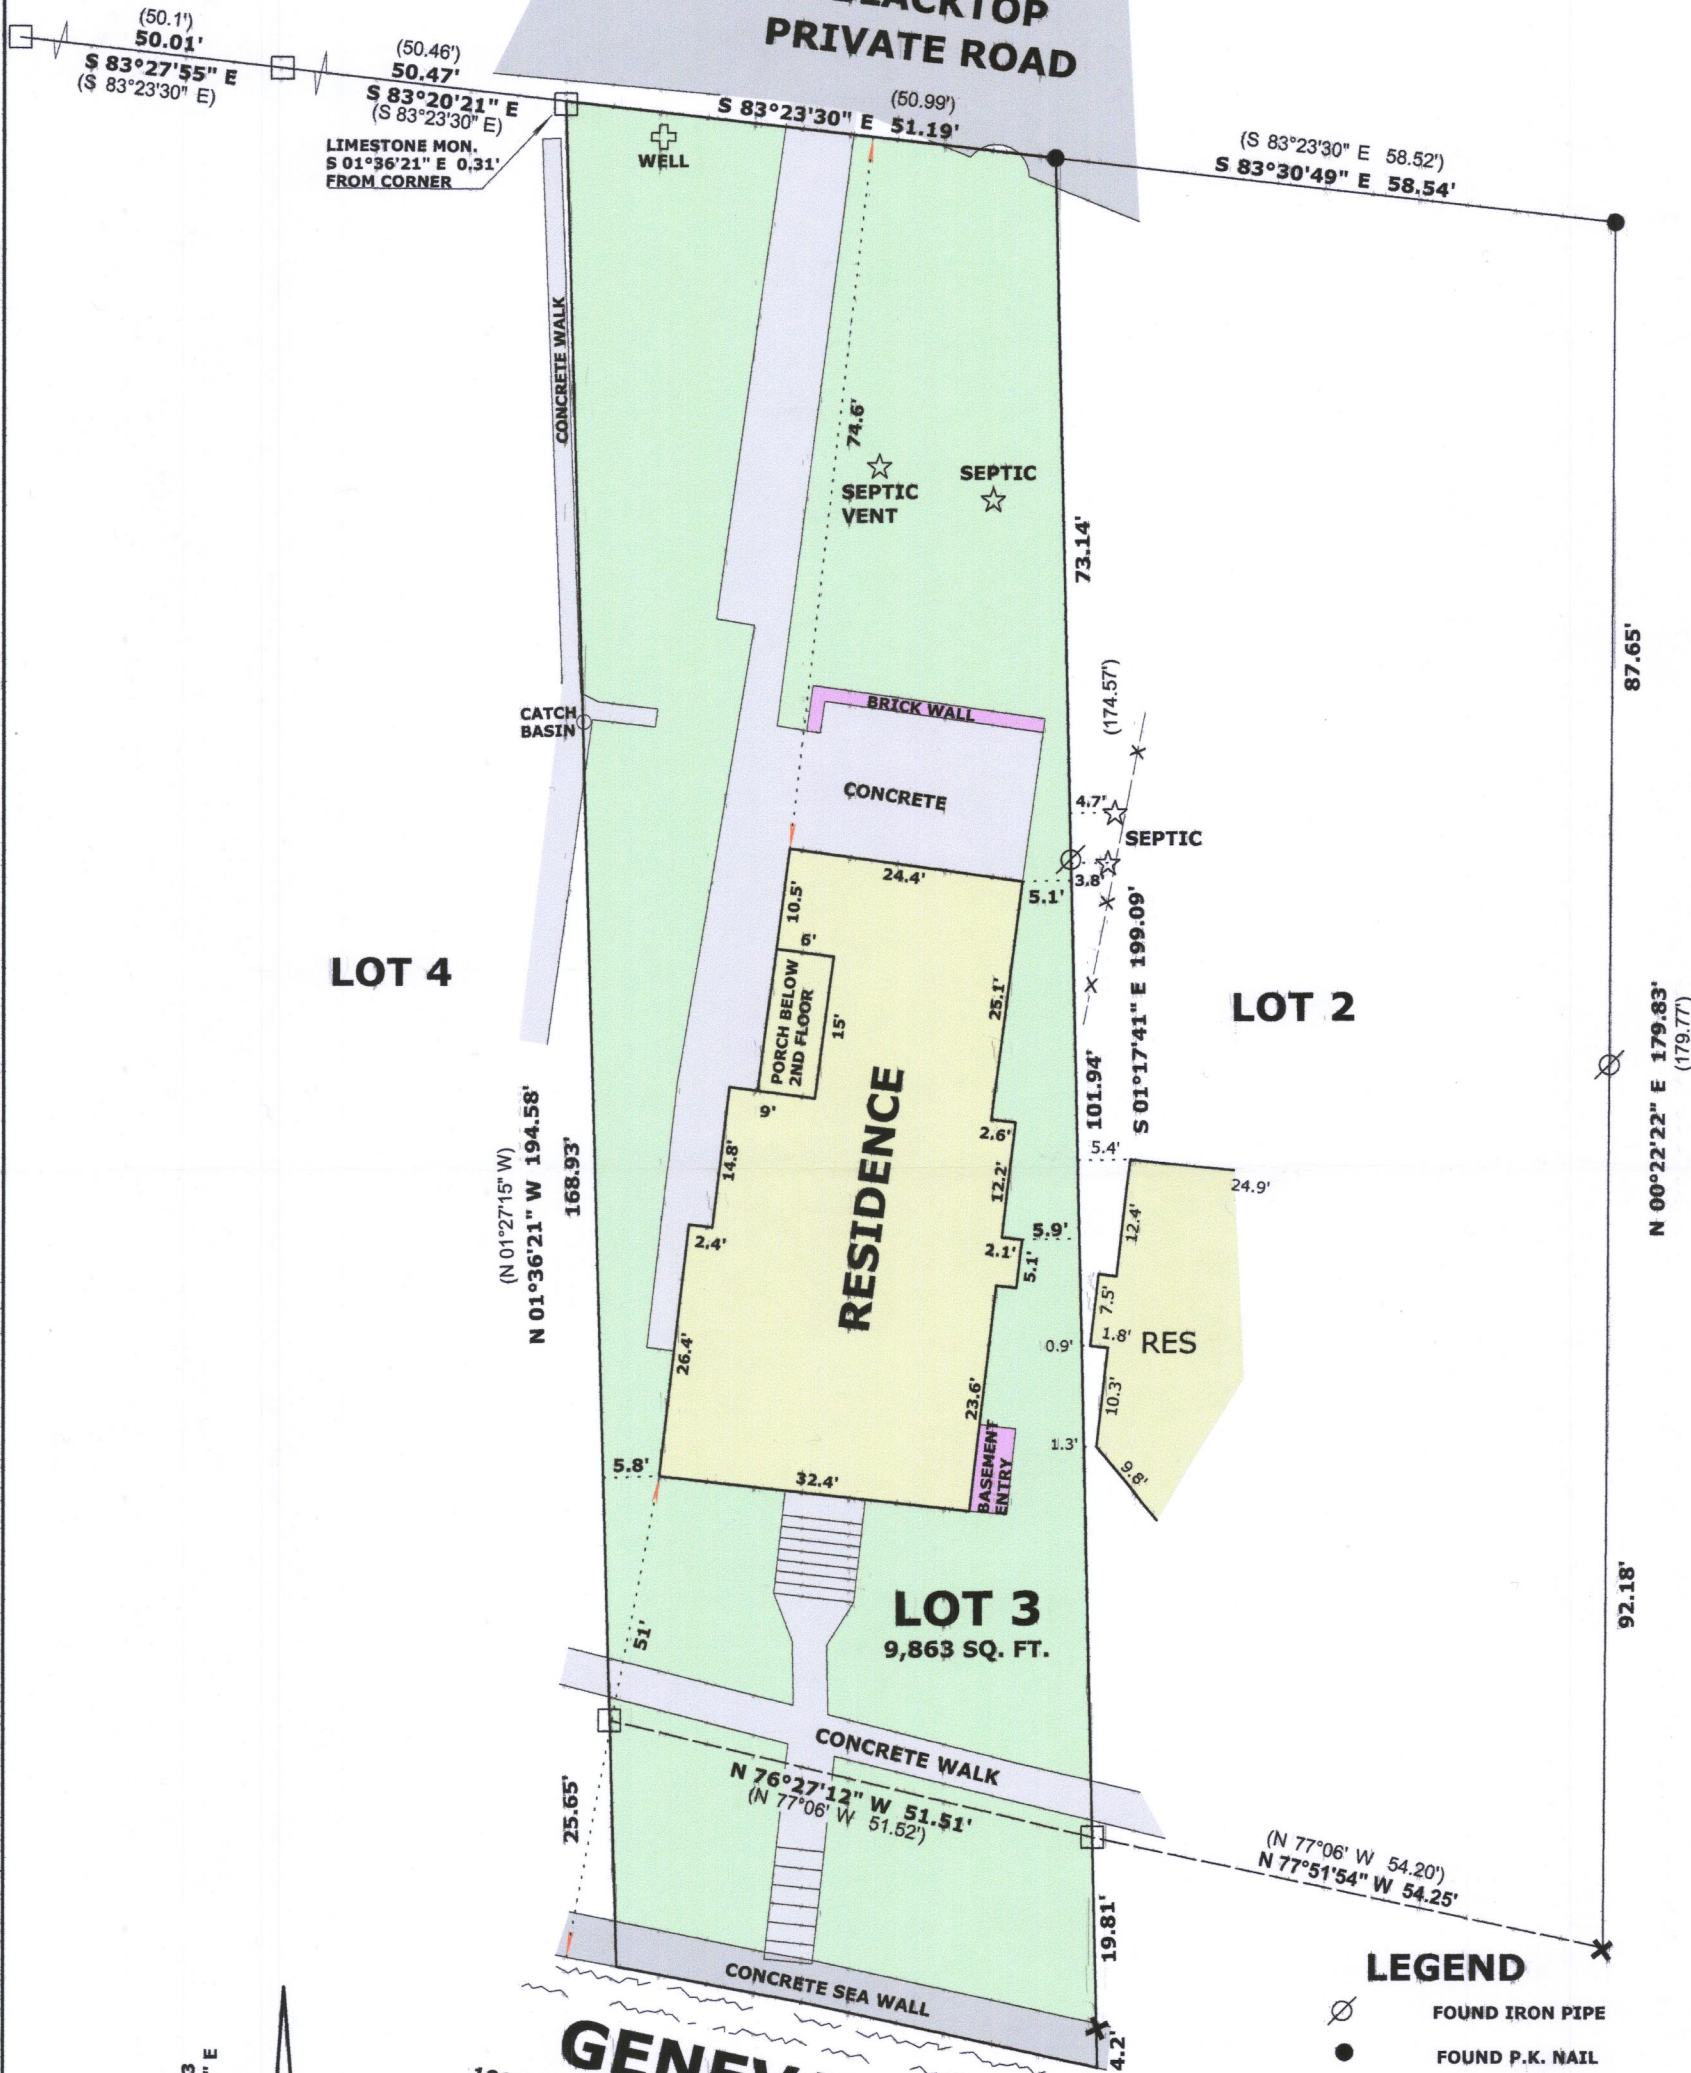

NORTH LINE OF LOT 3
ASSUMED S 83°23'30" E
AS PLATTED

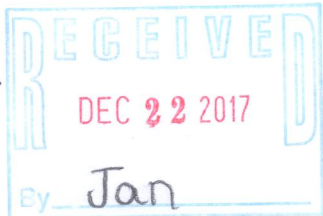

MARK L. MIRITZ
WISCONSIN PROFESSIONAL
LAND SURVEYOR S-2582

DATE: NOV. 9, 2017 JOB NO. 17.1101

IEC-3 117-4090