


AMBIT LAND SURVEYING
8120-312th Avenue
Wheatland, WI. 53105-8934
Licensed Professionals in
both Illinois & Wisconsin

PLAT OF SURVEY
OF

PHONE: 262-537-4874
FAX: 262-537-4221
EMAIL: ambit@tds.net

Lots 4 and 5, Block 3 of LAWRENCE'S ADDITION TO GENEVISTA, being a subdivision of part of the Southwest Quarter of the Southwest Quarter of Section 10, Township 1 North, Range 17 East of the 4th Principal Meridian, Township of Linn, Walworth County, Wisconsin.

PARCEL IDENTIFICATION NO.: IGVL 00008A

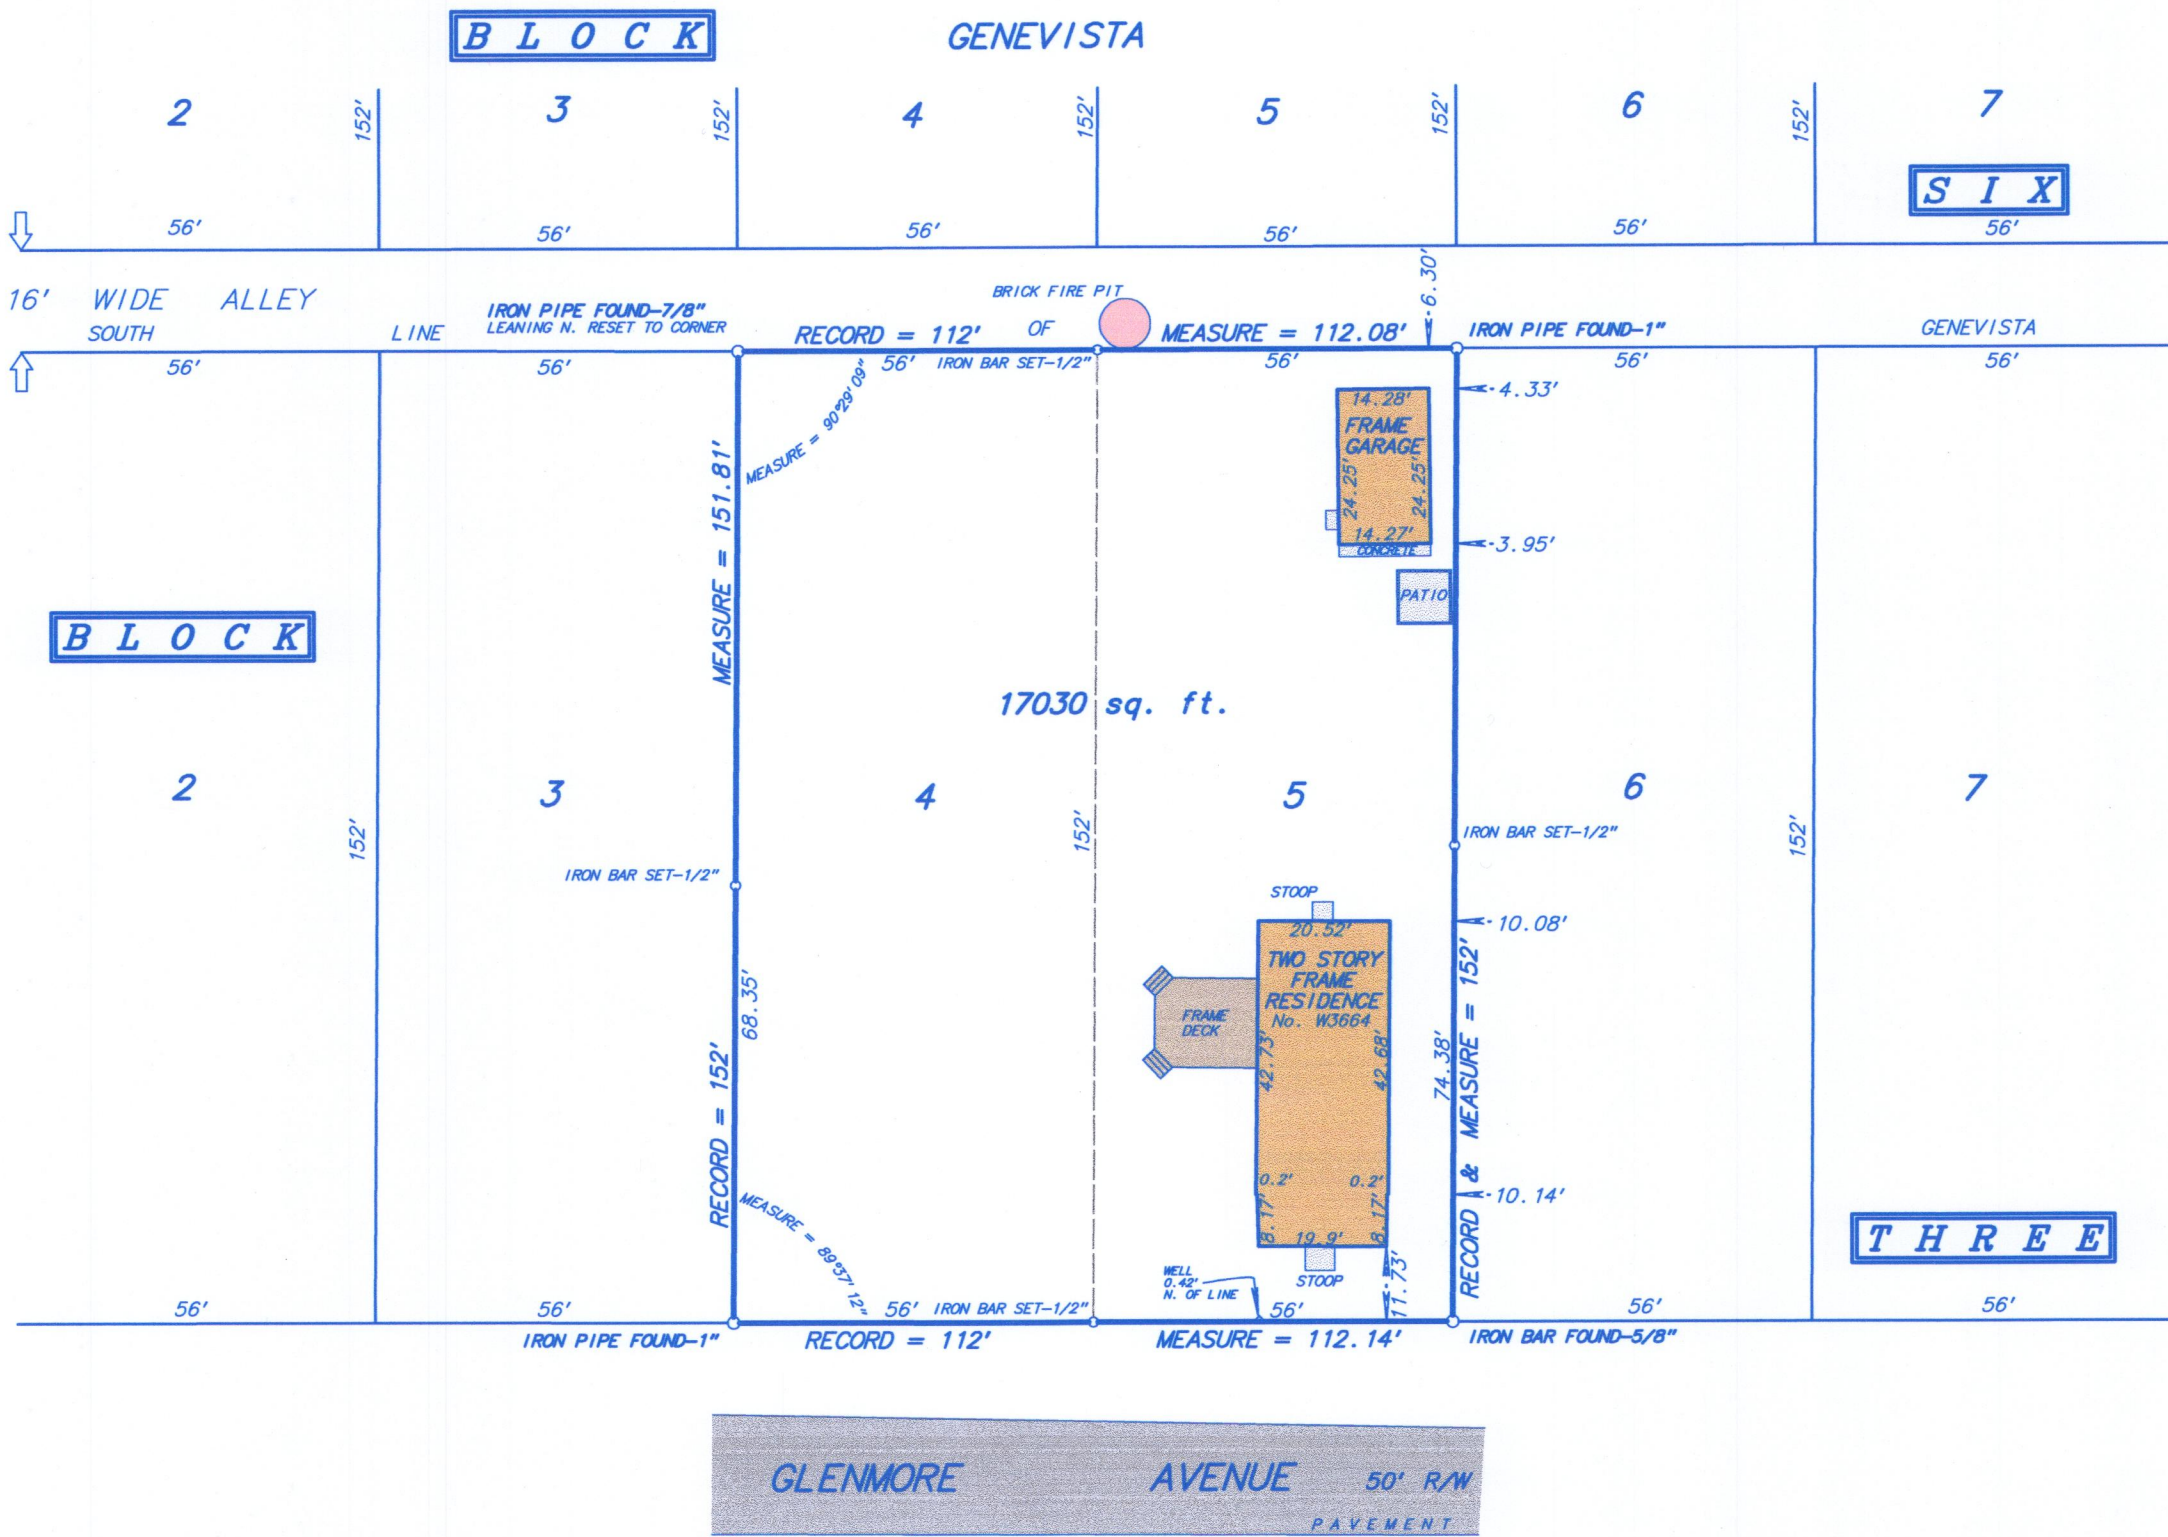

SCALE: 1 inch = 30 feet
ORDERED BY: T. Vanschrott
JOB NO.: 16078

RECEIVED
DEC 12 2017
By Jan

Fieldwork completed on and date of certification: May 24, 2016
I hereby certify that I have surveyed the above described property and the above plat is a true representation thereof and shows the size and location of the property, its exterior boundaries, the location and dimensions of all visible structures thereon, boundary fences, apparent easements and roadways and visible encroachments, if any.
This survey is made for the exclusive use of the present owners of the property, and also those who purchase, mortgage or guarantee the title thereto within ONE YEAR from the date hereof.
Dated at Wheatland, Wisconsin this _____ day of _____ 2016.

Mark A. Bolender
Wisconsin Professional Land Surveyor 1784

IGVL-8A 117-4095