


PLAT OF SURVEY -OF-

LOT 1 OF CERTIFIED SURVEY MAP NO. 2982, RECORDED MAY 8, 1998 IN VOLUME 16 OF CERTIFIED SURVEYS ON PAGE 14, AS DOCUMENT NO. 381376 AND BEING A REDIVISION OF LOT 1, CERTIFIED SURVEY MAP NO. 2488 AND LOCATED IN PART OF THE SOUTHEAST 1/4 OF THE NORTHEAST 1/4 OF SECTION 4, TOWNSHIP 1 NORTH, RANGE 17 EAST OF THE FOURTH PRINCIPAL MERIDIAN, IN THE TOWN OF LINN, WALWORTH COUNTY, WISCONSIN.

SURVEY FOR: AT PROPERTIES


SURVEY LOCATION: N2347 ALTA VISTA DRIVE

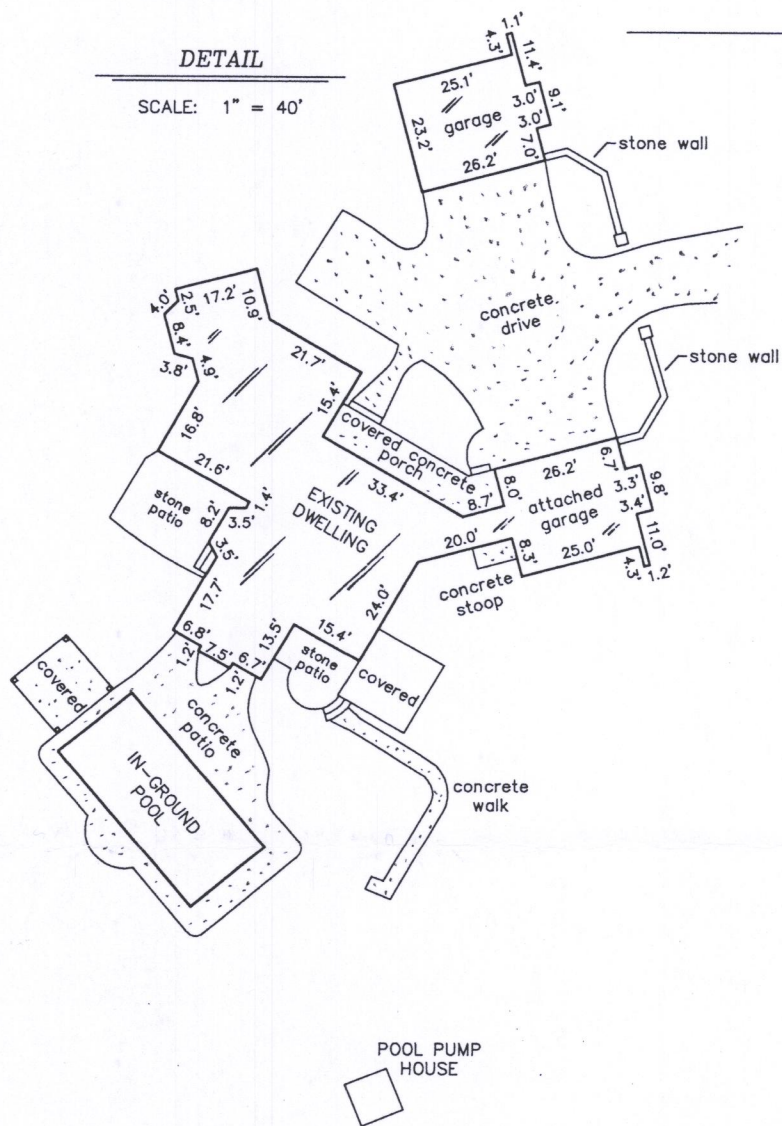

LEGEND


- FOUND IRON PIPE
- FOUND IRON ROD

GRAPHIC SCALE

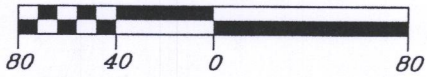


"I hereby certify that I have surveyed the above described property and that the above map is a correct representation thereof and shows the size and location of the property, its exterior boundaries, the location of all visible structures and dimensions of all principal buildings thereon, boundary fences, apparent easements, roadways and encroachments, if any."

"This survey is made for the use of the present owners of the property, and those who purchase, mortgage, or guarantee the title thereto within one year from date hereof."

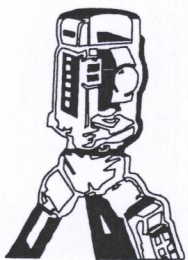



B.W. SURVEYING, INC.

LAND SURVEYS
MAPPING AND PLANNING
412 N. PINE STREET
BURLINGTON, WI 53105
(262)-767-0225

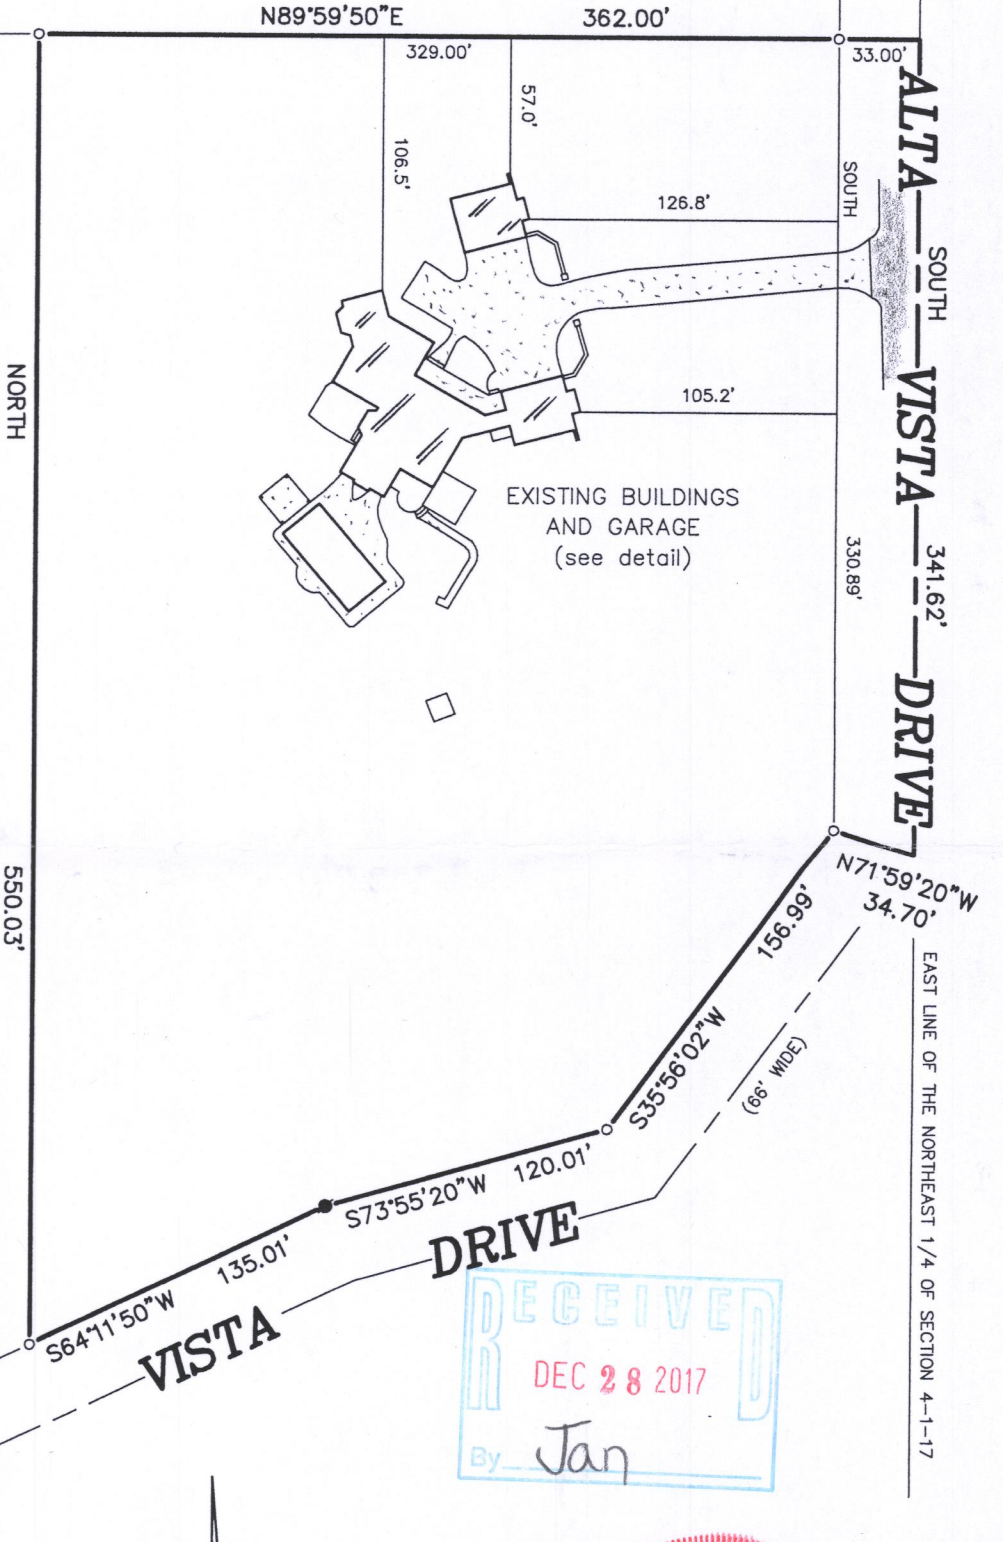

SCALE:

1" = 80'

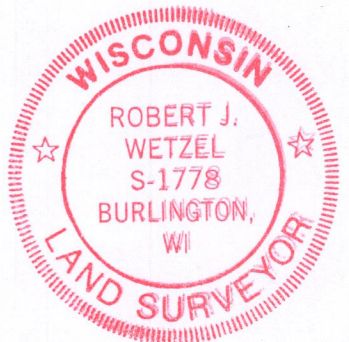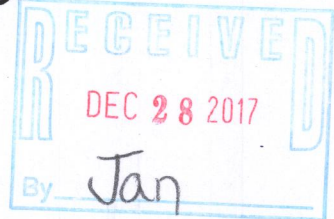

THIS IS NOT AN ORIGINAL PRINT
UNLESS THIS SEAL IS RED.

Robert J. Wetzel
ROBERT J. WETZEL S-1778

JUNE 30, 2017
DATE

9382
JOB NUMBER

IA 2982-1

117-4097