



PLAT OF SURVEY & TOPOGRAPHIC MAPPING LOTS 2 THROUGH 5 OF BLOCK 7 OF WOODDALE ADDITION

LOCATED IN THE SE 1/4 OF THE SW 1/4
OF SECTION 9, TOWN 1 NORTH, RANGE 17 EAST,
TOWN OF LINN, WALWORTH COUNTY, WISCONSIN

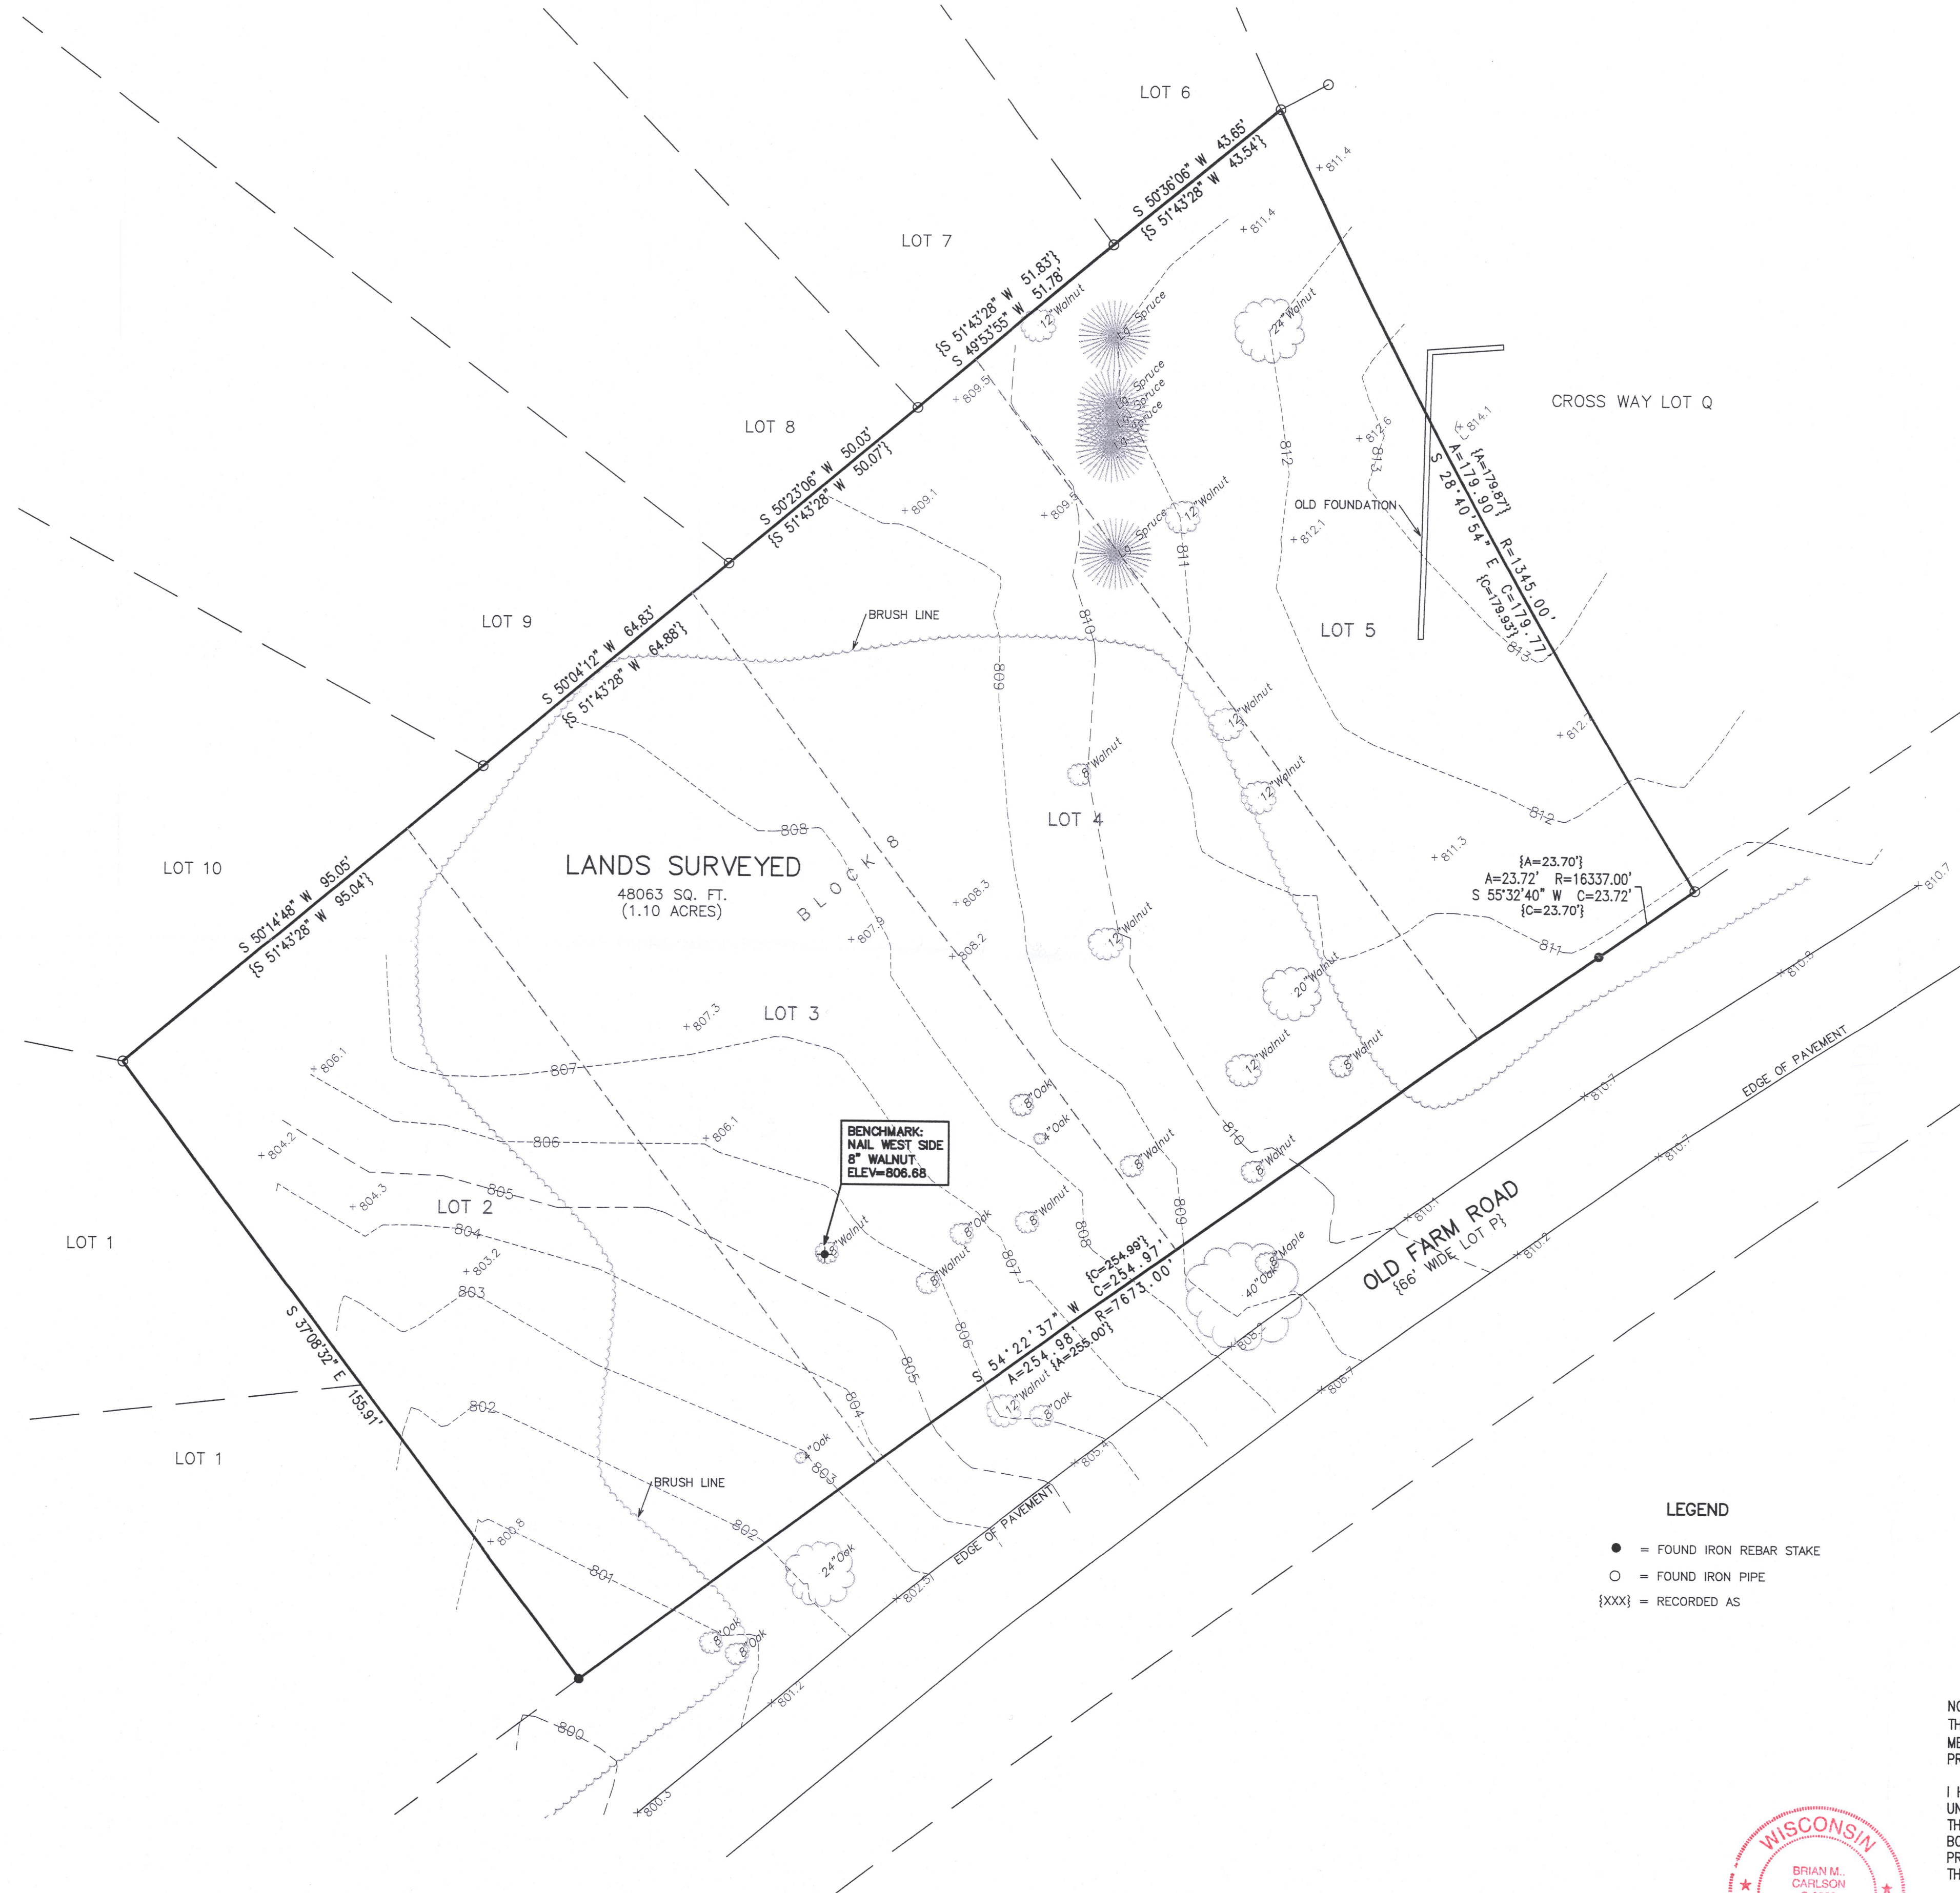

- LEGEND
- = FOUND IRON REBAR STAKE
 - = FOUND IRON PIPE
 - {XXX} = RECORDED AS

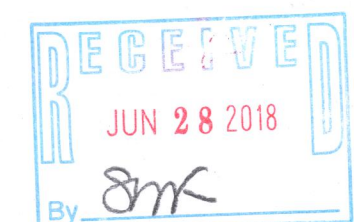


NOTE: COPIES OF THIS MAP TO WHICH THE FOLLOWING CERTIFICATE WILL APPLY SHOW THE SURVEYOR'S ORIGINAL SEAL AND SIGNATURE IN RED INK. COPIES BY ANY OTHER MEANS MAY HAVE ALTERATIONS WHICH DO NOT REPRESENT THE SURVEYOR'S WORK PRODUCT.

I HEREBY CERTIFY THAT THE ABOVE DESCRIBED PROPERTY HAS BEEN SURVEYED UNDER MY DIRECTION AND THAT THE ABOVE MAP IS A TRUE REPRESENTATION THEREOF AND SHOWS THE SIZE AND LOCATION OF THE PROPERTY AND ITS EXTERIOR BOUNDARIES. THIS SURVEY IS MADE FOR THE USE OF THE PRESENT OWNERS OF THE PROPERTY, AND ALSO THOSE WHO PURCHASE, MORTGAGE, OR GUARANTEE THE TITLE THERETO WITHIN ONE YEAR FROM THE DATE HEREOF.



DATED: 06/22/2018

BMC
BRIAN M. CARLSON P.L.S. 2039

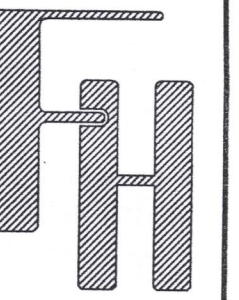

PLAT OF SURVEY & TOPOGRAPHIC MAPPING
OLD FARM ROAD
LAKE GENEVA, WI 53147

WORK ORDERED BY -
JORDT-FAHEY LLC
168 ELKHORN ROAD
WILLIAMS BAY, WI 53191

FARRIS, HANSEN & ASSOCIATES, INC.
ENGINEERING - ARCHITECTURE - SURVEYING

7 RIDGWAY COURT P.O. BOX 437
ELKHORN, WISCONSIN 53121
OFFICE: (262) 723-2098 FAX: (262) 723-5886

REVISIONS

PROJECT NO.
9971

DATE
06/22/2018

SHEET NO.
1 OF 1

JUN 25 2018

X:\PROJECTS\9971\ACAD\9971.DWG

MAP SCALE IN FEET - ORIGINAL 1"=20'

IW-506

117-4145