


PLAT OF SURVEY
-OF-

LOT 1 OF CERTIFIED SURVEY MAP NO. 2274, AS RECORDED IN THE OFFICE OF THE REGISTER OF DEEDS FOR WALWORTH COUNTY, WISCONSIN ON FEBRUARY 25, 1993 IN VOLUME 11 OF CERTIFIED SURVEY MAPS ON PAGES 98-99 AS DOCUMENT NO. 252291 AND BEING A PART OF THE NORTHEAST 1/4 OF THE SOUTHWEST 1/4 OF SECTION 22, TOWNSHIP 1 NORTH, RANGE 17 EAST OF THE FOURTH PRINCIPAL MERIDIAN, IN THE TOWN OF LINN, WALWORTH COUNTY, WISCONSIN.


ALSO: THAT PART OF THE NORTHEAST 1/4 OF THE SOUTHWEST 1/4 OF SECTION 22, TOWNSHIP 1 NORTH, RANGE 17 EAST OF THE FOURTH PRINCIPAL MERIDIAN, BEING DESCRIBED AS FOLLOWS: BEGINNING AT THE NORTHEAST CORNER OF LOT 1 OF CERTIFIED SURVEY MAP NO. 2274, RECORDED FEBRUARY 25, 1993 AS DOCUMENT NO. 252291, IN VOLUME 11, PAGES 98-99, BY THE WALWORTH COUNTY REGISTER OF DEEDS; THENCE SOUTH 87°15'30" WEST ALONG THE NORTH LINE OF SAID LOT 1, FOR A DISTANCE OF 456.00 FEET TO THE NORTHWEST CORNER OF SAID LOT 1; THENCE SOUTH 278.18 FEET ALONG THE WEST LINE OF SAID LOT 1, TO THE SOUTHWEST CORNER OF SAID LOT 1; THENCE WEST 45.69 FEET ALONG THE WESTERLY EXTENSION OF THE SOUTH LINE OF SAID LOT 1; THENCE NORTH 341.99 FEET; THENCE NORTH 87°15'30" EAST, 501.74 FEET TO THE EAST LINE OF SAID LOT 1 EXTENDED NORTH; THENCE SOUTH ALONG SAID EXTENSION, 66.00 FEET TO THE PLACE OF BEGINNING. SAID LAND BEING IN THE TOWN OF LINN, WALWORTH COUNTY, WISCONSIN.

SURVEY FOR: STEVEN & CHRISTINE SILER
SURVEY ADDRESS: N1029 BRINK ROAD, LAKE GENEVA, WI 53147

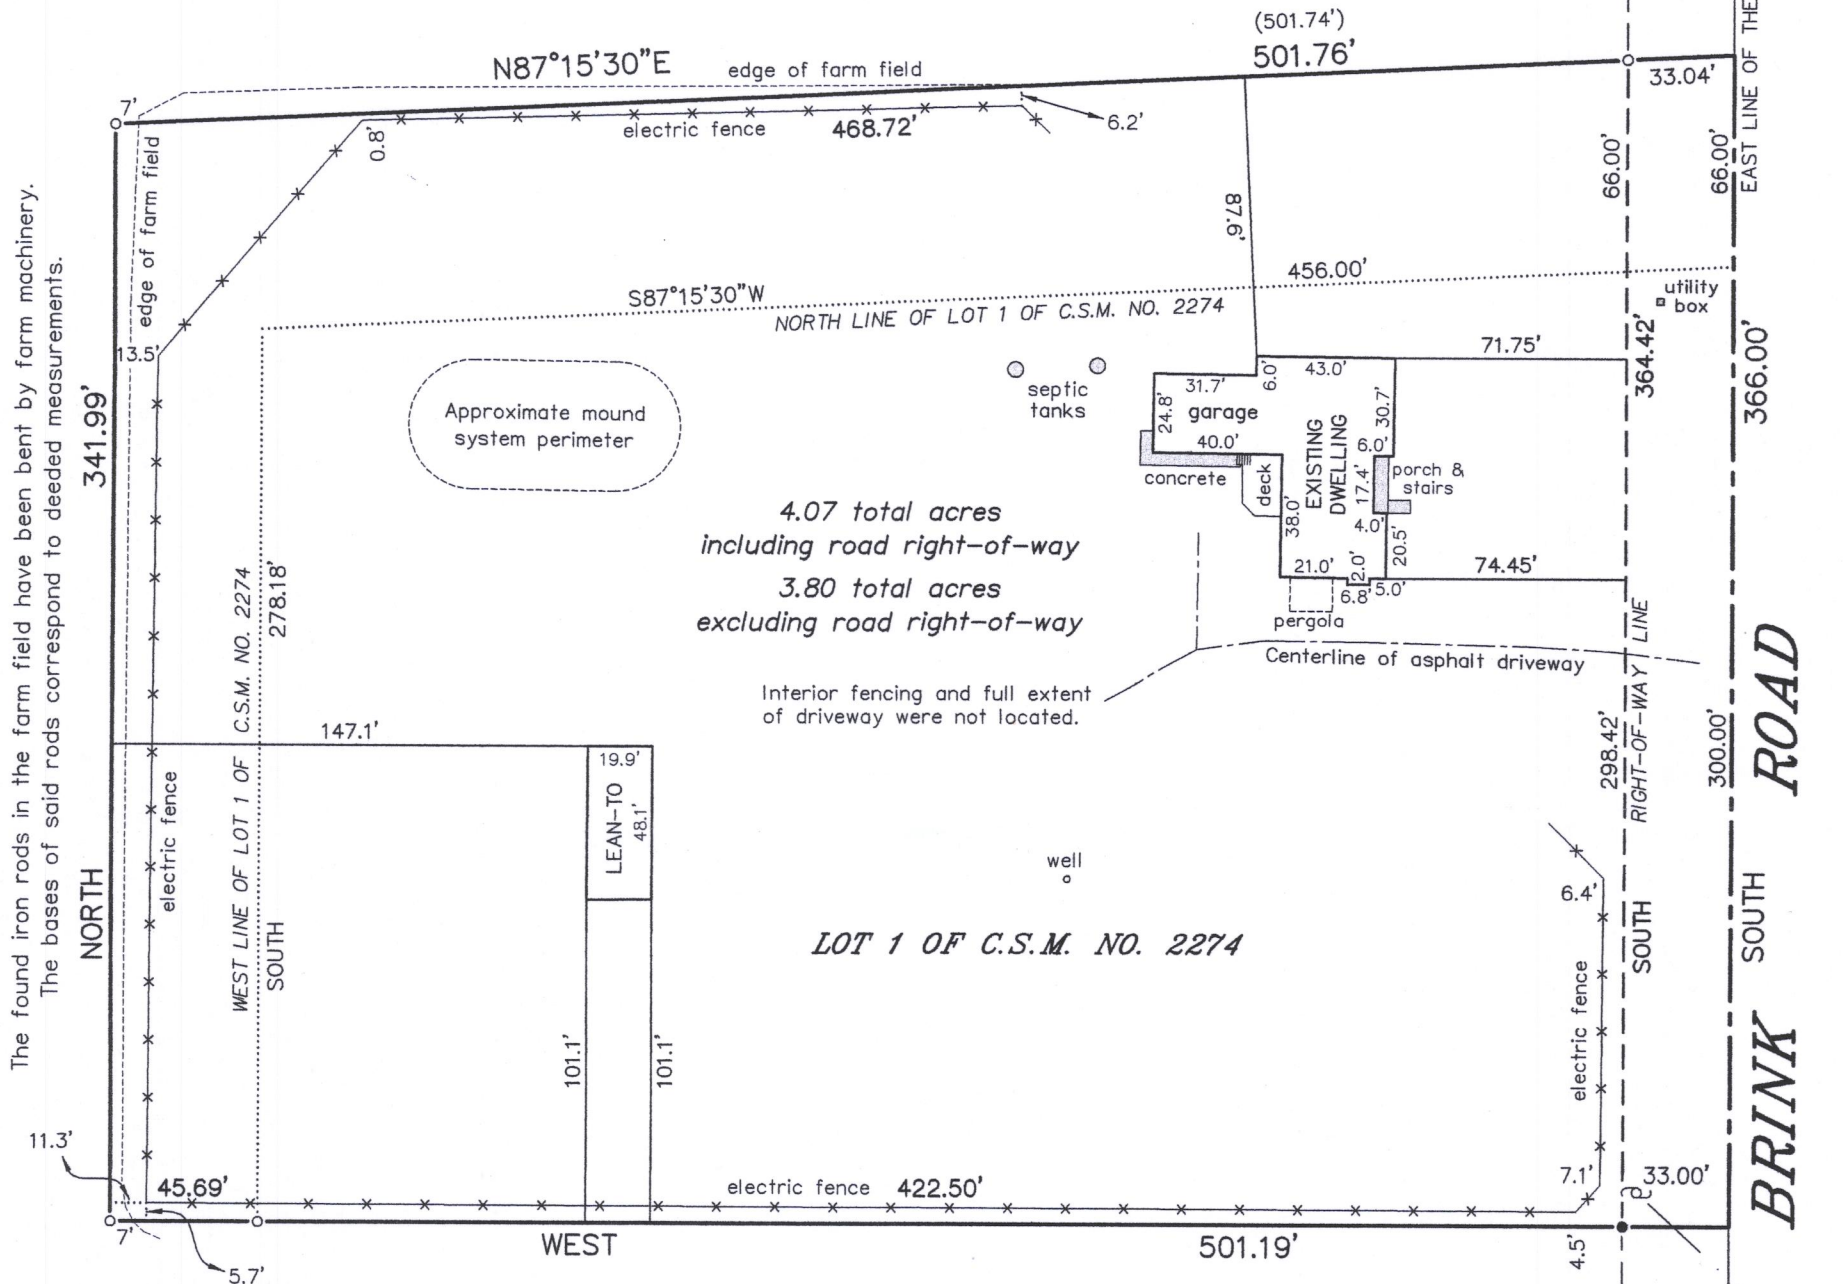

LEGEND

- FOUND WALWORTH COUNTY BRASS CAPPED MONUMENT
- FOUND IRON ROD
- SET IRON PIPE
- RECORDED AS
- UTILITY POLE
- OVERHEAD UTILITY LINES

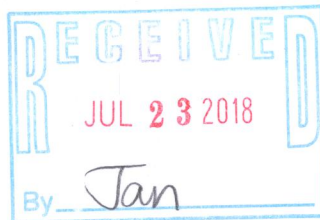



BEARINGS HEREON RELATE TO THE EAST LINE OF THE SOUTHWEST 1/4 OF SECTION 22-1-17. ASSUMED BEARING OF NORTH.



"I HEREBY CERTIFY THAT I HAVE SURVEYED THE ABOVE DESCRIBED PROPERTY AND THAT THE ABOVE MAP IS A CORRECT REPRESENTATION THEREOF AND SHOWS THE SIZE AND LOCATION OF THE PROPERTY, ITS EXTERIOR BOUNDARIES, THE LOCATION OF ALL VISIBLE STRUCTURES AND DIMENSIONS OF ALL PRINCIPAL BUILDINGS THEREON, BOUNDARY FENCES, APPARENT EASEMENTS, ROADWAYS AND ENCROACHMENTS, IF ANY."

"THIS SURVEY IS MADE FOR THE USE OF THE PRESENT OWNERS OF THE PROPERTY, AND THOSE WHO PURCHASE, MORTGAGE, OR GUARANTEE THE TITLE THERETO WITHIN ONE YEAR FROM DATE HEREOF."

SATTER SURVEYING, LLC
LAND SURVEYS, MAPPING AND PLANNING
272 ORIGIN STREET
BURLINGTON, WI 53105
262-661-4239

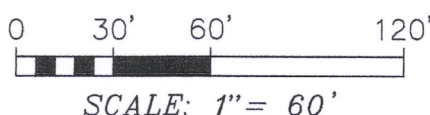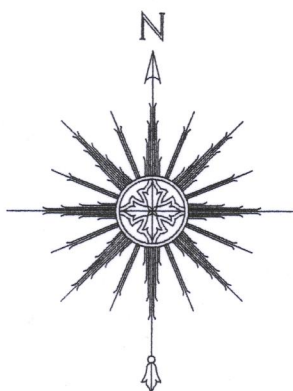

SCALE: 1" = 60'

THIS IS NOT AN ORIGINAL PRINT
UNLESS THIS SEAL IS RED.

Thomas L. Satter
THOMAS L. SATTER S-2850

MAY 24, 2018
DATE

041816
JOB NUMBER

IA 2274-1

117-4155