

PLAT OF SURVEY



LOCATION: Maple Ridge Road, Town of Linn, Wisconsin

LEGAL DESCRIPTION:

Lot 8 in MEADOW VIEW ESTATES, being subdivision of the Northeast 1/4 of the Southeast 1/4, the Southeast 1/4 of the Southeast 1/4 and the Southwest 1/4 of the Southeast 1/4 of Section 17, Town 1 North, Range 17 East of the Fourth Principal Meridian, Town of Linn, County of Walworth, State of Wisconsin.

February 7, 2019

Survey No. 110107-B

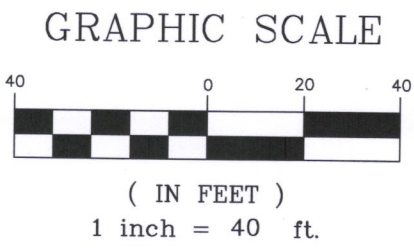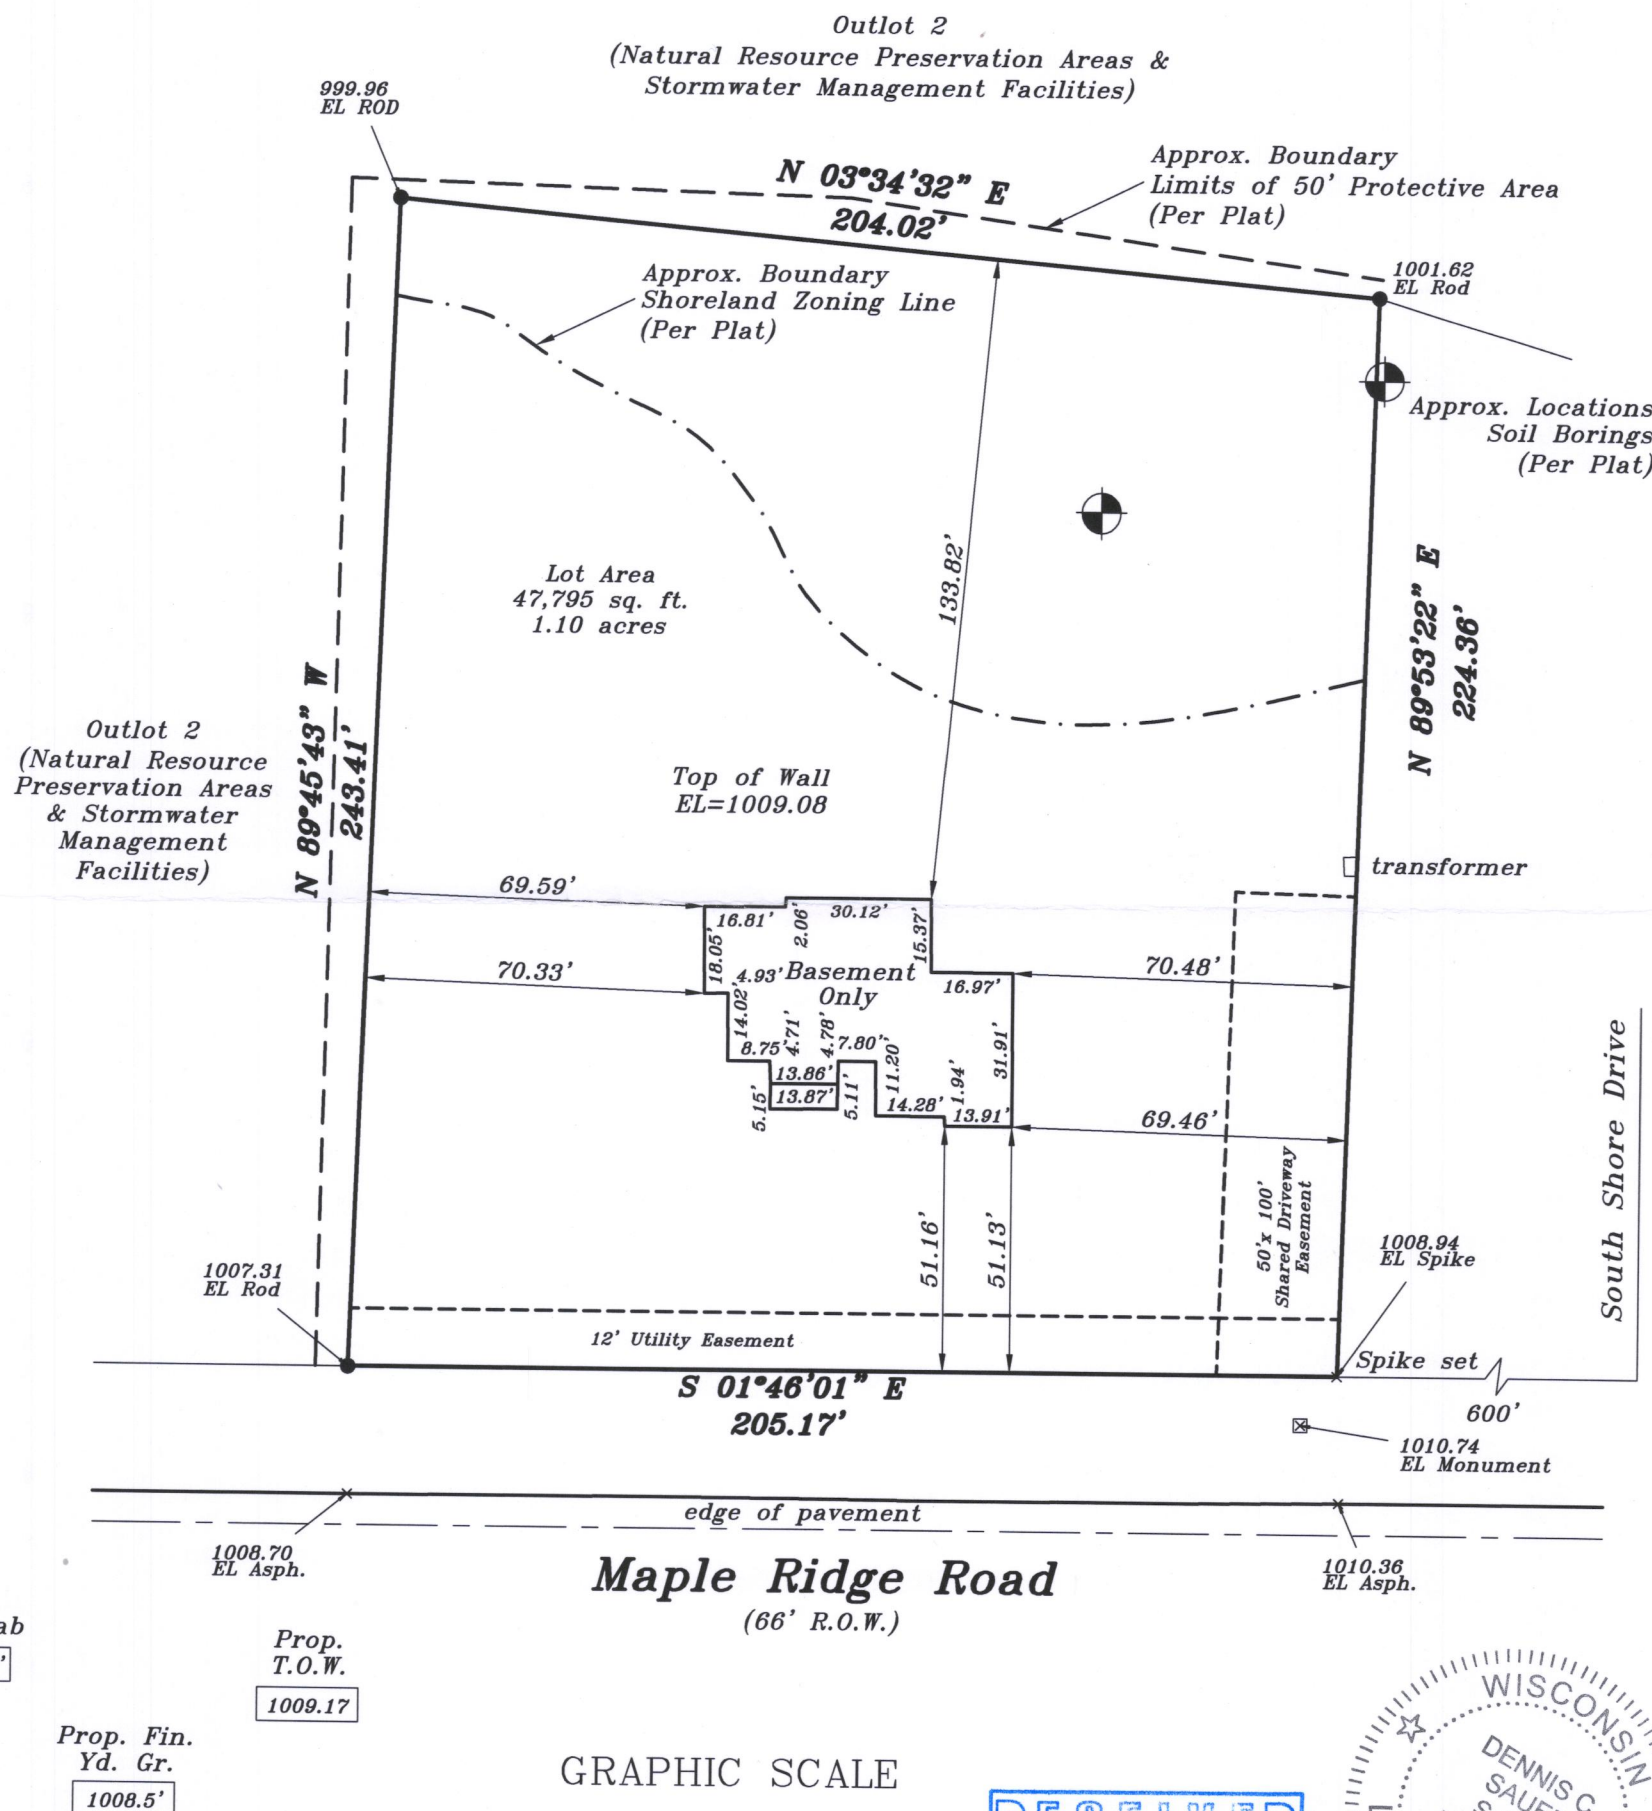

RECEIVED
MAR 7 2019
By *[Signature]*

WISCONSIN
DENNIS C. SAUER
S-2421
FRANKLIN, WI
LAND SURVEYOR

Proposed finished yard, 1st floor or top of foundation grade shown on this drawing is a suggested grade and should be verified by the owner, builder or municipality

METROPOLITAN SURVEY SERVICE, INC.
PROFESSIONAL LAND SURVEYORS AND CIVIL ENGINEERS
9415 West Forest Home Avenue, Suite 202
Hales Corners, Wisconsin 53130
PH. (414) 529-5380 FAX (414) 529-9787
email address: survey@metropolitansurvey.com

I HEREBY CERTIFY THAT I HAVE SURVEYED THE ABOVE DESCRIBED PROPERTY AND THAT THE ABOVE MAP IS A TRUE REPRESENTATION THEREOF AND SHOWS THE SIZE AND LOCATION OF THE PROPERTY. ITS EXTERIOR BOUNDARIES, THE LOCATION OF ALL VISIBLE STRUCTURES AND DIMENSIONS OF ALL PRINCIPAL BUILDINGS THEREON, BOUNDARY FENCES, APPARENT EASEMENTS AND ROADWAYS AND VISIBLE ENCROACHMENT, IF ANY.

THIS SURVEY IS MADE FOR THE EXCLUSIVE USE OF THE PRESENT OWNERS OF THE PROPERTY, AND ALSO THOSE WHO PURCHASE, MORTGAGE, OR GUARANTEE THE TITLE THERETO WITHIN ONE (1) YEAR FROM THE DATE HEREOF.

SIGNED *[Signature]*
Dennis C. Sauer
Professional Land Surveyor S-2421

• — Denotes Iron Rod Found
000.0 — Denotes Proposed Grade

IMEA-8 117-4238