
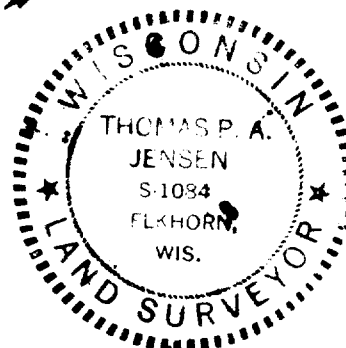


PLAT OF SURVEY

OF

LOT 39 AND THE SOUTH $\frac{1}{2}$ OF LOT 38 BLOCK J
CISCO BEACH SUBDIVISION, LOCATED IN
THE NE $\frac{1}{4}$ OF SECTION 5, T1N R17E,
WALKWORTH COUNTY, WISCONSIN.

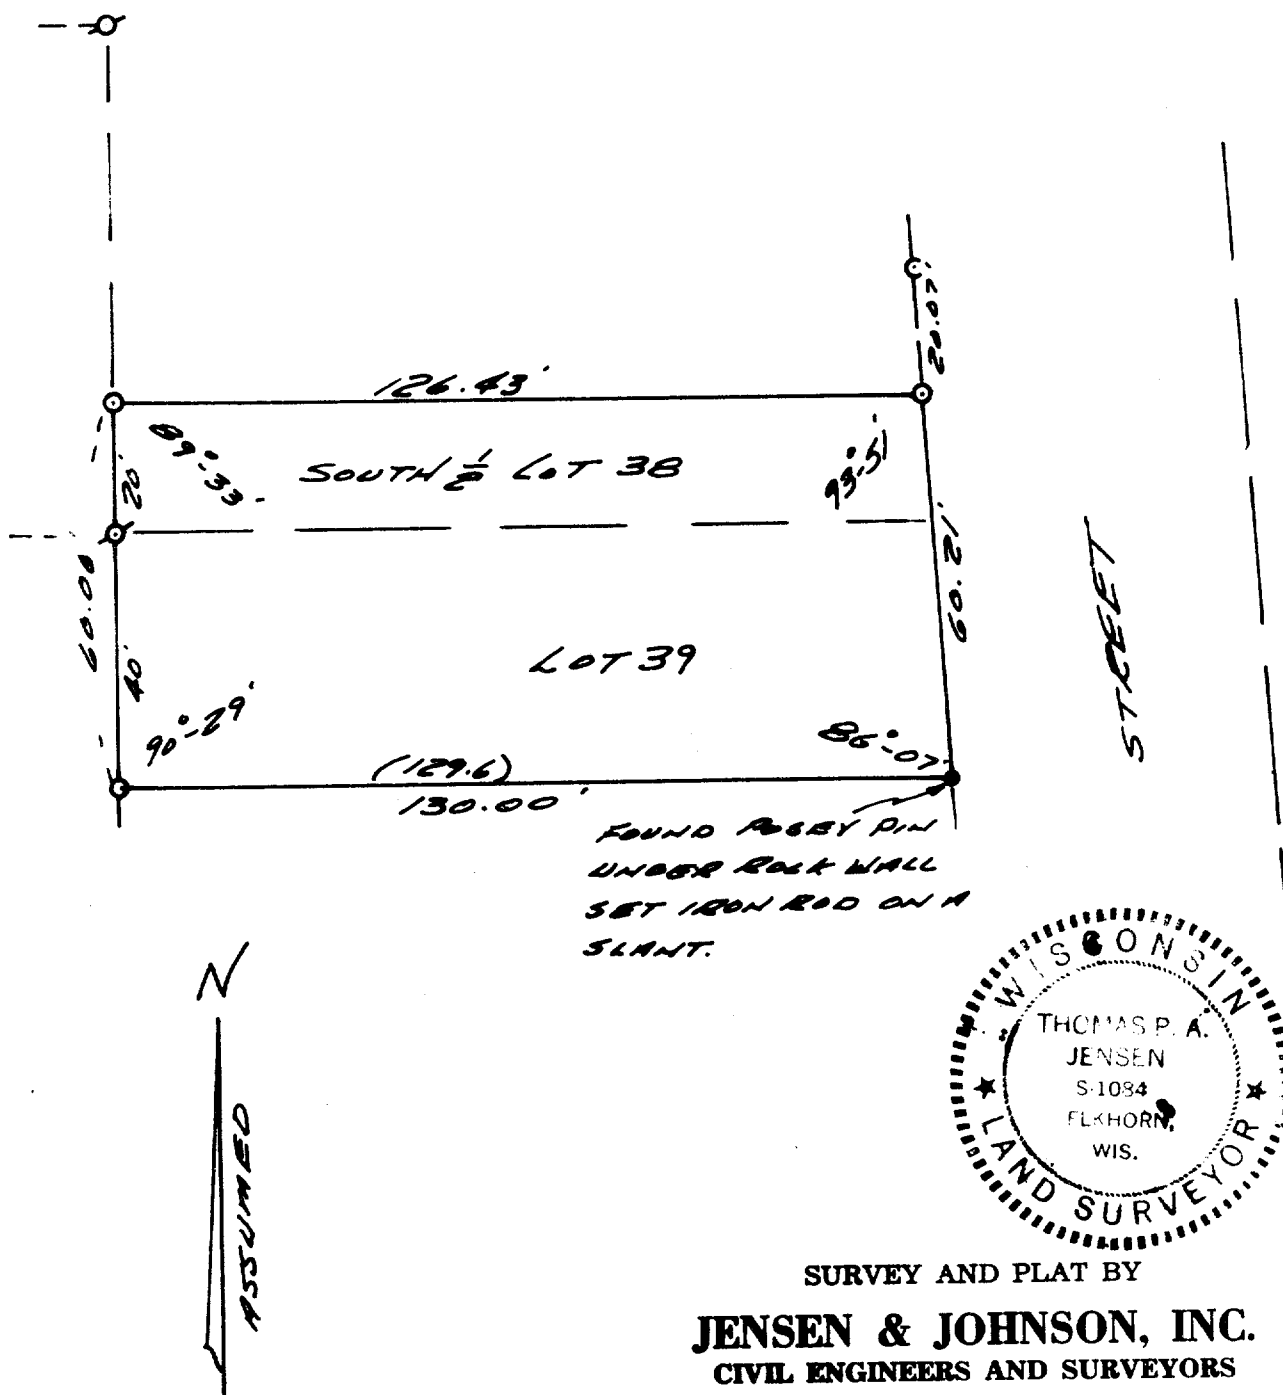

SURVEY AND PLAT BY

JENSEN & JOHNSON, INC.
CIVIL ENGINEERS AND SURVEYORS

Elkhorn, Wisconsin

LEGEND

- — Iron Pipe SET
- — Concrete Monument
- Scale 1" = 30'

- — IRON PIPE FOUND
- — IRON ROD SET
- C — POSEY PIN FOUND
- () — RECORD

WE CERTIFY: That we have surveyed the above described property and that the plat shown hereon is an accurate survey and a true representation thereof and correctly shows the exterior boundary lines and all divisions of said property.

Date AUG. 21, 1973

Thomas P. A. Jensen

Wisconsin Registered Land Surveyor, No. S-1034