


PLAT OF SURVEY

OF

LOT 70 LAKE GENEVA HIGHLANDS, A SUBDIVISION
LOCATED IN THE $N\frac{1}{2}$ OF THE SE FRACTIONAL $\frac{1}{4}$ OF
SECTION 8, T1N R1E, WALWORTH COUNTY,
WISCONSIN.

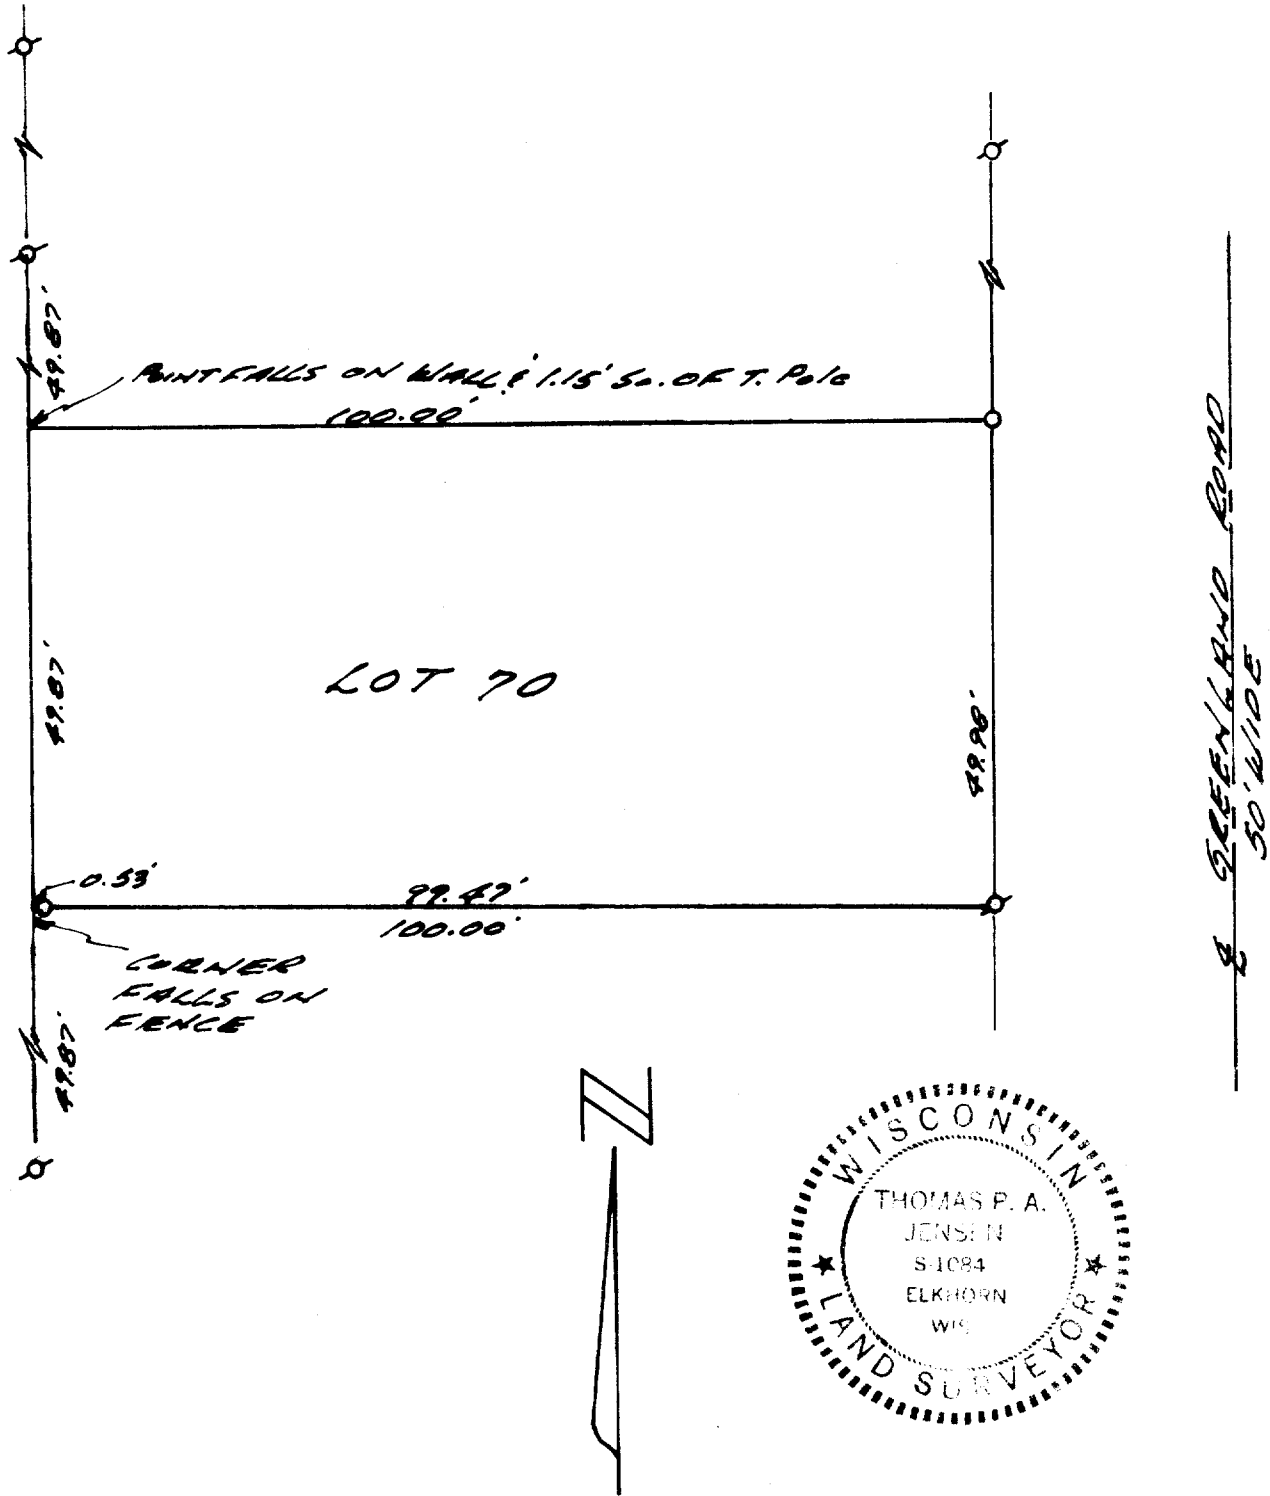

SURVEY AND PLAT BY

JENSEN & JOHNSON, INC.
CIVIL ENGINEERS AND SURVEYORS

Elkhorn, Wisconsin

LEGEND

- — Iron Pipe SET
- — Concrete Monument

Scale 1" = 20'

~ IRON PIPE FOUND

WE CERTIFY: That we have surveyed the above described property and that the plat shown hereon is an accurate survey and a true representation thereof and correctly shows the exterior boundary lines and all divisions of said property.

Date JULY 11, 1973 Thomas P. A. Jensen

Wisconsin Registered Land Surveyor, No. S-1084