


A PARCEL OF LAND LOCATED IN THE NORTHEAST $\frac{1}{4}$ OF THE SOUTHEAST $\frac{1}{4}$ OF SECTION 28, TOWNSHIP 1 NORTH, RANGE 17 EAST, IN THE TOWN OF LINN, WALWORTH COUNTY, WISCONSIN.

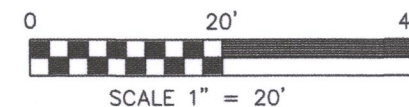

- | | |
|---|-----------------------|
|  | FOUND IRON PIPE |
|  | SET IRON PIPE |
| (X X) | RECORDED AS |
|  | ACCESSIBLE RAMP |
|  | RETAINING WALL GARDEN |
| — — — — — | SETBACK LINE |
| — — — — — | WOODEN FENCE |

LEGAL DESCRIPTION:

A PARCEL OF LAND LOCATED IN THE NORTHEAST $\frac{1}{4}$ OF THE SOUTHEAST $\frac{1}{4}$ OF SECTION 28, TOWNSHIP 1 NORTH, RANGE 17 EAST, IN THE TOWN OF LINN, WALWORTH COUNTY, WISCONSIN; BEING FURTHER DESCRIBED AS FOLLOWS:


LOTS 4 AND 5 OF BLOCK 1 OF KUEBKER ADDITION TO THE VILLAGE OF ZENDA, RECORDED AS DOCUMENT #174568 IN THE WALWORTH COUNTY REGISTER OF DDEDS

OWNER:

PEARL A HEINRICH
PO BOX 37
ZENDA, WI 53195

SURVEYOR:

PAUL H. VAN HENKELUM
CARDINAL ENGINEERING LLC
201 BROAD STREET, SUITE B
LAKE GENEVA, WI 53147
414-406-3248

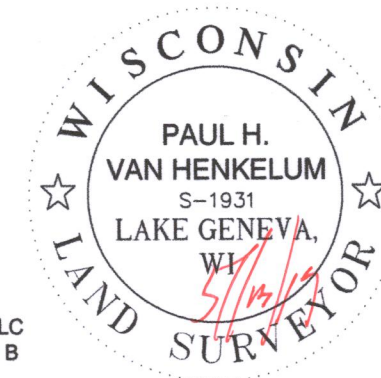

NOTE:

1. BASIS OF BEARING: THE WISCONSIN STATE PLAN COORDINATE SYSTEM, SOUTH ZONE NAD27.

CARDINAL ENGINEERING LLC
DESIGNING IN TRUE DIRECTIONS

201 BROAD STREET, STE. B
LAKE GENEVA, WI 53147
262-757-8776
CARDINALENGINEERINGWI.COM

DATE: 05-13-2019 JOB No. 1901326
SHEET 1 OF 1

"I HEREBY CERTIFY THAT I HAVE SURVEYED THE ABOVE DESCRIBED PROPERTY AND THE MAP IS A TRUE AND CORRECT REPRESENTATION OF ITS EXTERIOR BOUNDARIES AND SHOW THE SIZE AND LOCATION OF ALL VISIBLE STRUCTURES, APPARENT EASEMENTS AND ENCROACHMENTS, IF ANY."

PAUL H VAN HENKELUM, PLS #1931

DATE _____

117-4253

IZK-1A IZK-1AA

RECEIVED
JUL 3 2019
By Shaf