


OF

Have pretty good

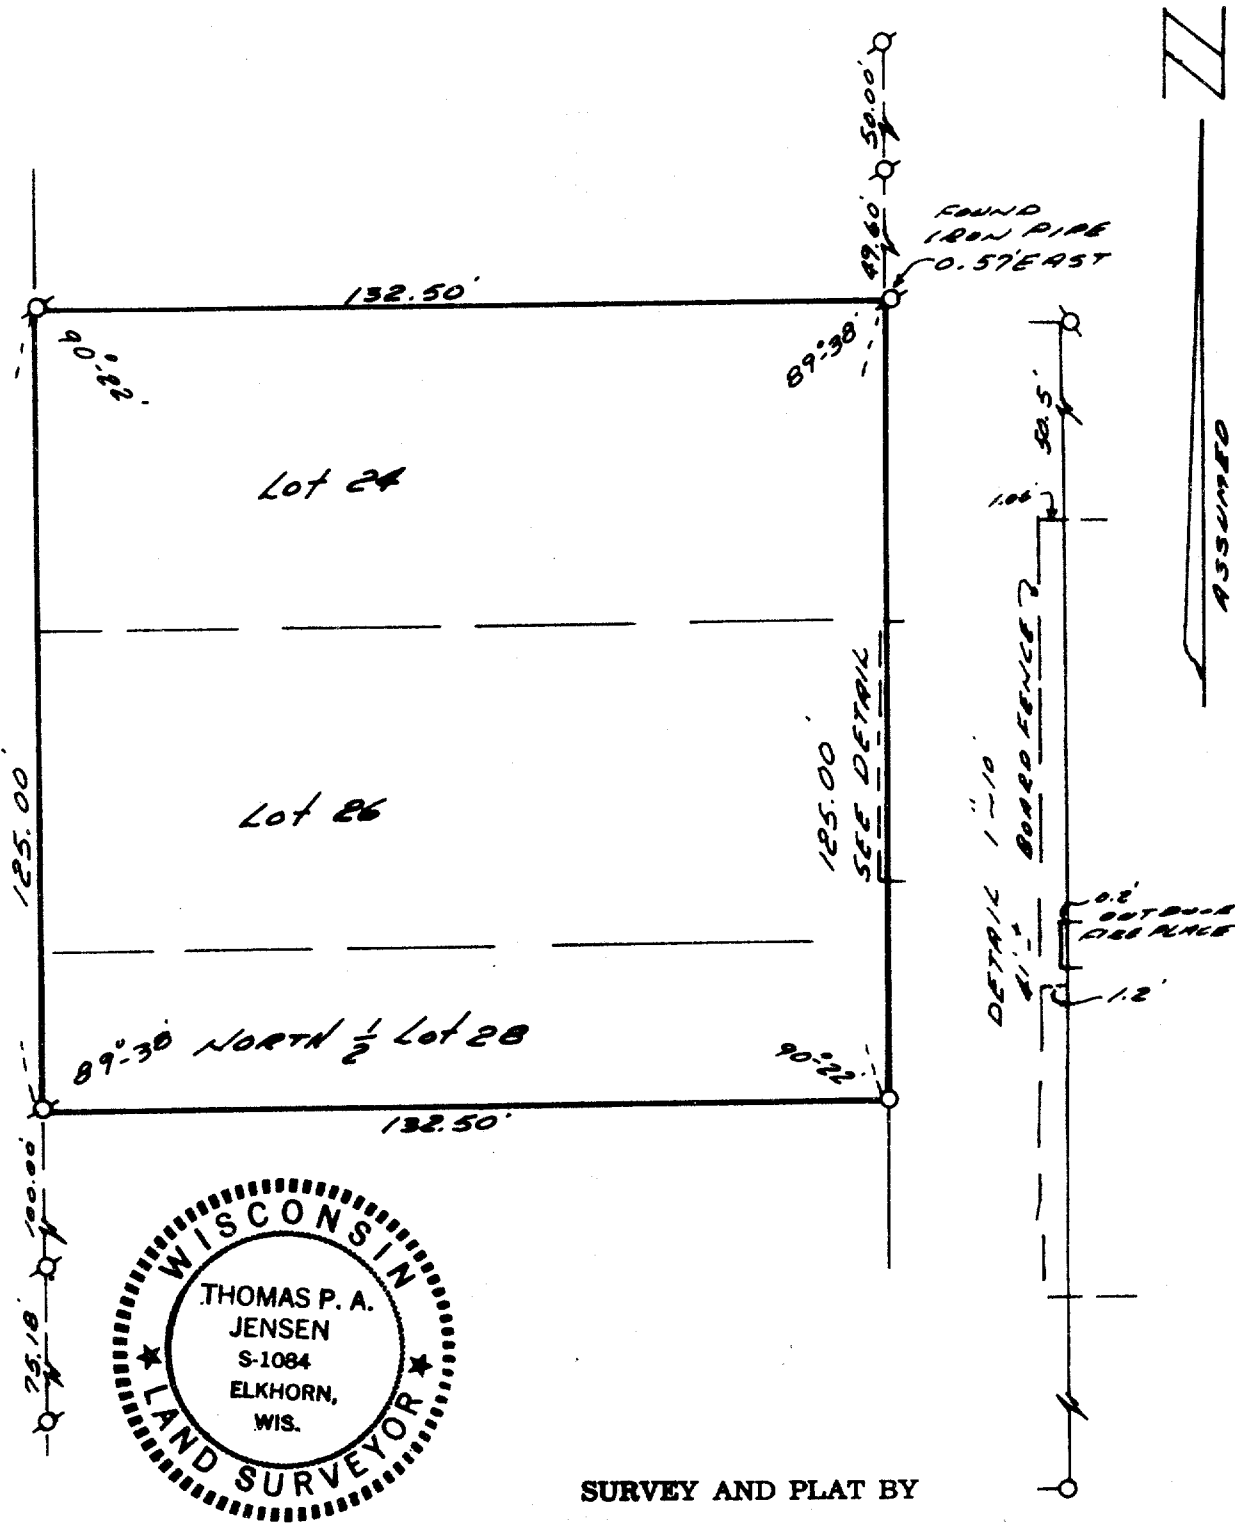

Elkhorn, Wisconsin

LEGEND

- — Iron Pipe *SET*
● — Concrete Monument

Scale 1" = 30'

Q - IRON PIPE FOUND

WE CERTIFY: That we have surveyed the above described property and that the plat shown hereon is an accurate survey and a true representation thereof and correctly shows the exterior boundary lines and all divisions of said property.

Date JUNE 12, 1973

Wisconsin Registered Land Surveyor, No. 100000

T S A - 23
" 25
" 27A

117-426