


Lot 2
C.S.M. 1519


Lot 21
Oak Shores

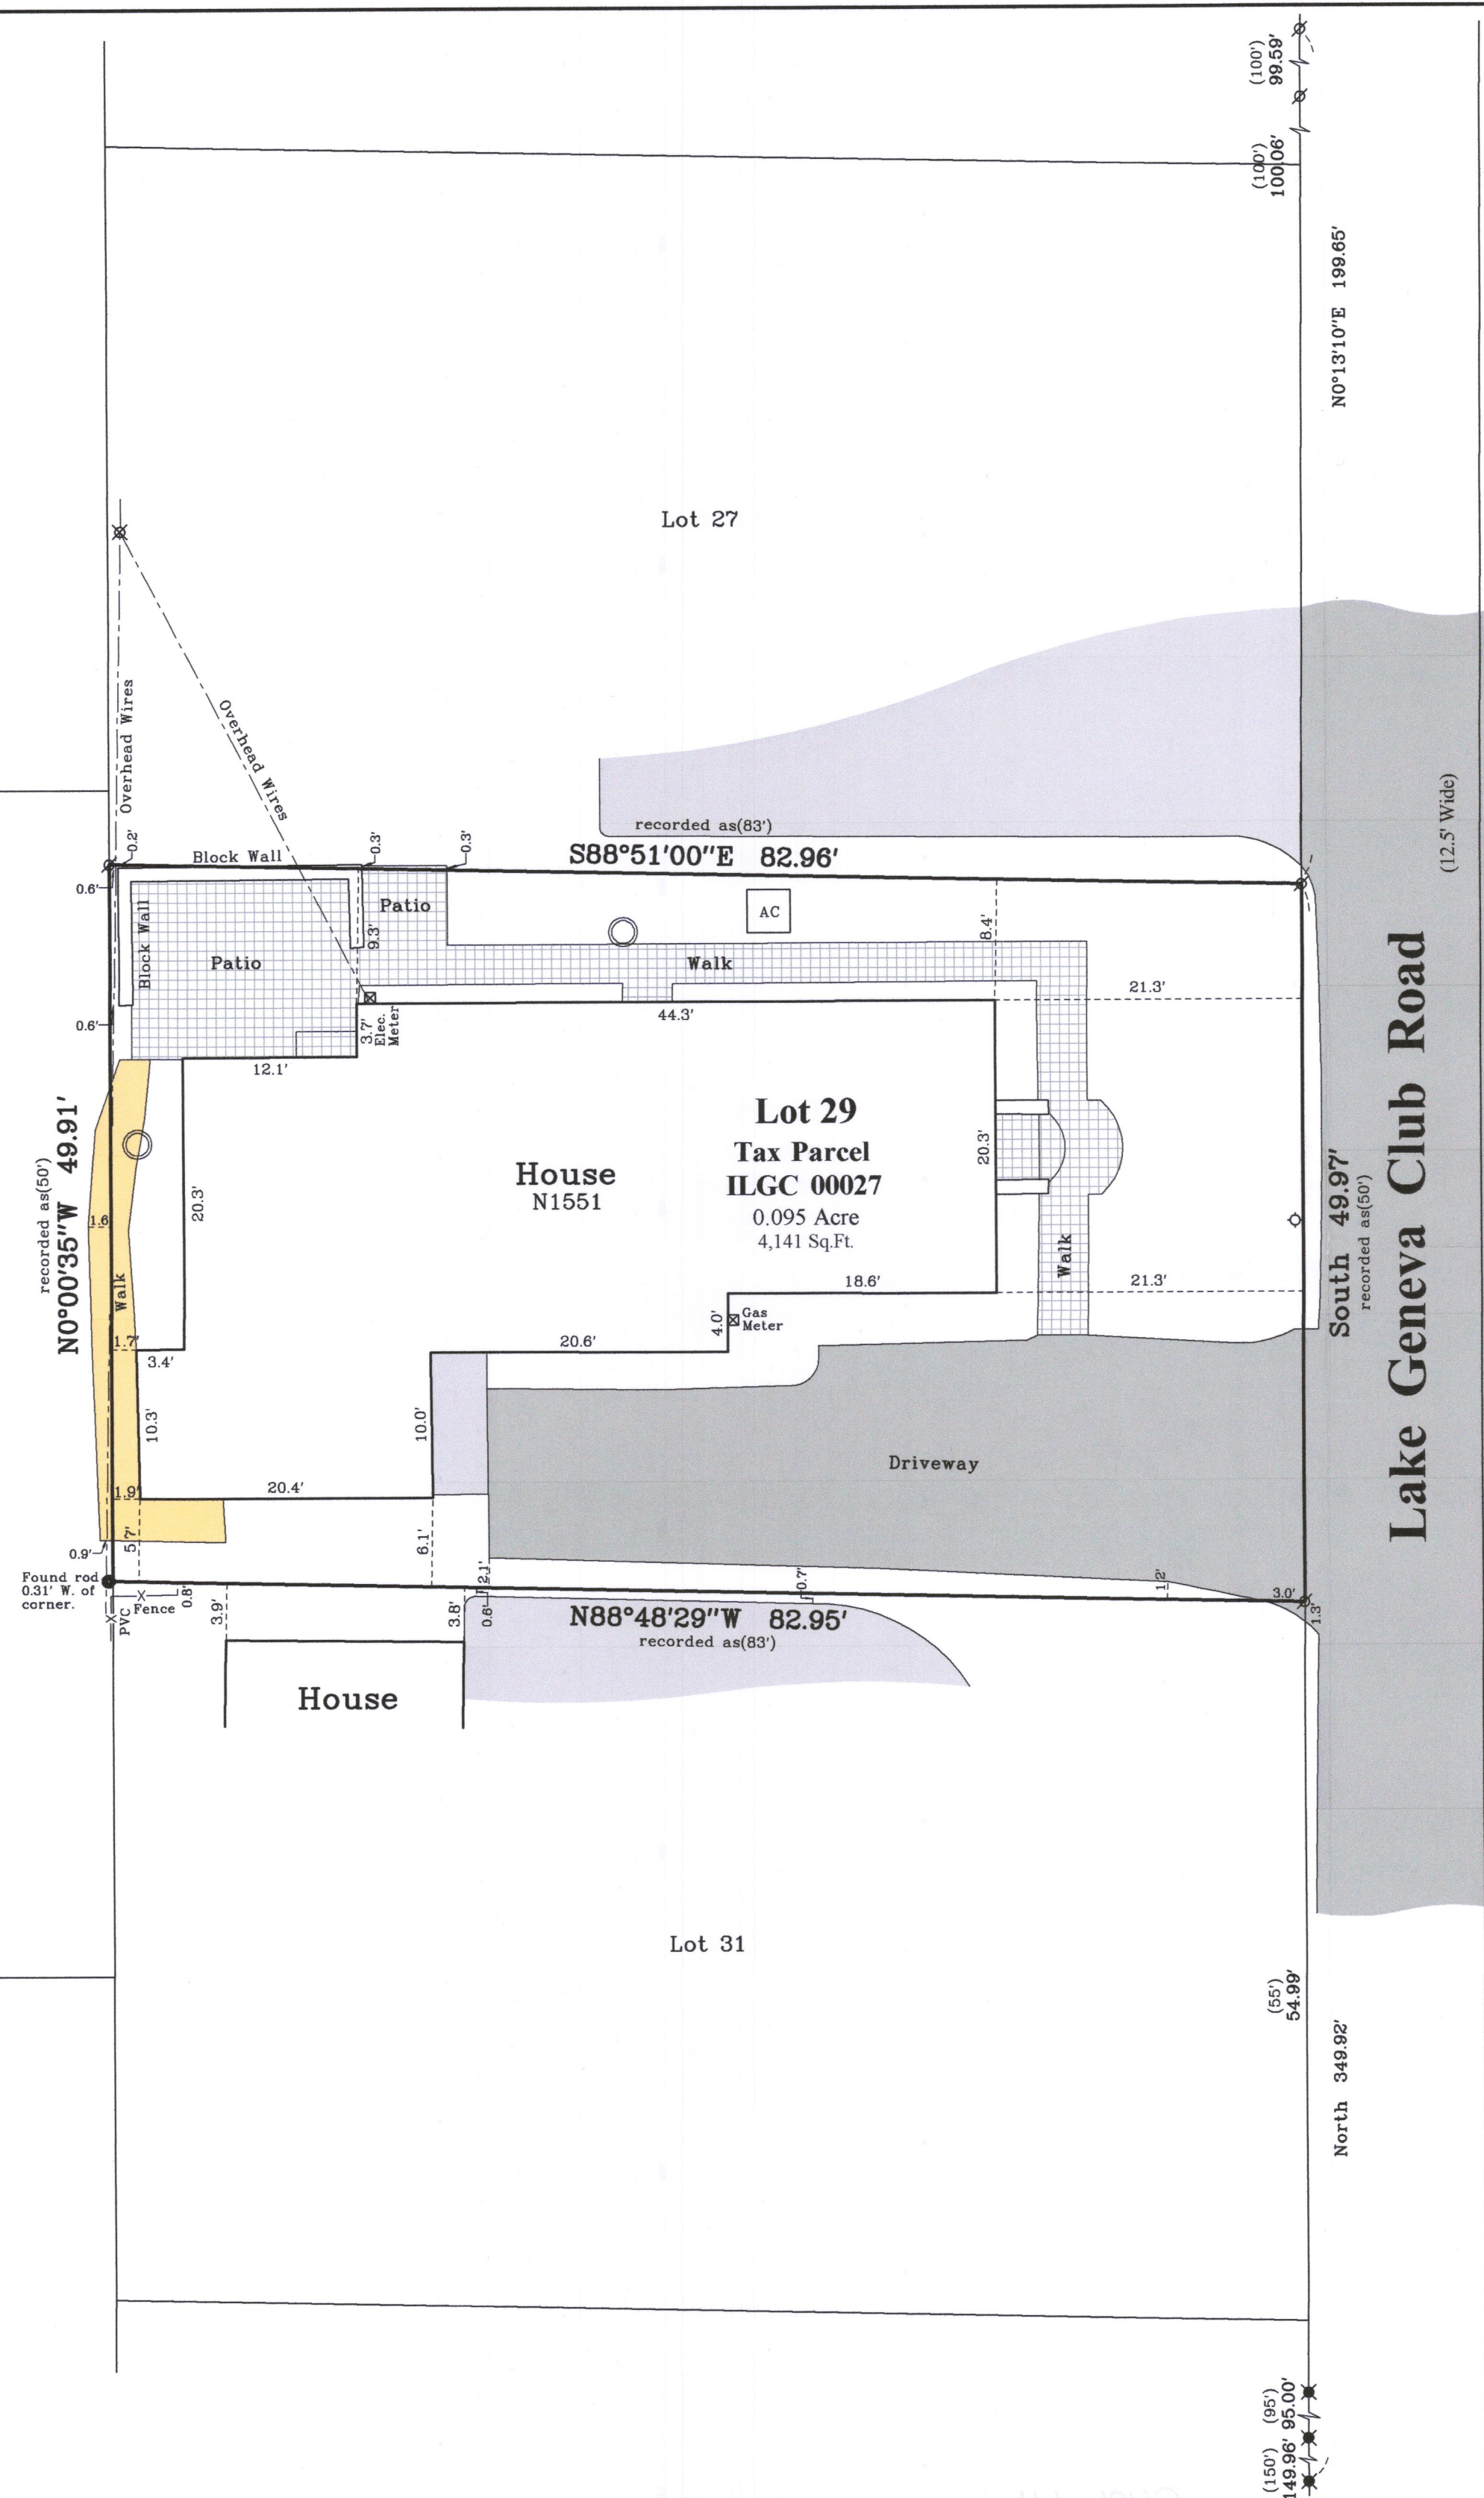


Plat of Survey

of
Lot 29 of Lake Geneva Club,
a subdivision located in Government Lot 3 in the Northwest 1/4 of Section 18,
Town 1 North, Range 17 East, Town of Linn, Walworth County, Wisconsin.

Surveyed for: **Melges Real Estate, LLC**
230 Center Street
Lake Geneva, Wisconsin. 53147

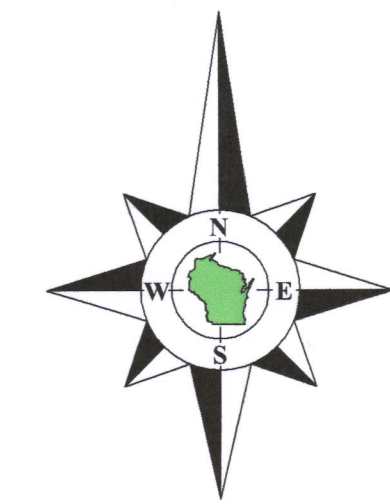

Bearings referenced to the West line of Lake Geneva Club Road, recorded as North on prior surveys of record.

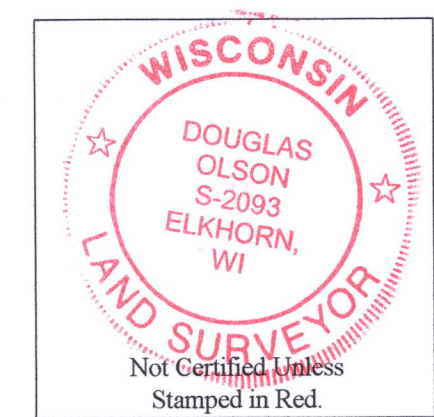


- Notes:**
- 1) This Plat of Survey is not certified unless signed and sealed in red ink.
 - 2) This survey is subject to Wisconsin lien laws. This Plat of Survey is the notice of intent to file lien. Lien waiver required.
 - 3) The Survey Date shown on this Plat of Survey is the completion date of the field work.

Copyright ©2019 by Olson Land Surveying, LLC.


All rights reserved. No part of this survey plat may be reproduced or transmitted in any form by any means - graphic, electronic, or mechanical, including photocopying, tracing, or information storage and retrieval systems - without permission in writing from Douglas G. Olson, Olson Land Surveying, LLC.

I hereby certify that I have surveyed the above described property in compliance with Chapter A-E 7 of the Wisconsin Administrative Code and that the map hereon is correct to the best of my professional knowledge and belief and shows the size and location of the property, its exterior boundaries, the location and dimensions of all visible structures thereon, boundary fences, apparent easements and roadways and visible encroachments, if any.
This survey is made for the exclusive use of the present owners of the property and also those who purchase, mortgage or guarantee title thereto, within one year from the date hereof.

Douglas G. Olson
Wisconsin Professional Land Surveyor - 2093

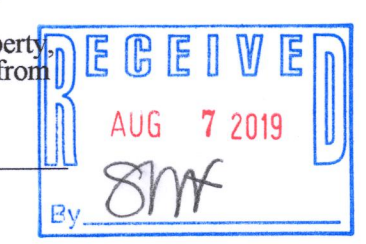

Survey Date: July 10, 2019.
Revisions:

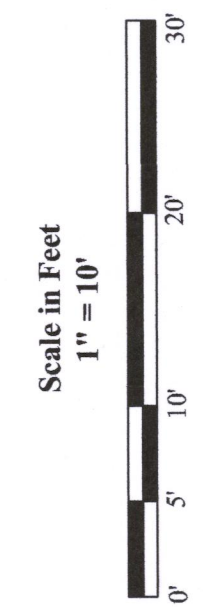

45 South Wisconsin Street | P.O. Box 322
Elkhorn, Wisconsin. 53121
Telephone: (262) 723-3434
Facsimile: (262) 723-8044
Email: doug@olsonsurveying.com
Website: www.olsonsurveying.com



Legend of Symbols & Abbreviations

N	North	Utility Pole	Utility Pedestal
S	South	Recorded Information	Brick Pavers
E	East	In Bearings	Asphalt Surface
W	West	Agrees	Concrete Surface
in	In	Water Valve	Stone Surface
ft	Feet	Asphalt Surface	
sec	Seconds	Brick Pavers	
in	In	Brick Pavers	
ft	Feet	Stone Surface	
in	In	Stone Surface	

Sheet 1 of 1 Sheets
Drawing Name:
Job Reference Number
2019.088

2019.088