


GEORGE T. DUNHAM  
SURVEYING & SUBDIVIDING  
DELAVAL, WISCONSIN

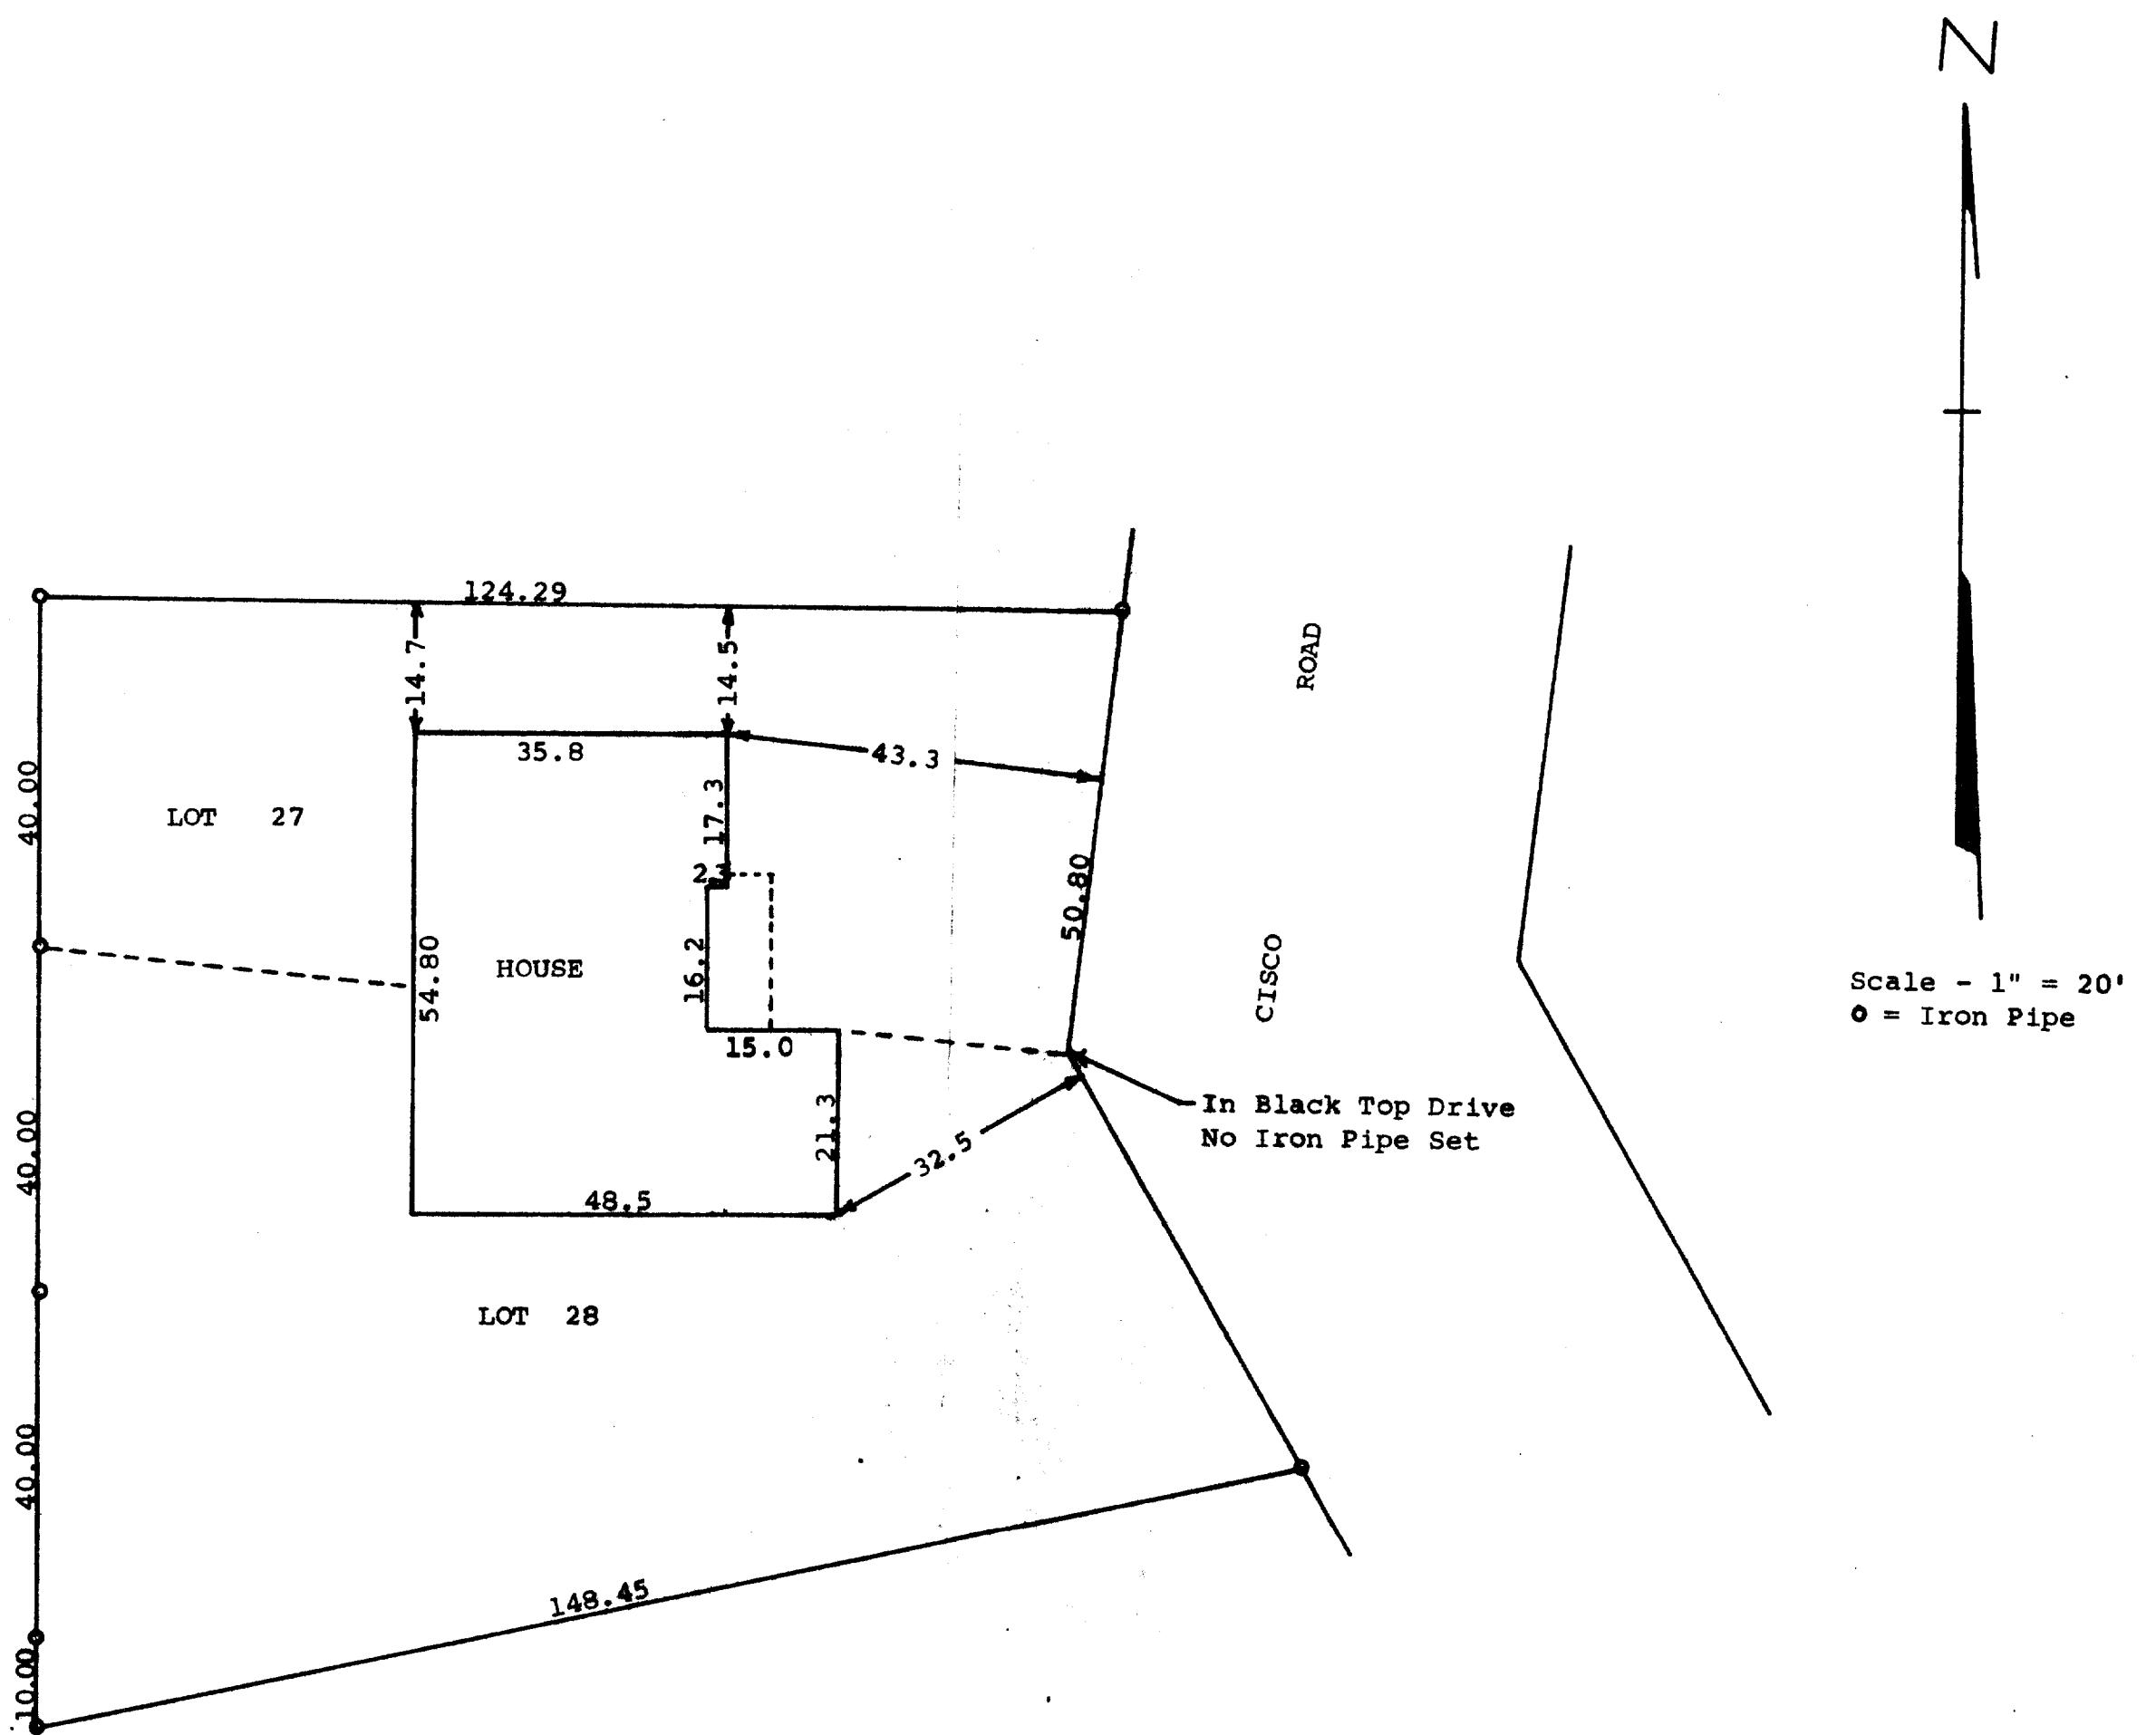

STATE OF WISCONSIN) SS  
COUNTY OF WALWORTH) SS

I, George T. Dunham, Surveyor, certify that I have surveyed the property described as follows,

Lots 27 and 28 in Block "G" of Cisco Beach, a subdivision located in Section 5, T 1 N, R 17 E, Walworth County, Wisconsin, and that the above plat is an accurate survey and a true representation thereof and correctly shows the exterior boundary lines and location of buildings on said property and the correct measurements thereof.

November 30, 1973

George T. Dunham  
George T. Dunham, Surveyor

