


denotes iron
pipe

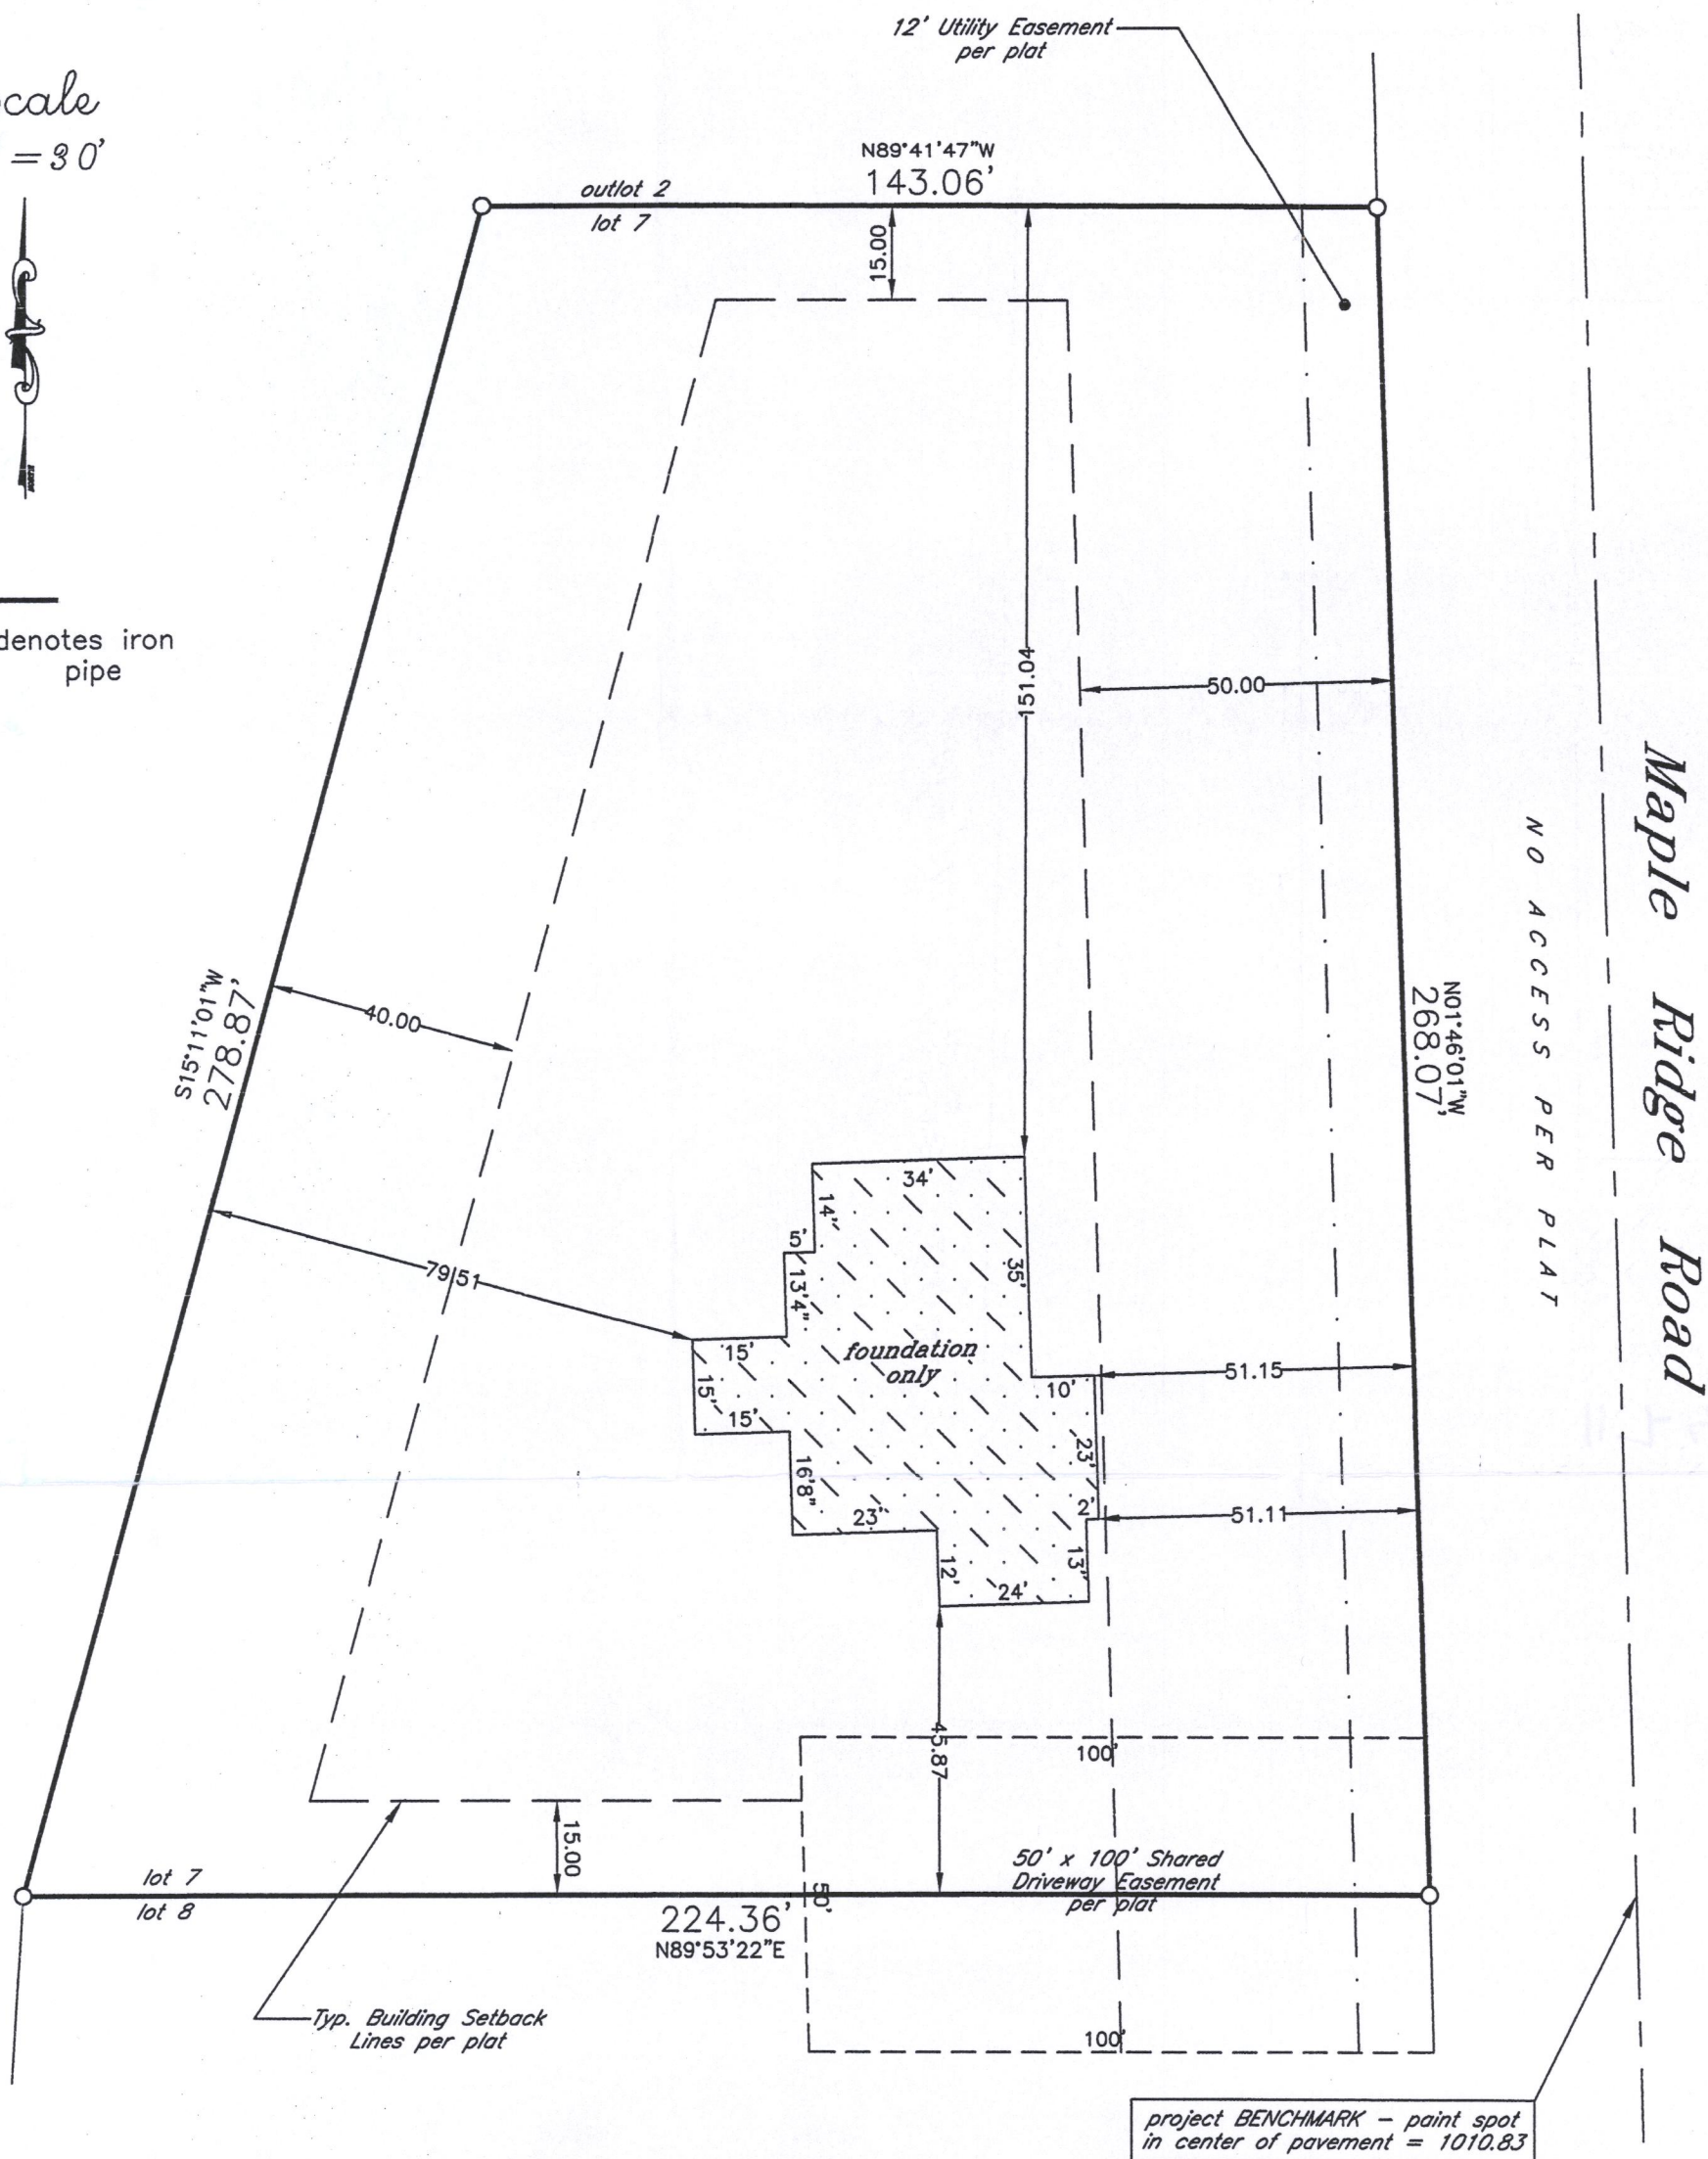

*top of foundation
elevation = 1009.10*

* outside finish grade = EL 1008.66
(advisory only) - top of foundation = EL 1009.32 (advisory only) unless otherwise determined in writing by Town Engineering Department

I hereby certify that this property was surveyed under my direction and this plat is a true representation thereof.


Reg. Land Surveyor

August 21, 2019
Revised 9/13/19
Revised 12/3/19


*
Verify exact number with
Town Engineering Department

TOWN OF LINN
WALWORTH COUNTY, WIS.

-for-
Hagen Homes

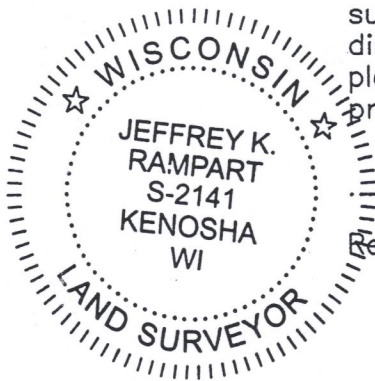

IMEA-7

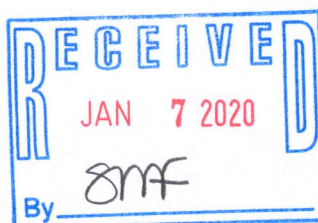

117-4229