


PLAT OF SURVEY

OF LOT 31 AND THE NORTH 5 FEET OF LOT 33 OF LAKE GENEVA CLUB, BEING PART OF THE SE 1/4 OF THE NW 1/4 OF SECTION 18, T. 1 N., R. 17 E., OF THE 4TH P.M., TOWN OF LINN, WALWORTH COUNTY, WISCONSIN.

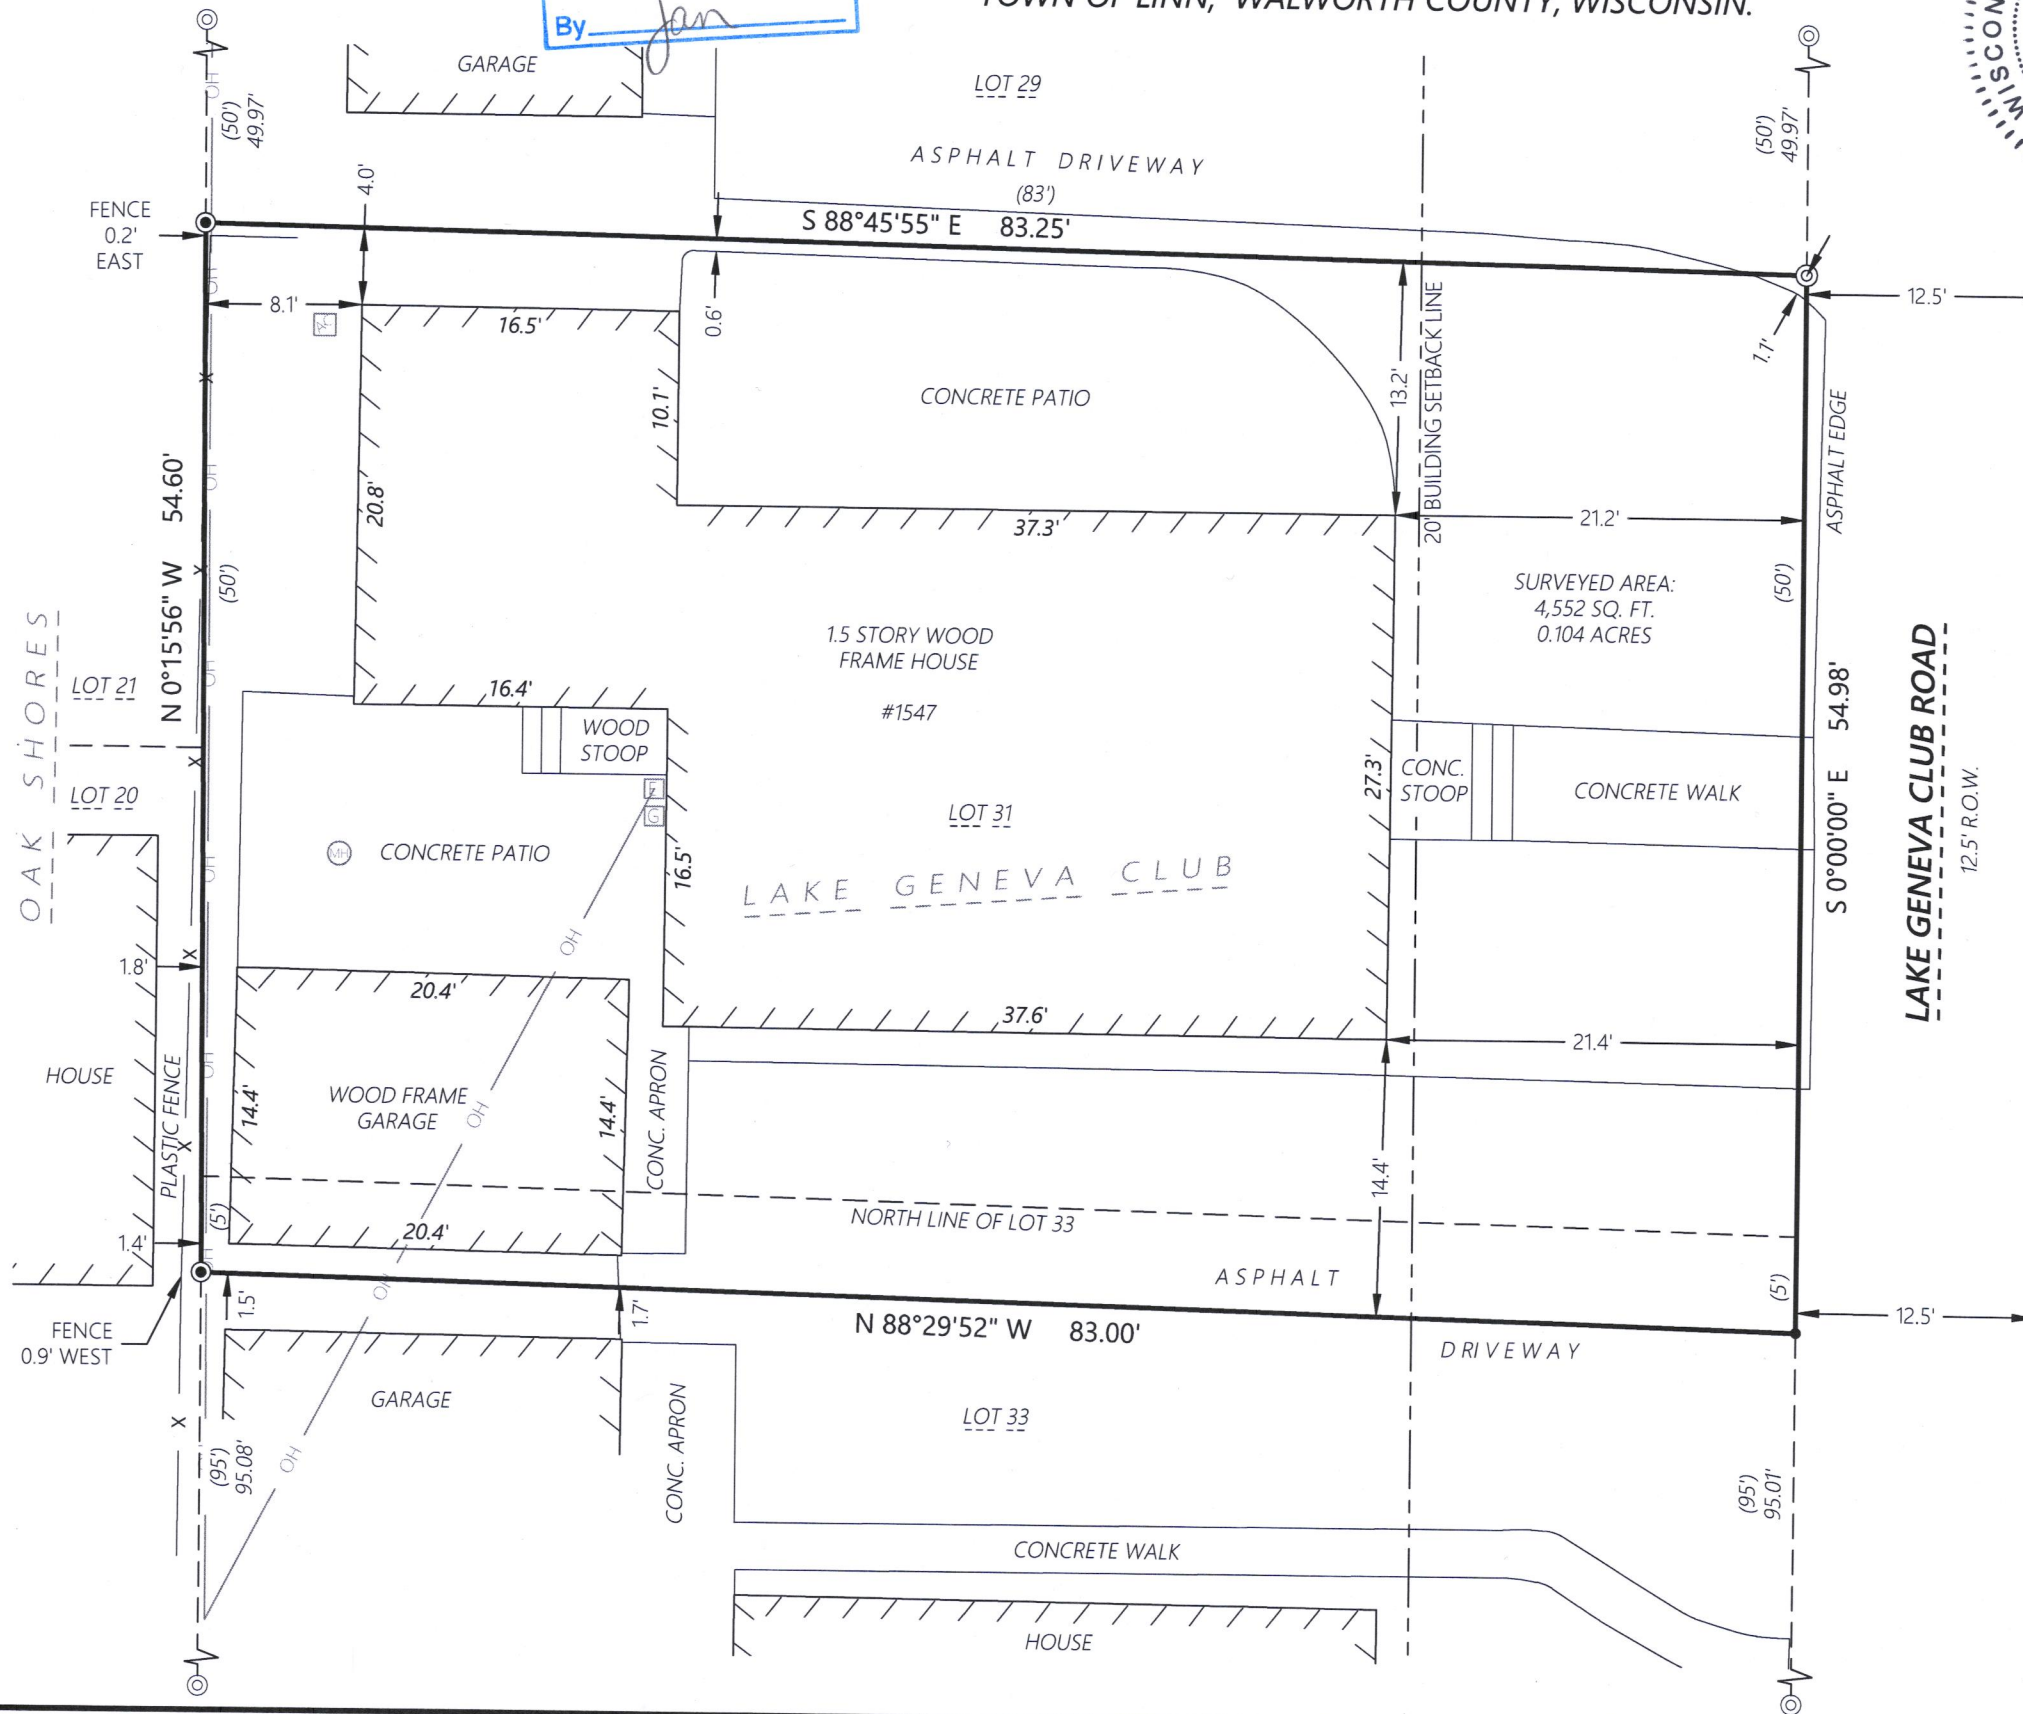

If the surveyor's signature is not red in color, the plan is a copy that should be assumed to contain unauthorized alterations. The certification contained on this document shall not apply to any copies.

Kristin J. Belongia

Kristin J. Belongia, P.L.S.
Wisconsin Professional Land Surveyor S-2943

State of Wisconsin } ss
County of Rock }


LEGEND

- Existing Boundary Line
- Existing Right-of-Way
- Existing Adjacent Property
- Existing Easement Line
- OH Existing Overhead Power
- X Existing Fence
- E Existing Electric Meter
- Existing Air Conditioner
- Existing Manhole
- Existing Gas Meter

MONUMENT KEY

- 3/4" Iron Rebar Found
- Iron Pipe Found
- PK Nail Found
- (XXX.XX) Record Information

Scale: 1" = 10'

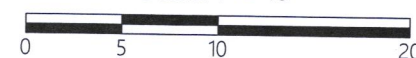

BEARINGS BASED ON THE EAST LINE OF LOT 31 BEARING S 0°00'00" E

I hereby certify that I have supervised the survey of the property described above and to the best of my knowledge and belief, the plat drawn hereon complies with Chapter A-E 7 of the State of Wisconsin Administrative Code, Minimum Standards for Property Surveys and correctly represents the size and location of the property, exterior boundaries, the location of all visible structures, and dimensions of all principle buildings thereon, fences, easements of record, and roadways, if any. This survey is made for the use of the present owners of the property, and also those who purchase, mortgage, or guarantee the title thereto within one year from the date hereof.

Given under my hand and seal this 15th day of October, 2019 at Beloit, Wisconsin
Last day of field work October 7th, 2019

FOR THE EXCLUSIVE USE OF:
The Rauland Agency
118 Kenosha Street
Walworth, WI 53184

ORDER NO: 33445

BOOK: SEE FILE
FIELD CREW: DJE
DRAWN BY: DJE
DATE: October 15th, 2019

Batterman
engineers surveyors planners
2857 Bartells Drive Beloit, Wisconsin 53511
608.365.4464 www.rhbatterman.com

PLAT OF SURVEY



TLGC-29 117-4331