


PLAT OF SURVEY

OF LOT 8, AND THE SOUTHERLY 3 FEET OF LOT 5 AND THE
NORTHERLY 5 FEET OF LOT 9, CAMP SYBIL, BEING PART OF THE
SW 1/4 OF THE NE 1/4 OF SECTION 18, T. 1 N., R. 17 E., OF THE
4TH P.M., TOWN OF LINN, WALWORTH COUNTY, WISCONSIN.

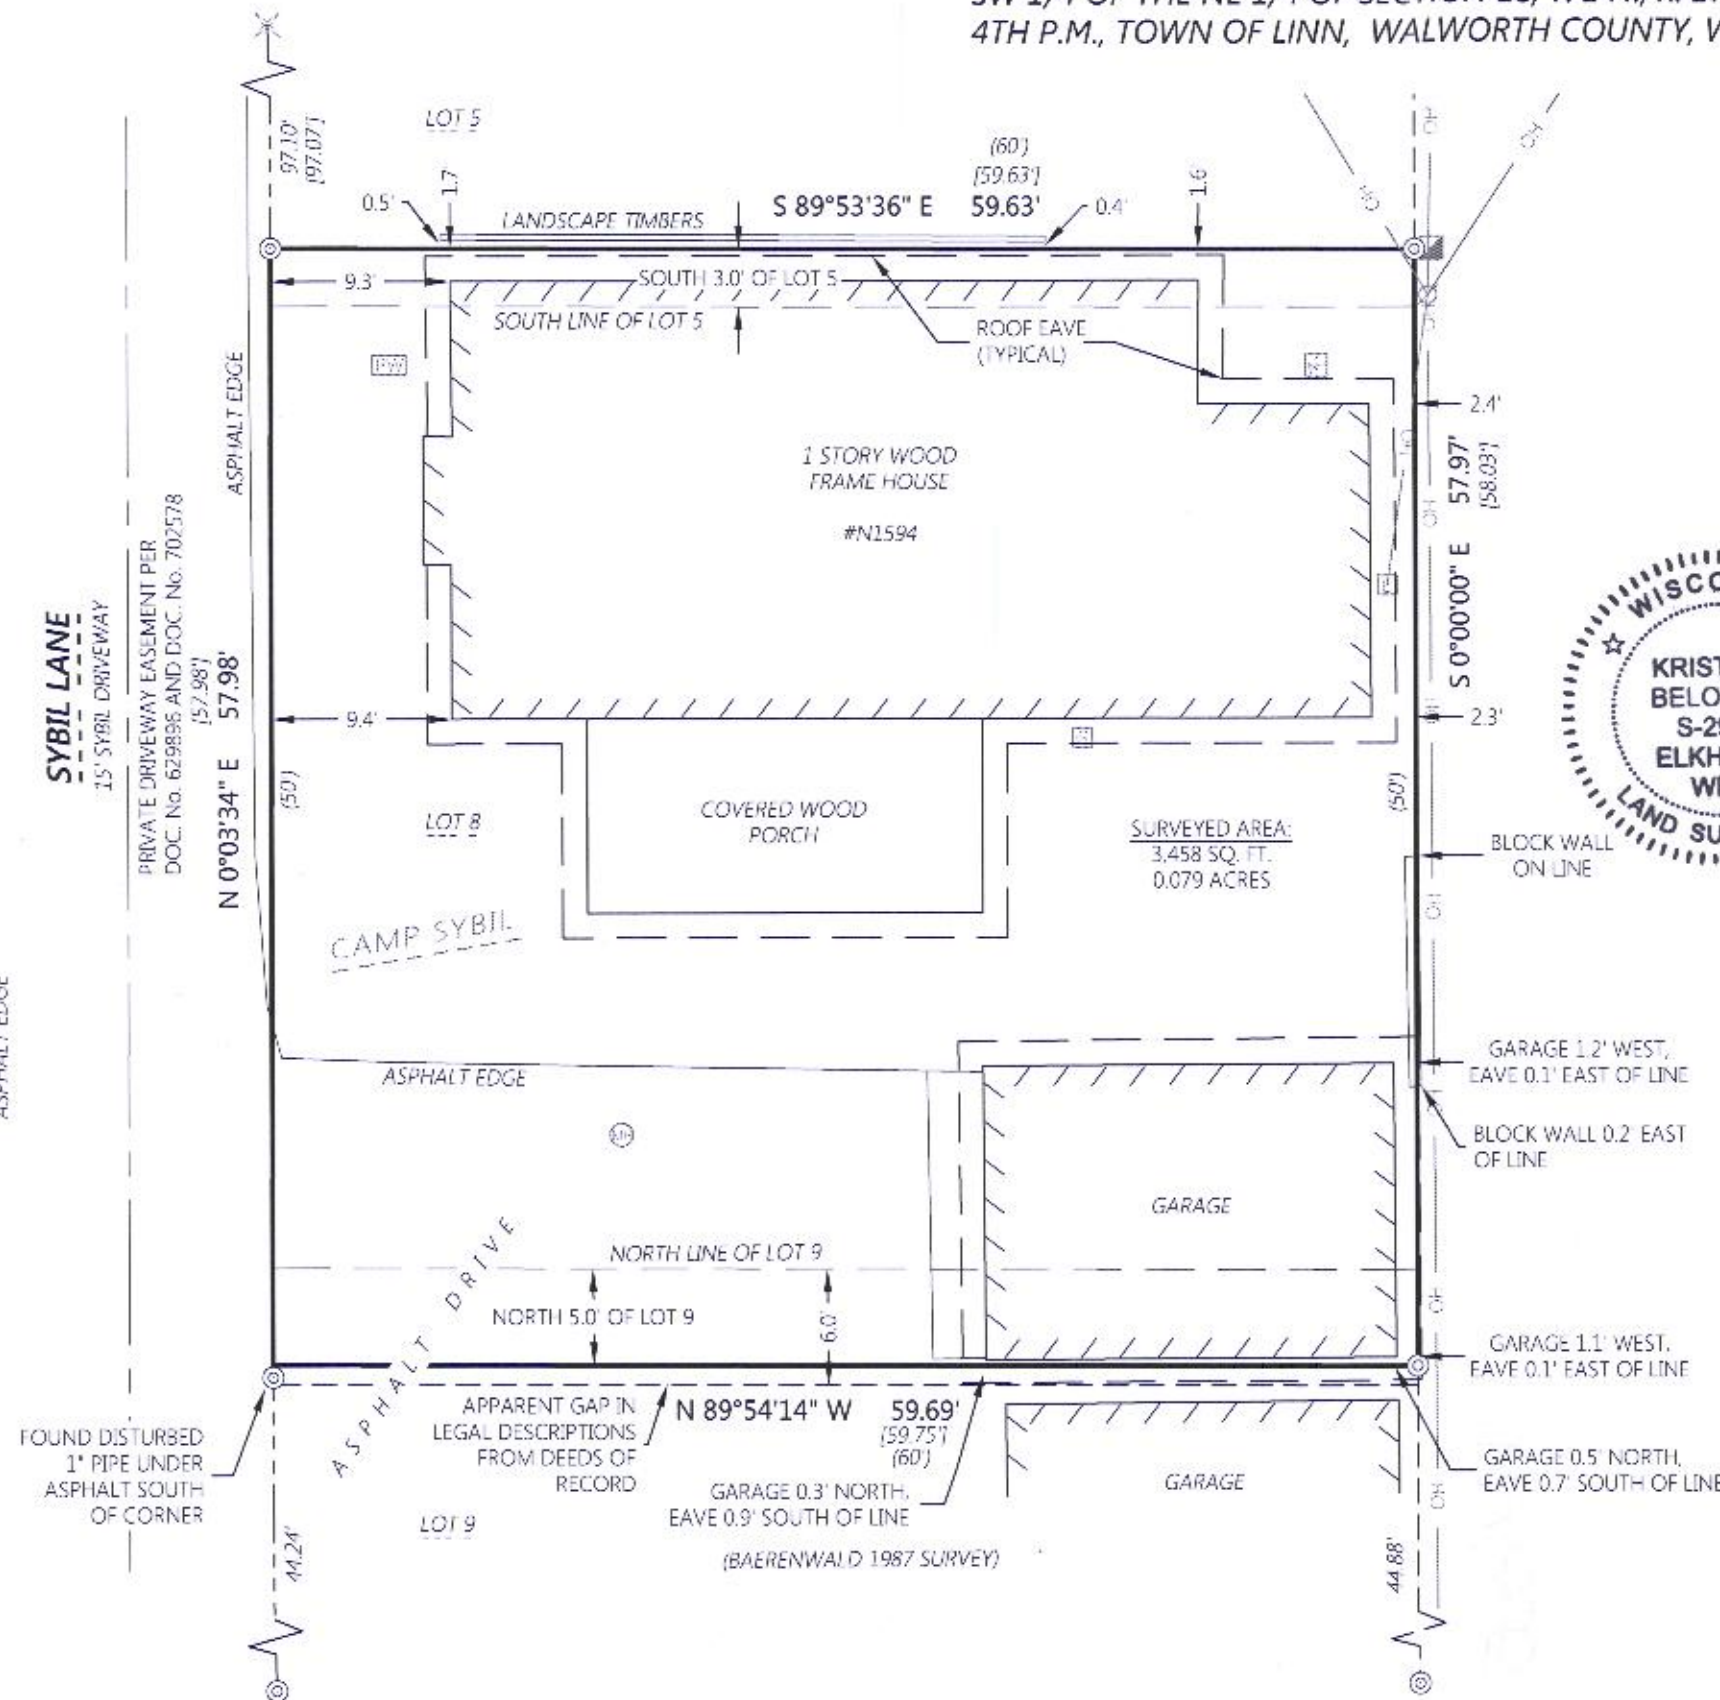

MONUMENT KEY

- ⊙ Iron Pipe Found
- ✕ Cut Cross
- (XXX.XX) Record Information
- (XXX.XX) Previously Surveyed by David F. Abell dated March 4, 2005

Scale: 1" = 10'

BEARINGS BASED ON THE EAST LINE OF LOT 8 WHICH IS ASSUMED TO BEAR S 0°00'00" E

LEGEND

- Existing Boundary Line
- - - Existing Right-of-Way
- - - Existing Adjacent Property
- - - Existing Centerline
- - - Existing Easement Line
- Existing Overhead Power
- ⊙ Existing Utility Pole
- ⊠ Existing Telephone Pedestal
- ⊠ Existing Electric Meter
- ⊠ Existing Air Conditioner
- ⊠ Existing Gas Meter
- ⊠ Existing Well
- ⊠ Existing Manhole

Kristin J. Belongia

Kristin J. Belongia, P.L.S.
Wisconsin Professional Land Surveyor S-2943

State of Wisconsin } ss
County of Rock

I hereby certify that I have supervised the survey of the property described above and to the best of my knowledge and belief, the plat drawn hereon complies with Chapter A-E 7 of the State of Wisconsin Administrative Code, Minimum Standards for Property Surveys and correctly represents the size and location of the property, exterior boundaries, the location of all visible structures, and dimensions of all principle buildings thereon, fences, easements of record, and roadways, if any. This survey is made for the use of the present owners of the property, and also those who purchase, mortgage, or guarantee the title thereto within one year from the date hereof.

Given under my hand and seal this 10th day of February, 2020 at Beloit, Wisconsin
Last day of field work February 3, 2020

If the surveyor's signature is not red in color, the plan is a copy that should be assumed to contain unauthorized alterations. The certification contained on this document shall not apply to any copies.



Batterman
engineers surveyors planners
2857 Batavia Drive
Beloit, Wisconsin 53511
608.365.4464
www.batterman.com

PLAT OF SURVEY

FOR THE EXCLUSIVE USE OF:
Kimberly M. McCarter
N1594 Sybil Lane
Fontana-On-Geneva Lake, WI 53125

ORDER NO: 33519
FIELD CREW: DJE
DRAWN BY: DJE